

HAROLD H. KOLB

REGISTERED PROFESSIONAL LAND SURVEYOR
LAKE GENEVA, WISCONSIN

PLAT OF SURVEY OF

Lot 4, Block 1, Forest Rest,
a subdivision located in
Section 2, T 1 N, R 17 E and
in Section 35, T 2 N, R 17 E,
Walworth County, Wisconsin.

NOTE: Iron pipe at A, B & C found Nov. 12, 1977.
Iron pipe at D missing.
All other iron pipe were found as shown.


N



SCALE 1" = 60'

LEGEND

- ⌵ - IRON PIPE FOUND
- - IRON PIPE PLACED
- - CONCRETE MONUMENT
- x - CROSS IN CONC. STEPS

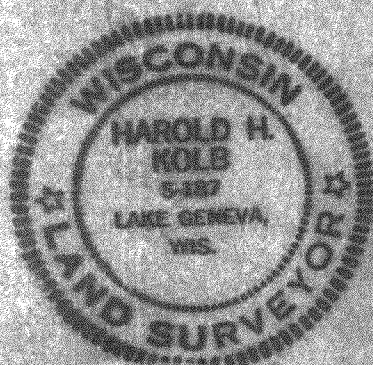


I, HAROLD H. KOLB, DO HEREBY CERTIFY THAT I HAVE
SURVEYED THE PROPERTY HEREON DESCRIBED ACCORDING
TO THE OFFICIAL RECORDS, AND THAT THE PLAT HEREON
IS A CORRECT REPRESENTATION OF THE LOT LINES.

Harold H. Kolb

HAROLD H. KOLB
WISCONSIN REGISTERED LAND SURVEYOR, 5-187
DATE, November 1, 1966

REVISED DATE: November 15, 1977.

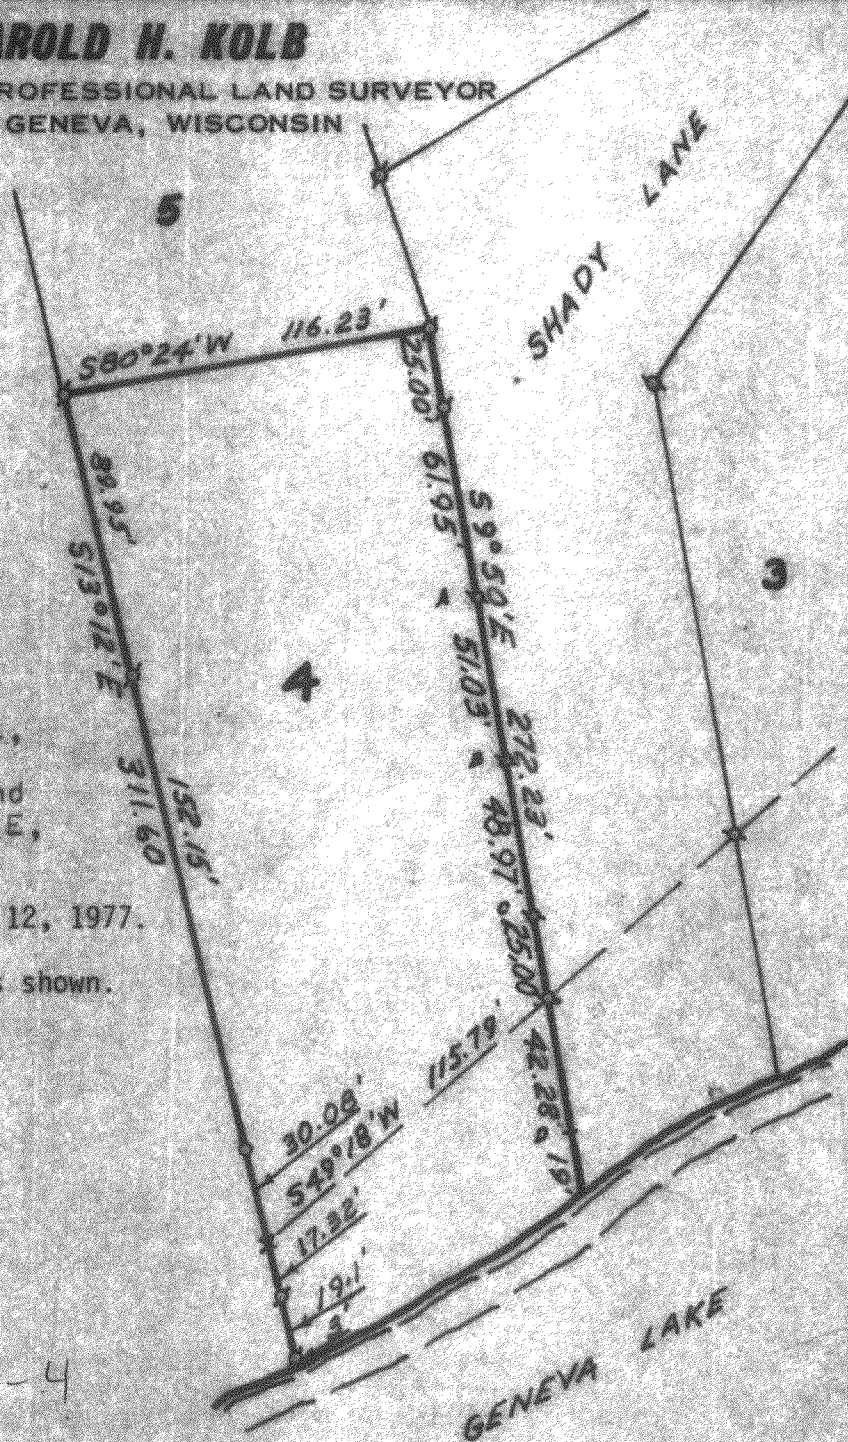

T-1N R17E 95