


KOLB LAND CONSULTING, INC.
LAND SURVEYING • SUBDIVIDING • LAND PLANNING

LAKE GENEVA, WISCONSIN 53147

WHITEWATER, WISCONSIN 53190

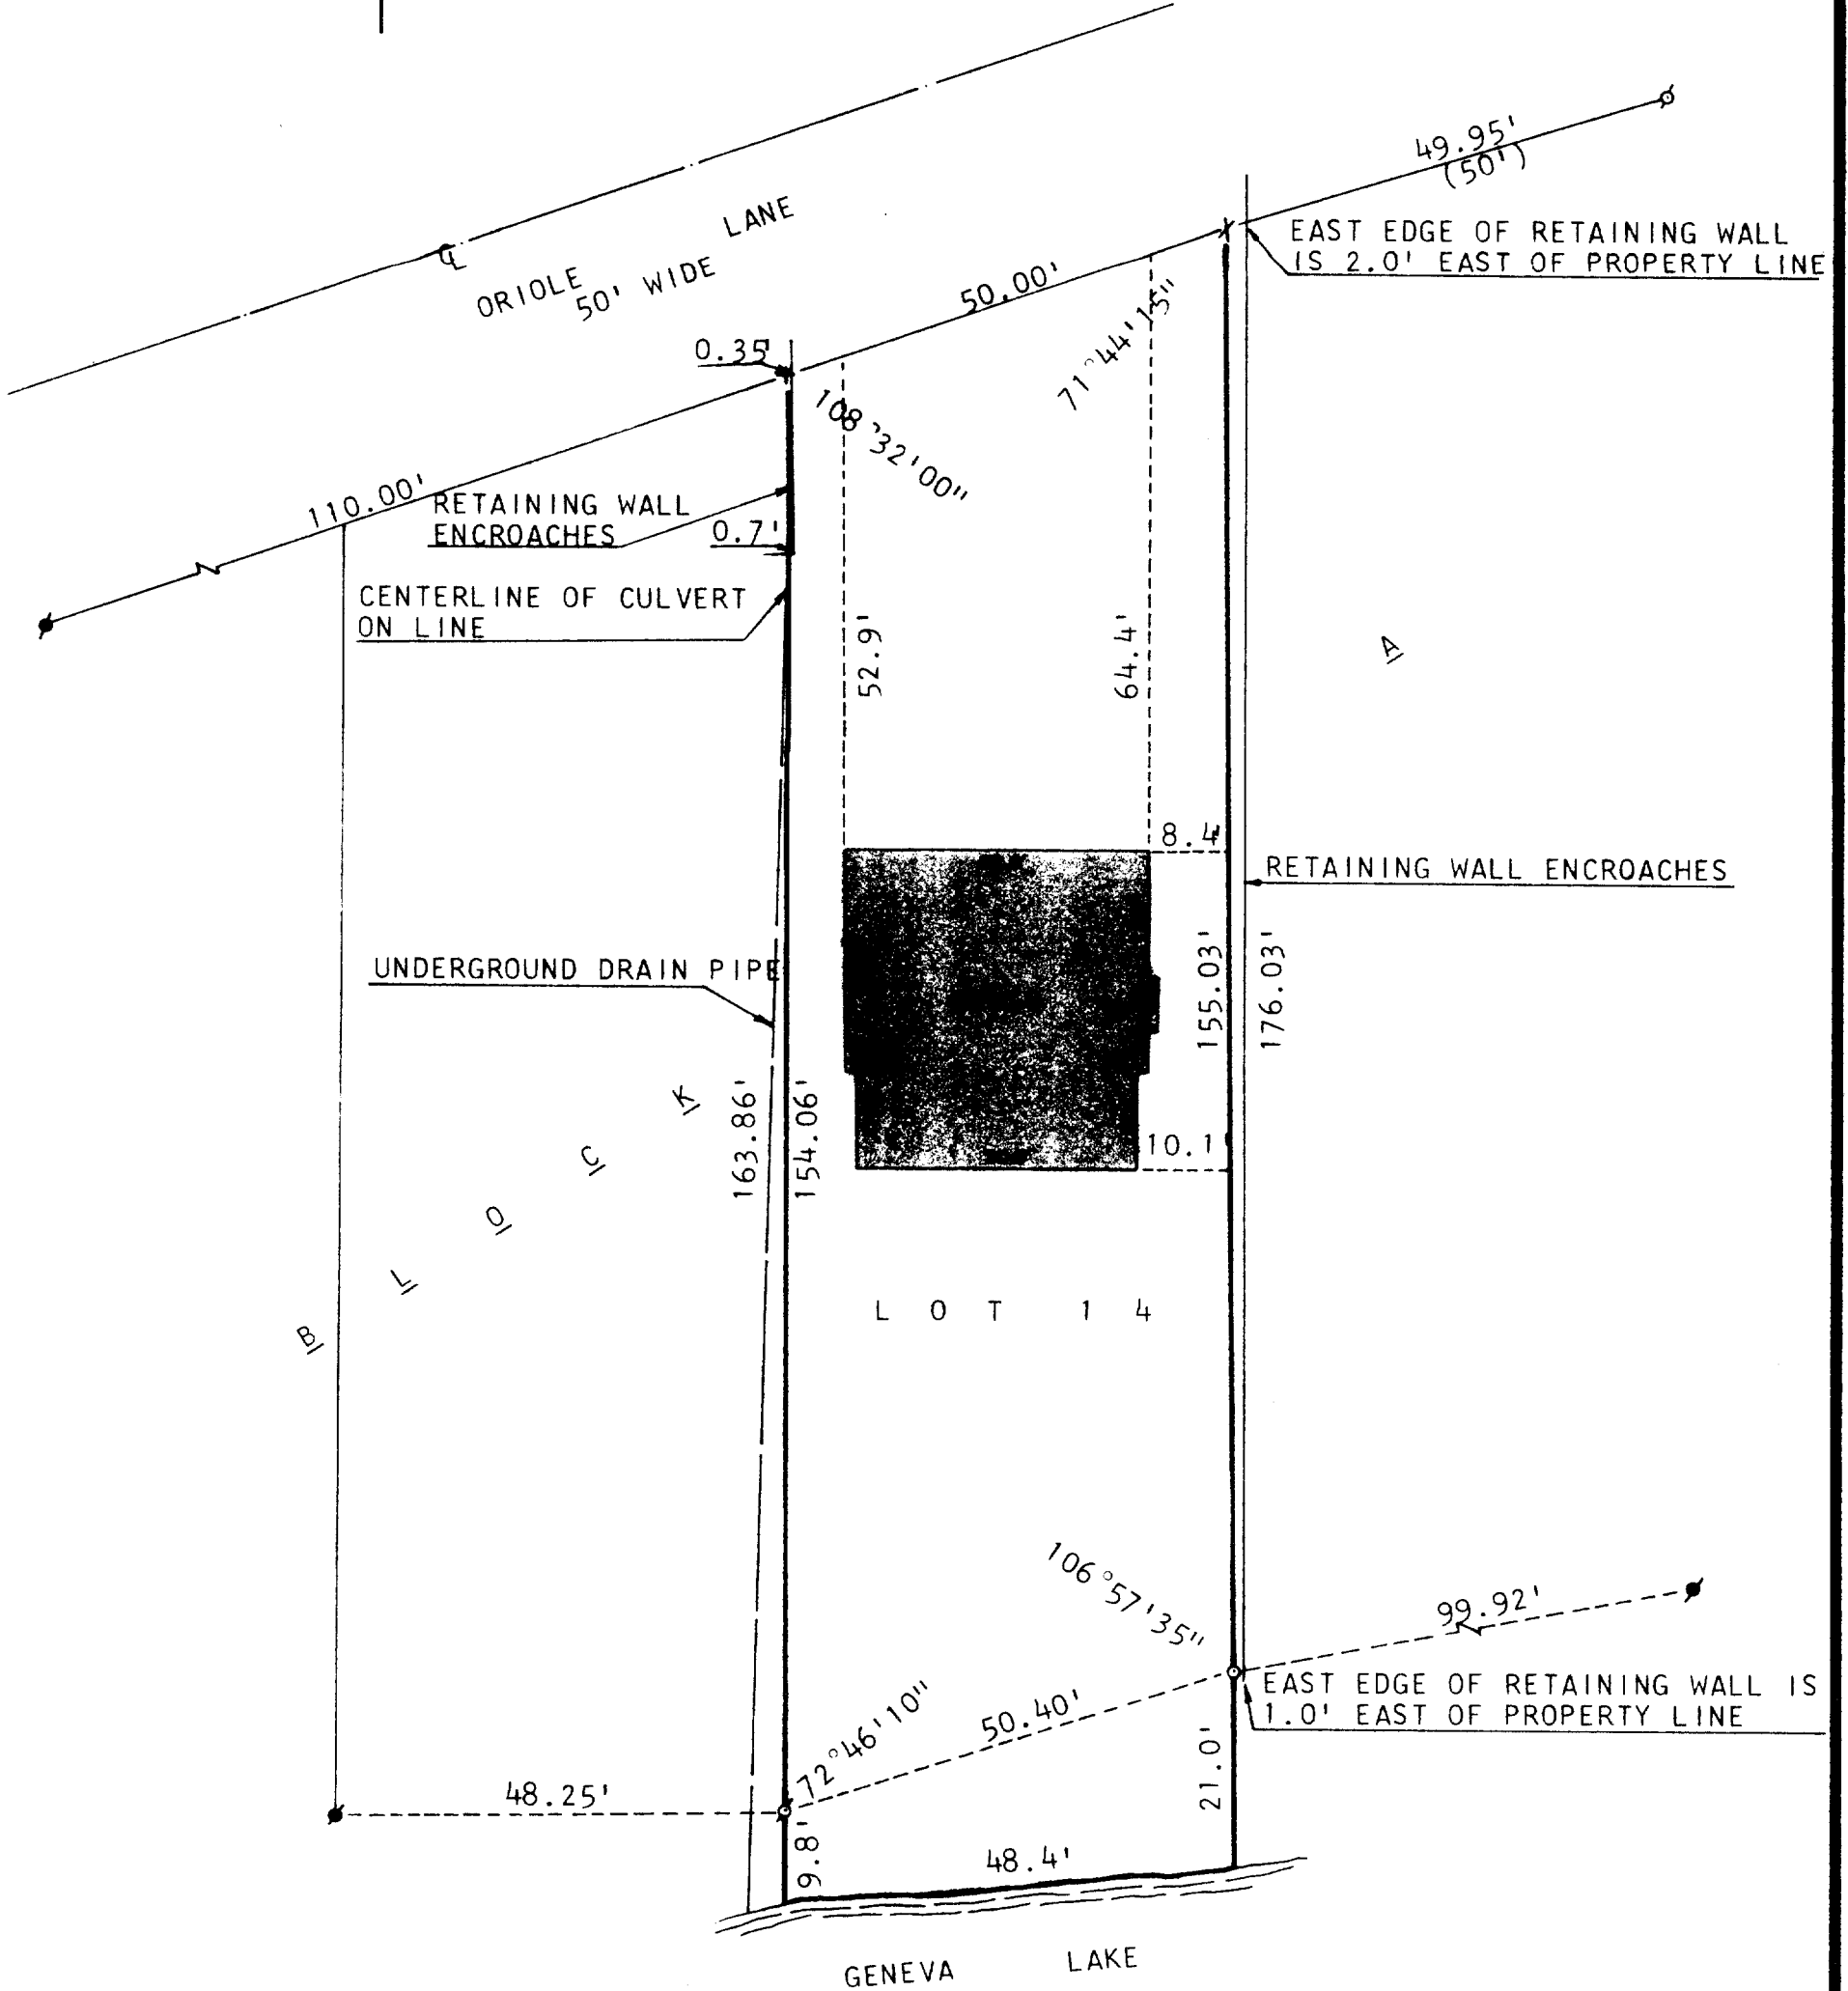

PLAT OF SURVEY OF

LOT 14, BLOCK A, CISCO BEACH SUBDIVISION, LOCATED IN SECTION 5,
T 1 N, R 17 E, WALWORTH COUNTY, WISCONSIN.

ORDERED BY: HOTTON REALTY
60 WEST GENEVA STREET
WILLIAMS BAY, WISCONSIN 53191



SCALE: 1"=20'

- ⊙-IRON PIPE FOUND
- IRON PIPE PLACED
- CONCRETE MONUMENT FOUND
- ✚-CUT CROSS IN CONCRETE
- X-RAILROAD SPIKE FOUND



I, HAROLD H. KOLB, DO HEREBY CERTIFY
THAT I HAVE SURVEYED THE PROPERTY
HEREON DESCRIBED ACCORDING TO THE
OFFICIAL RECORDS, AND THAT THE PLAT
HEREON IS A CORRECT REPRESENTATION
OF THE LOT LINES TO THE BEST OF MY
KNOWLEDGE AND BELIEF.

Harold H. Kolb
HAROLD H. KOLB
WISCONSIN REGISTERED LAND SURVEYOR, S-187
DATE *July 25, 1979*

117-591KV