
## HAROLD H. KOLB

REGISTERED PROFESSIONAL LAND SURVEYOR LAKE GENEVA, WISCONSIN

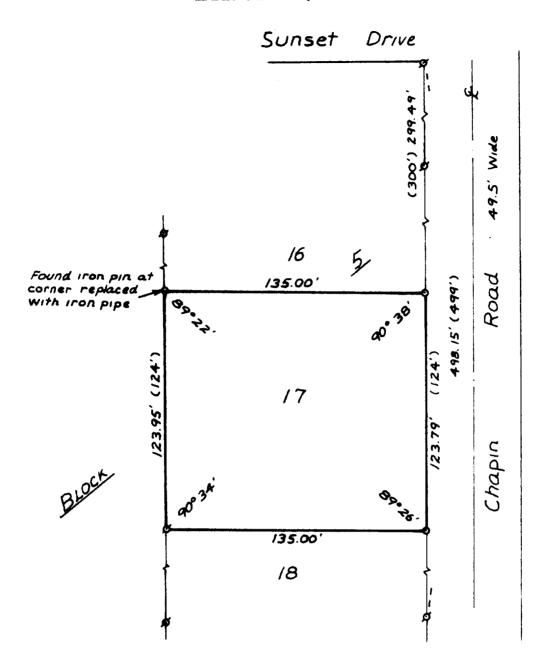

PLAT OF SURVEY OF

LOT 17, BLOCK 5, SUNSET HILLS SUBDIVISION, T 1 N, R 17 E, WALWORTH COUNTY, WISCONSIN.

OWNER: GEORGE PETERSON

ISH-7 Scale · /"=50"

I, HAROLD H. KOLB, DO HEREBY CERTIFY THAT I HAVE SURVEYED THE PROPERTY HEREON DESCRIBED ACCORDING TO THE OFFICIAL RECORDS, AND THAT THE PLAT HEREON IS A CORRECT REPRESENTATION OF THE LOT LINES.

WISCONSIN REGISTERED LAND SURVEYOR, S-187

- IRON PIPE PLACED, 1" x 24" 1.13 LB./LIN. FT.
- CONCRETE MONUMENT, 5" DIA. x 30"
- () AS PLATTED O - IRON PIPE FOUND

117-602