
KOLB LAND CONSULTING, INC.

LAND SURVEYING . SUBDIVIDING . LAND PLANNING

LAKE GENEVA, WISCONSIN 53147

WHITEWATER, WISCONSIN 53190

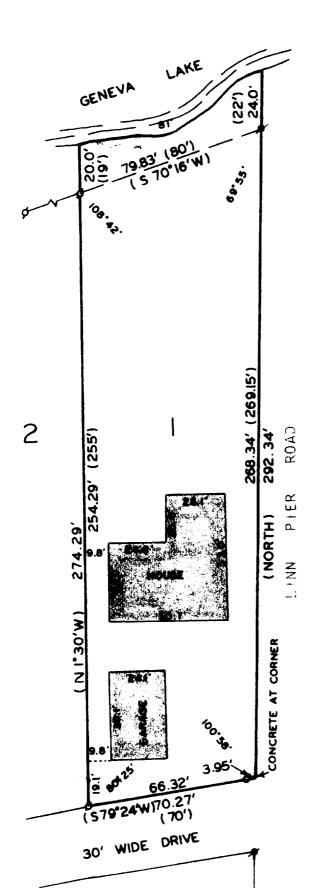

PLAT OF SURVEY OF

LOT 1, THE BIRCHES 1ST ADDITION, TOWN 1 NORTH, RANGE 17 EAST, WALWORTH COUNTY, WISCONSIN.

ORDERED BY: JOSEPH INGOLIA 18 N. EAST AVENUE PARK RIDGE, IL 60068



SCALE . 1"= 40"

o- IRON PIPE SET

Ø-IRON PIPE FOUND



I, HAROLD H. KOLB, DO HEREBY CERTIFY THAT I HAVE SURVEYED THE PROPERTY HEREON DESCRIBED ACCORDING TO THE OFFICIAL RECORDS, AND THAT THE PLAT HEREON IS A CORRECT REPRESENTATION OF THE LOT LINES TO KNOWLEDGE AND BELIEF.

KOLB REGISTERED LAND SURVEYOR, S-187

Nov. 20,1979 DATE .