

GENEVA
LAKE

PLAT OF SURVEY OF
LOT 17 OF LAKE GENEVA
HIGHLANDS LOCATED IN
SECTION 8, T1N R17E
WALWORTH COUNTY, WIS.

I CERTIFY THAT I HAVE
SURVEYED THE ABOVE
DESCRIBED LAND & THAT
THE PLAT SHOWN HEREON IS
AN ACCURATE SURVEY & A
TRUE REPRESENTATION
THEREOF & CORRECTLY
SHOWS THE BOUNDARY
LINES OF SAID
PROPERTY AND
ALL BUILDINGS
THEREON.

MAY 2, 1979


Thomas P. A. Jensen

JENSEN SURVEYING
&
MAPPING
ELKHORN, WISCONSIN

ASSUMED NORTH

1" = 20'

○ - IRON PIPE FOUND
● - CONC. MON. FOUND
SURVEYED FOR:
B.T. FREEMAN

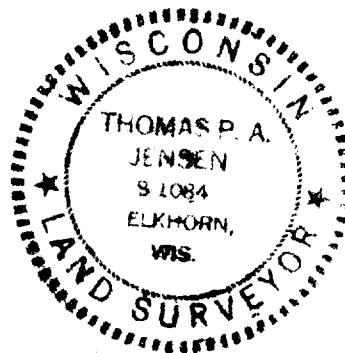

LAKEVIEW ROAD

HIGHLAND
ROAD

P.O. 1979.001

117-629