

KOLB LAND CONSULTING, INC.  
LAKE GENEVA, WISCONSIN 53147

LOT 25

61.95' (62')

96°45'00"

73.00

90°

25.00

$$\begin{array}{r} 223 \\ 19 \overline{) 4237} \\ \underline{38} \phantom{0} \\ 43 \phantom{0} \\ \underline{38} \phantom{0} \\ 50 \phantom{0} \\ \underline{47} \phantom{0} \\ 30 \phantom{0} \\ \underline{28} \phantom{0} \\ 20 \phantom{0} \\ \underline{19} \phantom{0} \\ 10 \phantom{0} \\ \underline{9} \phantom{0} \\ 10 \phantom{0} \\ \underline{9} \phantom{0} \\ 10 \phantom{0} \end{array}$$

223.2

13

LCT 5

PLAT OF SURVEY OF

LOT 4, BLOCK 13, WOODDALE SUBDIVISION,  
TOWN 1 NORTH, RANGE 17 EAST, WALWORTH  
COUNTY, WISCONSIN.

ORDERED BY: W. P. BRISTOW  
VILLAGE TRAVEL CENTER, INC.  
9 NORTH 3RD STREET  
GENEVA, IL 60134

LJT 3

LGT 4

Brook Road North


Spring

Attn: Finance

The figure consists of two line graphs side-by-side. Both graphs have 'Rate of reaction' on the y-axis and 'Temperature' on the x-axis. The left graph shows a curve that starts at a low rate at low temperature and rises very steeply as temperature increases, indicating a high activation energy. The right graph shows a similar curve but with a much more gradual slope, indicating a lower activation energy.

117-642K

KOLB LAND CONSULTING, INC.  
LAKE GENEVA, WISCONSIN 53147

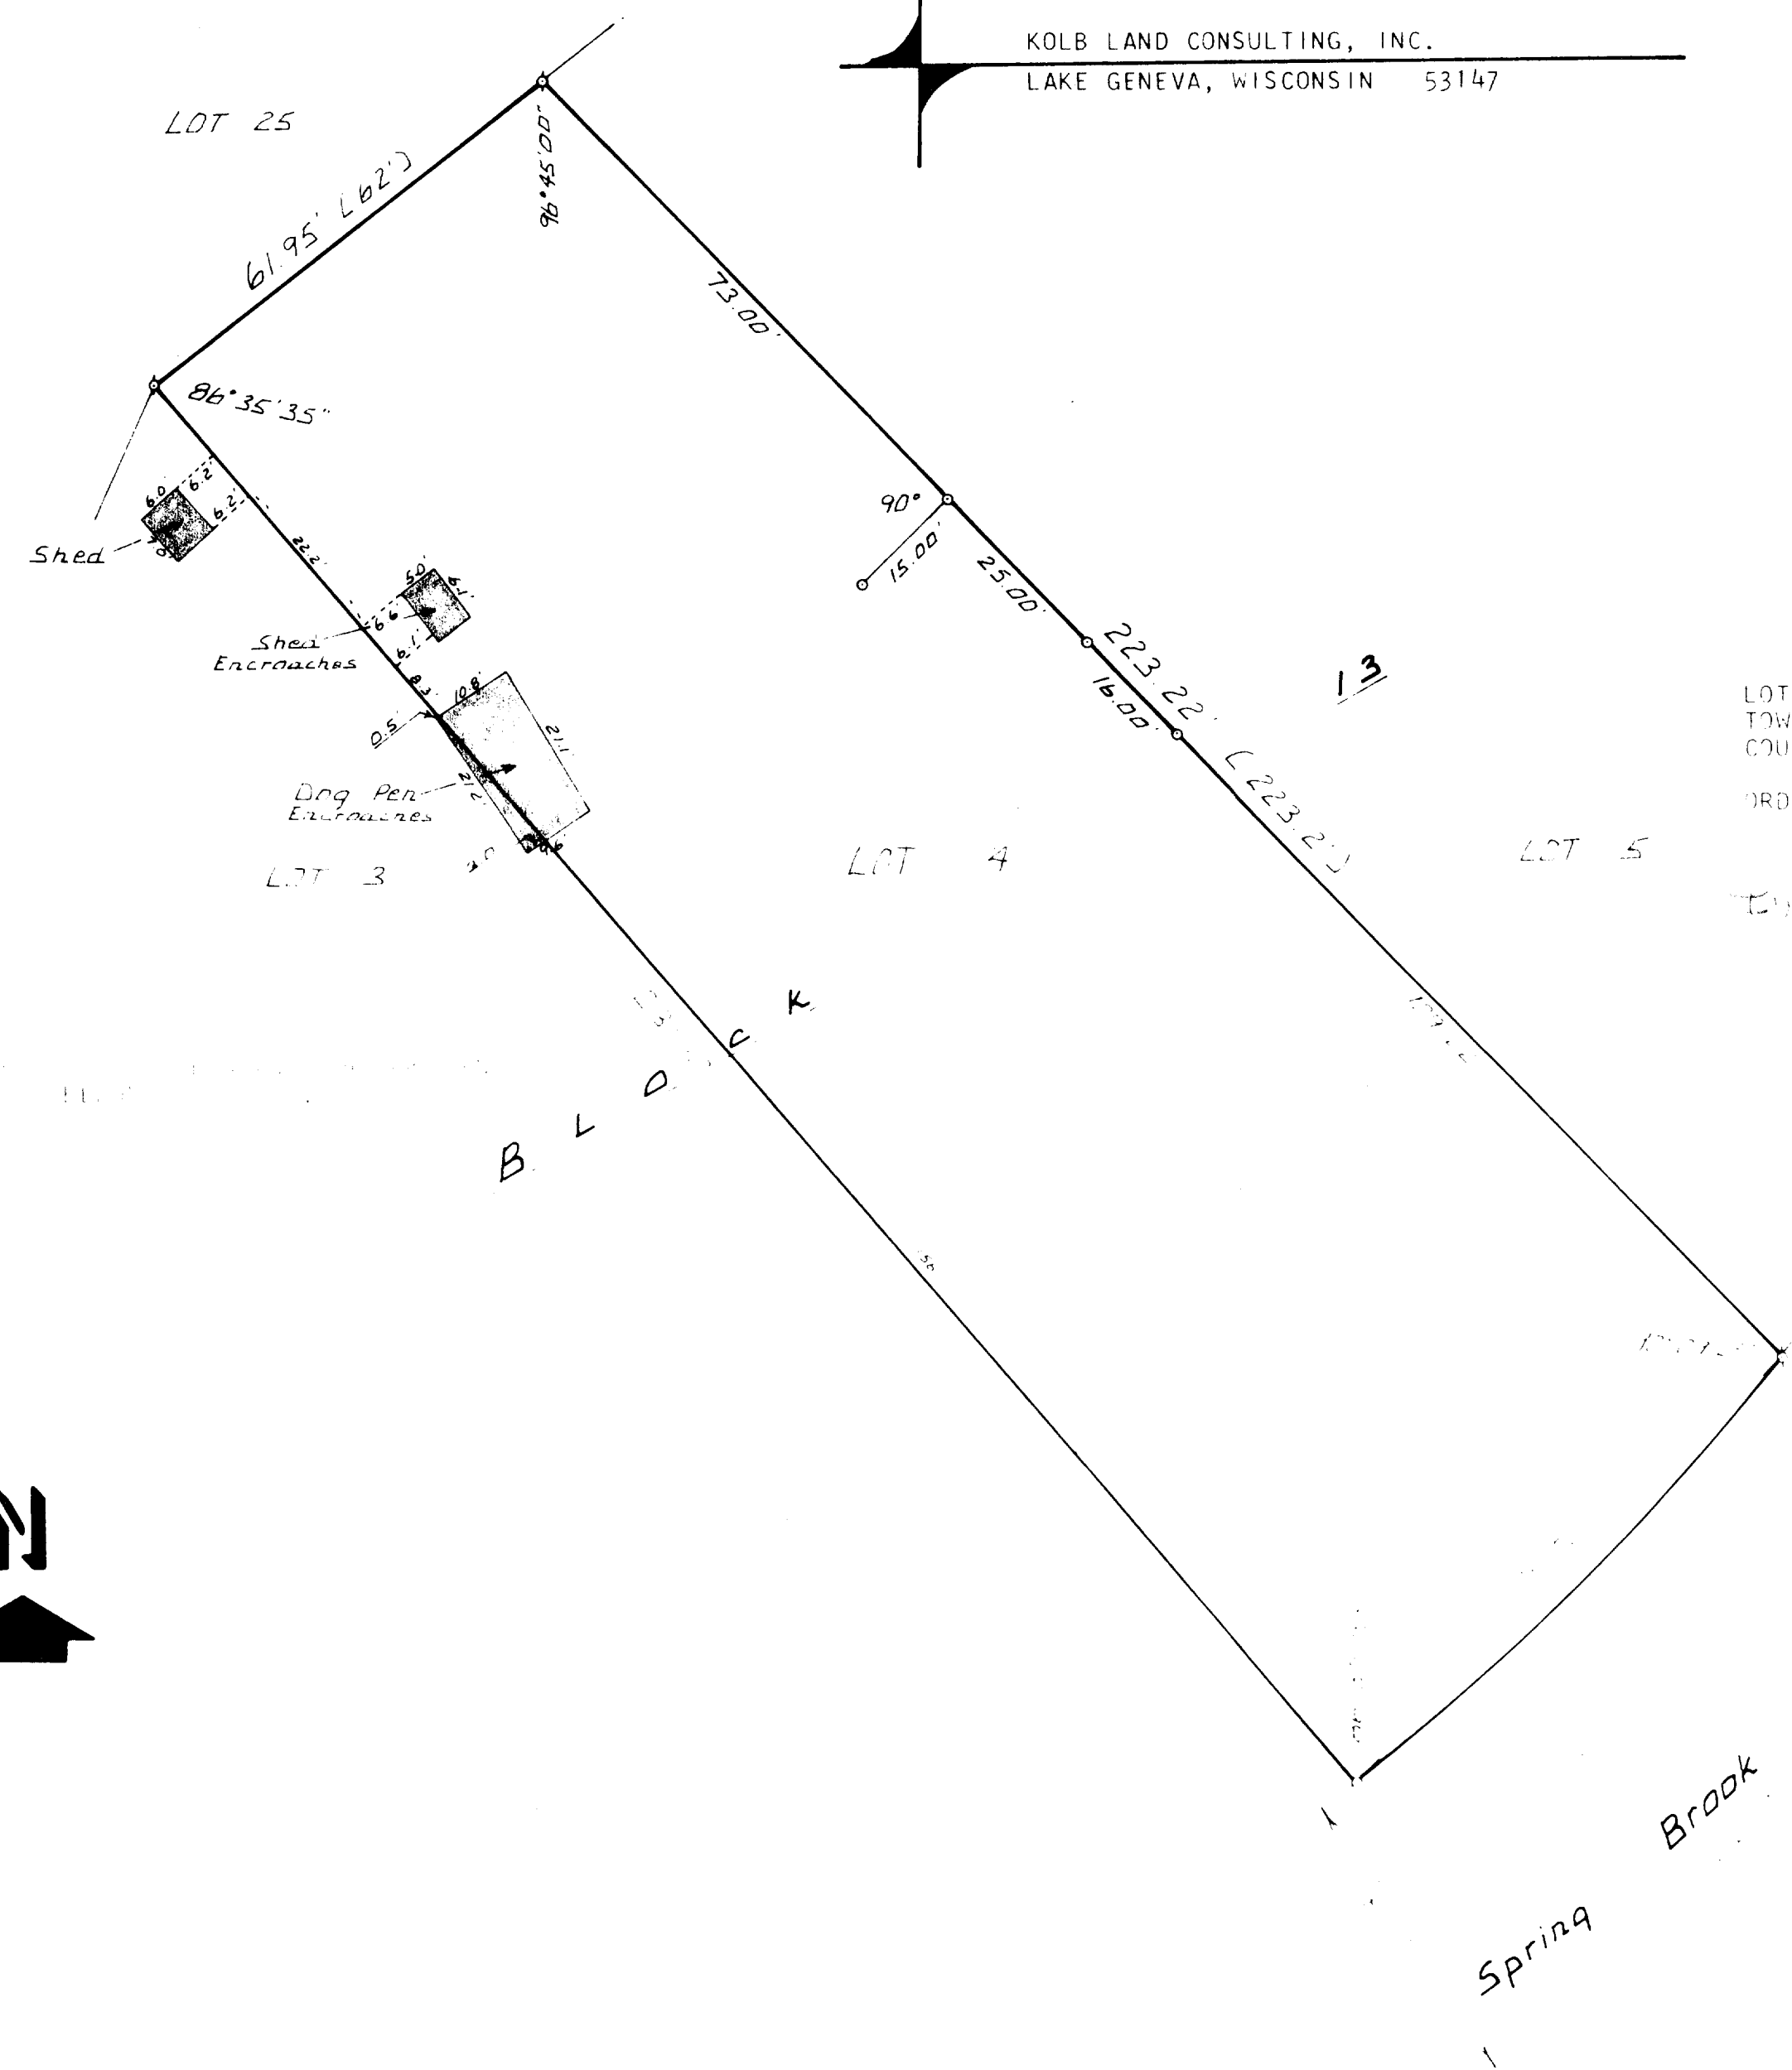

PLAT OF SURVEY OF  
LOT 4, BLOCK 13, WOODDALE SUBDIVISION,  
TOWN 1 NORTH, RANGE 17 EAST, WALWORTH  
COUNTY, WISCONSIN.  
ORDERED BY: W. P. BRISTOL  
VILLAGE TRAVEL CENTER, INC.  
9 NORTH 2ND STREET  
GENEVA, WI 53147

