


KOLB LAND CONSULTING, INC.
LAND SURVEYING • SUBDIVIDING • LAND PLANNING

LAKE GENEVA, WISCONSIN 53147

WHITEWATER, WISCONSIN 53190

LOURET AVENUE 50' WIDE

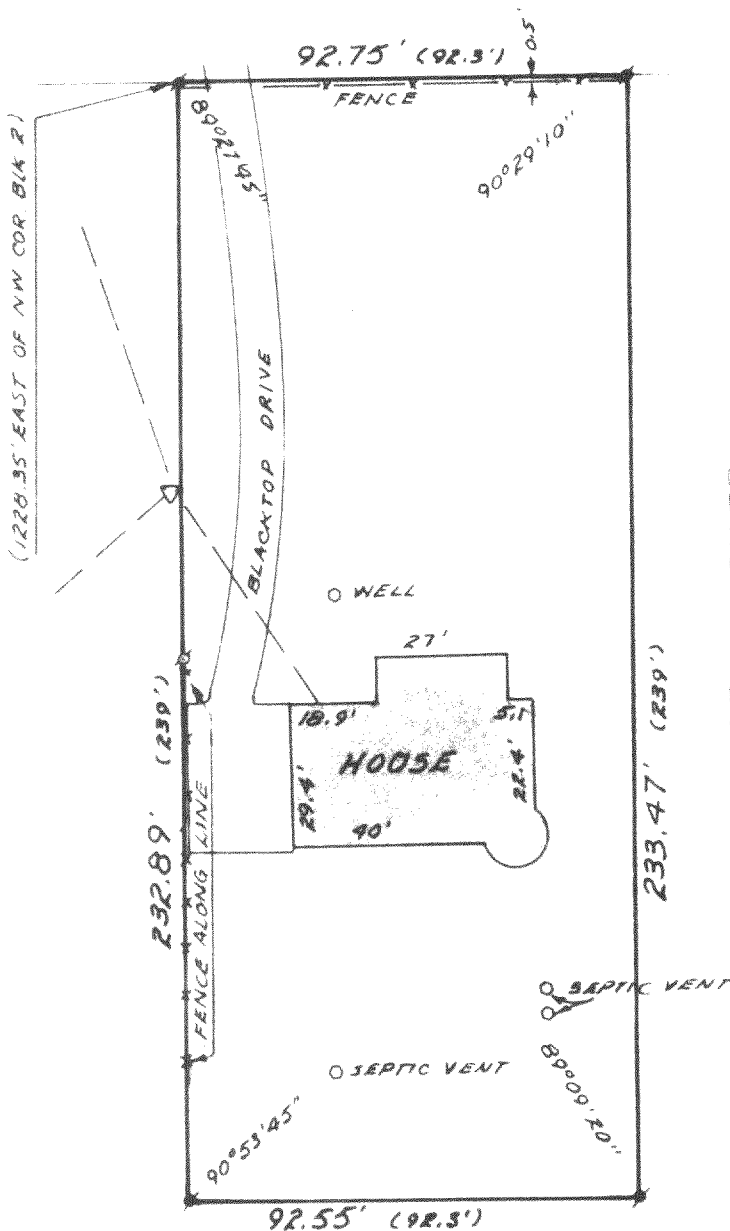

SCALE: 1" = 40'

LEGEND
CONC. MONUMENT FOUND
(9') AS RECORDED

ORDERED BY:
FIRST STATE SAVINGS OF WISCONSIN
23 SOUTH WASHINGTON
ELKHORN, WI. 53121

PLAT OF SURVEY OF
PART OF BLOCK 2, ROWENA PARK, A
SUBDIVISION LOCATED IN SECTION 5,
T 1 N, R 17 E, TOWN OF LINN, WALWORTH
COUNTY, WISCONSIN.
TAX KEY NO. IRP-22

I HEREBY CERTIFY THAT I HAVE SURVEYED THE
ABOVE DESCRIBED PROPERTY AND THAT THE ABOVE
MAP IS A TRUE REPRESENTATION THEREOF AND
SHOWS THE SIZE AND LOCATION OF THE PROPERTY,
ITS EXTERIOR BOUNDARIES, THE LOCATION OF ALL
VISIBLE STRUCTURES AND DIMENSIONS OF ALL
PRINCIPAL BUILDINGS THEREON, BOUNDARY FENCES,
APPARENT EASEMENTS, ROADWAYS AND VISIBLE
ENCROACHMENTS, IF ANY.

THIS SURVEY IS MADE FOR THE USE OF THE
PRESENT OWNERS OF THE PROPERTY, AND ALSO
THOSE WHO PURCHASE, MORTGAGE, OR GUARANTEE
THE TITLE THERETO WITHIN ONE (1) YEAR FROM
THE DATE HEREOF.

Harold H. Kolb

HAROLD H. KOLB
WISCONSIN REGISTERED LAND SURVEYOR, S-187
DATE JUNE 21, 1984

117-666

IRP-22