

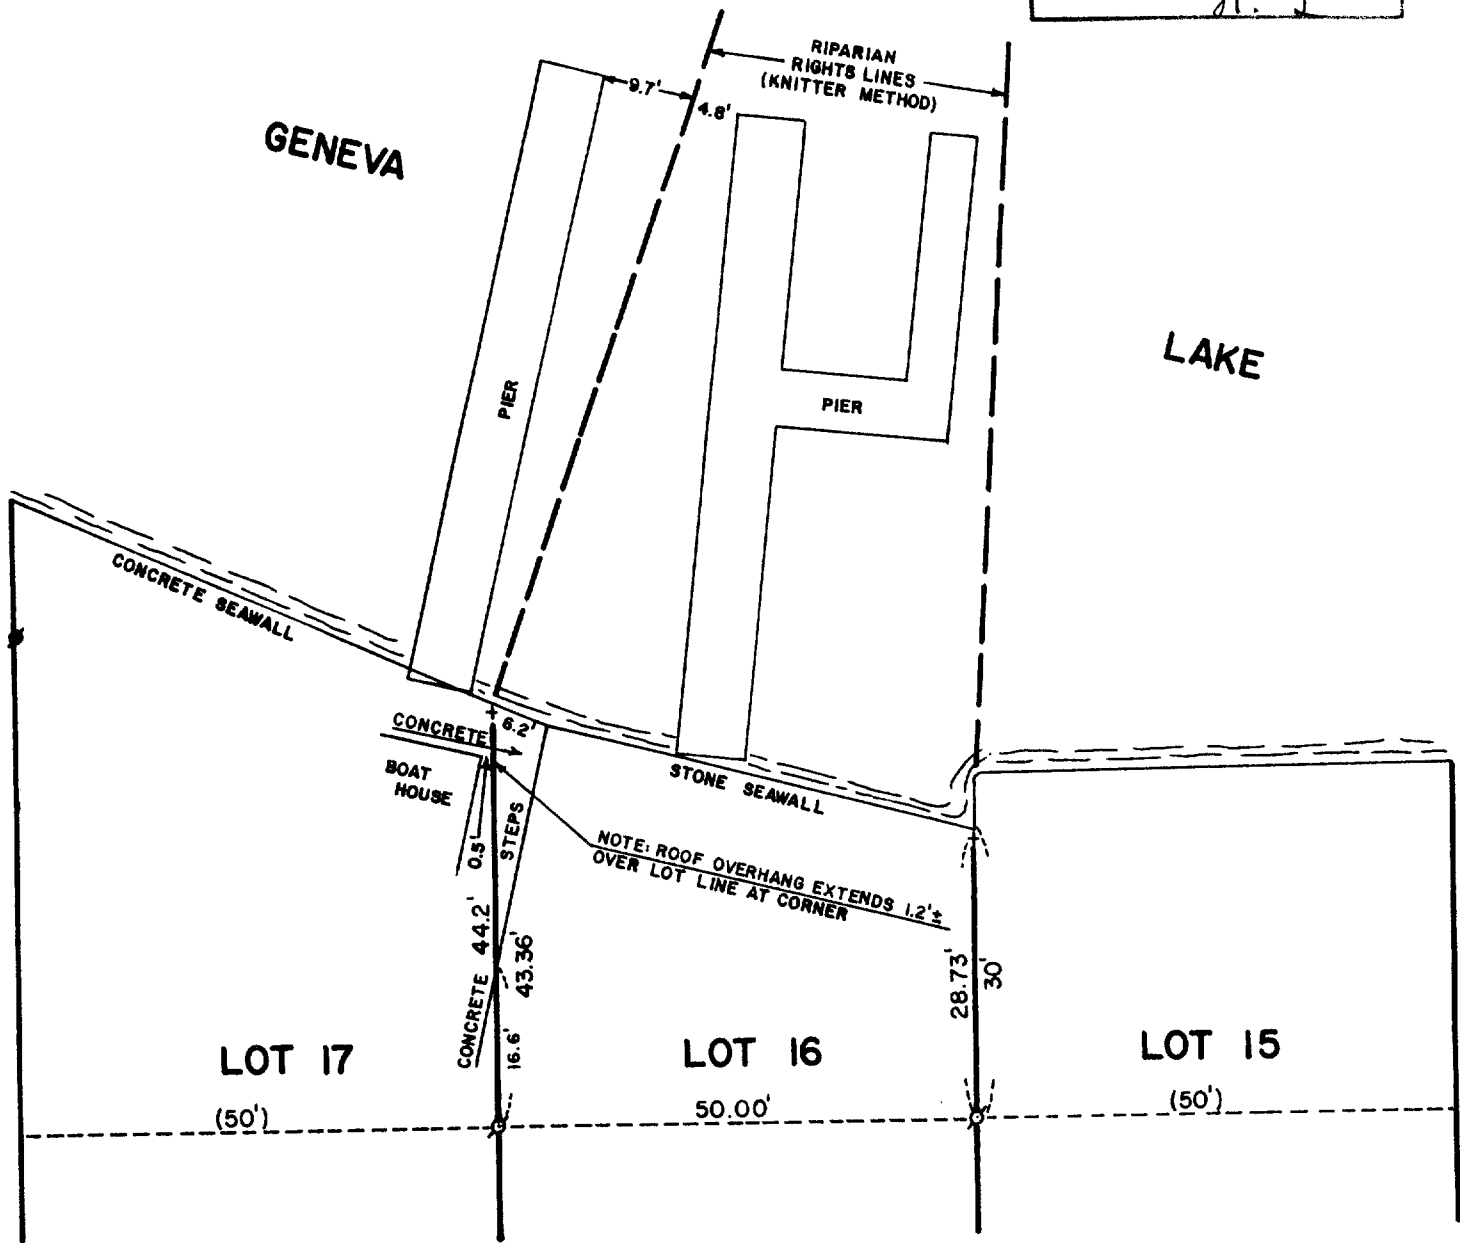


WALWORTH COUNTY
SURVEYING & MAPPING
LAKE GENEVA, WISCONSIN

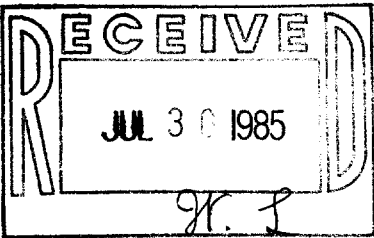

PLAT OF SURVEY OF

THE RIPARIAN RIGHTS OF LOT 16 OF LAKE GENEVA
HIGHLANDS, LOCATED IN SECTION 8, T 1 N, R 17 E,
WALWORTH COUNTY, WISCONSIN.

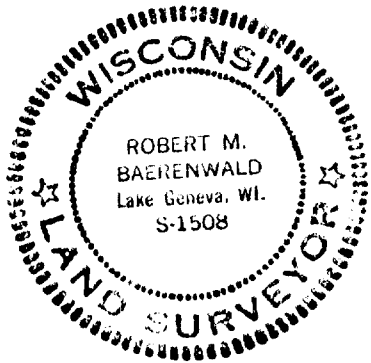

ORDERED BY: BILL TERRIS
1603 FERNDALE
NORTHBROOK, ILLINOIS 60062

I, ROBERT M. BAERENWALD, DO HEREBY CERTIFY THAT I
HAVE SURVEYED THE PROPERTY HEREON DESCRIBED ACCORDING
TO THE OFFICIAL RECORDS AND THAT THE PLAT HEREON IS A
CORRECT REPRESENTATION OF THE PROPERTY LINES TO THE
BEST OF MY KNOWLEDGE AND BELIEF.

Robert M. Baerenwald
ROBERT M. BAERENWALD
WISCONSIN REGISTERED LAND SURVEYOR, S-1508

Nov. 5, 1984
DATE JOB NO. 0061-1



SCALE: 1"=20'

- o - IRON PIPE FOUND
- - CONCRETE MONUMENT FOUND
- + - CUT CROSS IN CONCRETE
- () - RECORDED AS

117-670-B