


KOLB LAND CONSULTING, INC.
LAND SURVEYING • SUBDIVIDING • LAND PLANNING

LAKE GENEVA, WISCONSIN 53147

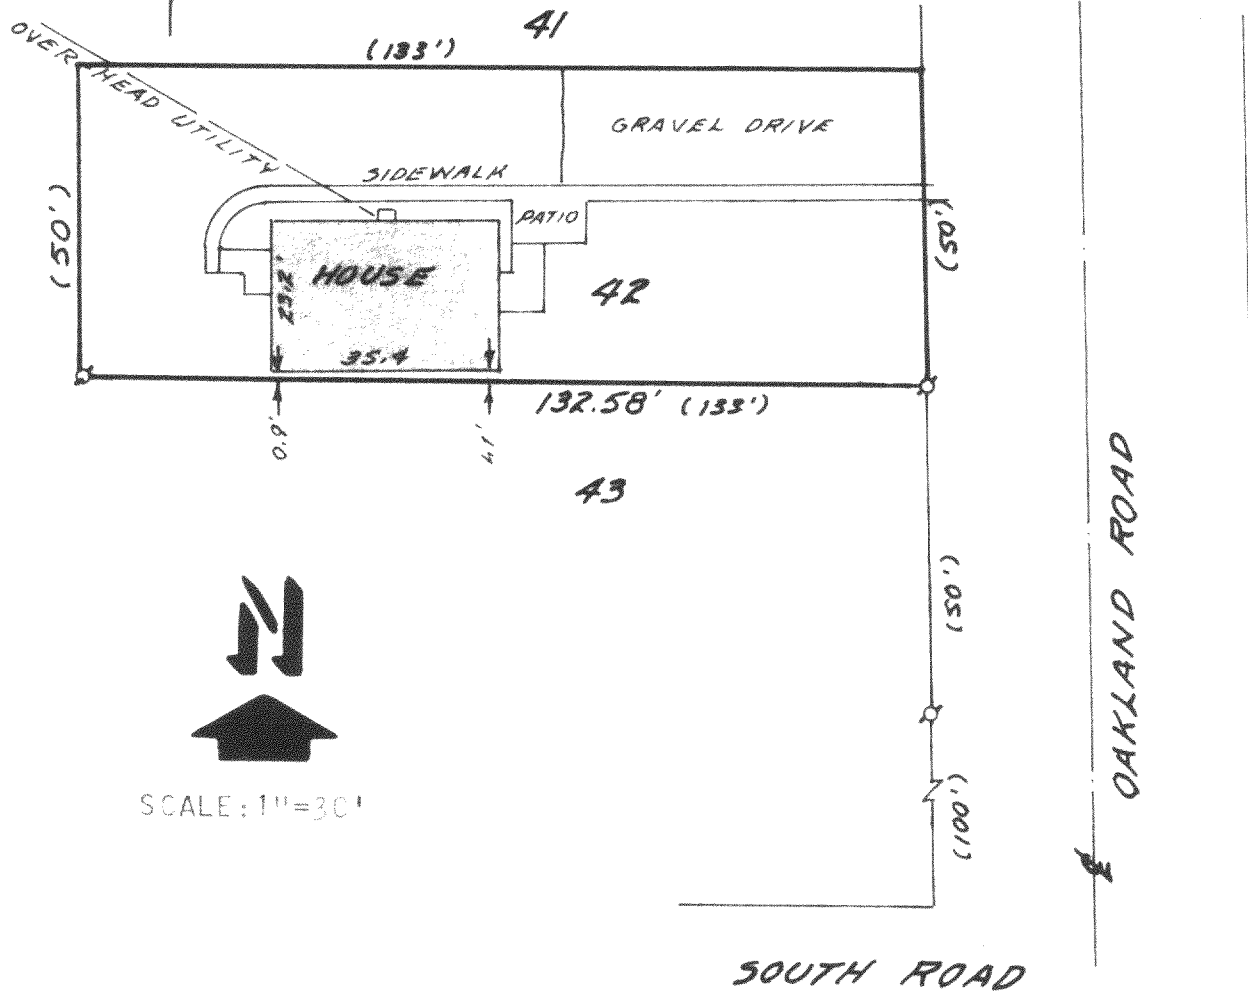

MORTGAGE INSPECTION OF

LOT 42, LAKE GENEVA HIGHLANDS, A SUBDIVISION
LOCATED IN THE SOUTHEAST 1/4 OF SECTION 8,
T 1 N, R 17 E, TOWN OF LINN, WALWORTH COUNTY,
WISCONSIN.

ORDERED BY: ANCHOR SAVINGS & LOAN ASSOCIATION
500 EAST WALWORTH
DELAWARE, WI. 53115

BUYER: WILLIAM HAMMERBERG

COMPLIANCE WITH A-E 3, 5(F), 6(A), (B), (C),
(D) AND 7 HAS BEEN WAIVED BY THE CLIENT, IN A
AGREEMENT WITH THE SURVEYOR, AS PERMITTED IN
A-E 5.01(B).

TAX PARCEL: ILGH-41

LEGEND
Ø IRON PIPE FOUND

Harold H. Kolb

HAROLD H. KOLB
WISCONSIN REGISTERED LAND SURVEYOR, S-187
DATE AUG. 15, 1984

117-679

1-17-1264-41