


WALWORTH COUNTY
SURVEYING & MAPPING
LAKE GENEVA, WISCONSIN

12

(N89°05'W 281.97')
281.78'

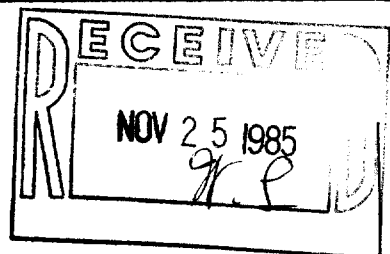

WILLOW DRIVE
(N5°52'W 224.74')
224.64'


PRIVATE PARK
(N0°25'E 220.70')
220.70'

PRIVATE PARK

11

PLAT OF SURVEY OF

LOT 11-A OF TRINKE ESTATES, A SUB-
DIVISION LOCATED IN SECTION 10, T 1 N,
R 17 E, WALWORTH COUNTY, WISCONSIN.

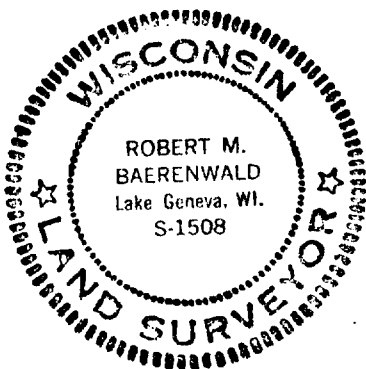

ORDERED BY: ALBERTA MOLT
1430 DEERPATH LANE
LAGRANGE, ILLINOIS 60525



SCALE: 1"=50'

⊙ - IRON PIPE FOUND
○ - IRON ROD SET
() - RECORDED AS

I, ROBERT M. BAERENWALD, DO HEREBY CERTIFY THAT I
HAVE SURVEYED THE PROPERTY HEREON DESCRIBED ACCORDING
TO THE OFFICIAL RECORDS AND THAT THE PLAT HEREON IS A
CORRECT REPRESENTATION OF THE PROPERTY LINES TO THE
BEST OF MY KNOWLEDGE AND BELIEF.

Robert M. Baerenwald

ROBERT M. BAERENWALD
WISCONSIN REGISTERED LAND SURVEYOR, S-1508

Nov 1, 1985
DATE

JOB NO. 0383

117-700-B