

OWNER: ROBERTA P. CLARK  
ORDERED BY: THE RAULAND AGENCY  
607 E. WALWORTH  
DELAVER, WI 53115


PLAT OF SURVEY OF

PART OF LOTS 14 AND 15, BLOCK 2 OF WOODDALE ADDITION,  
LOCATED IN SECTION 9, TOWN 1 NORTH, RANGE 17 EAST,  
WALWORTH COUNTY, WISCONSIN AS DESCRIBED IN VOLUME 58,  
PAGE 422 OF RECORDS, WALWORTH COUNTY, WISCONSIN.



SCALE - 1"=20'  
LEGEND

∘ - IRON PIPE FOUND  
( ) - RECORDED AS

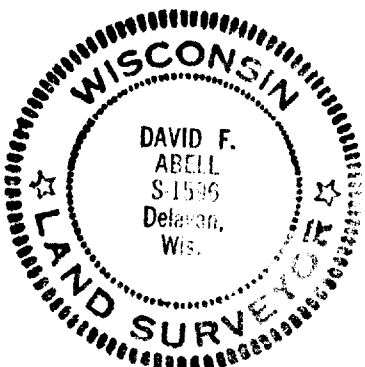

I HEREBY CERTIFY THAT I HAVE SURVEYED THE  
ABOVE DESCRIBED PROPERTY AND THAT THE ABOVE  
MAP IS A TRUE REPRESENTATION THEREOF AND  
SHOWS THE SIZE AND LOCATION OF THE PROPERTY,  
ITS EXTERIOR BOUNDARIES, THE LOCATION OF ALL  
PRINCIPAL BUILDINGS THEREON, BOUNDARY FENCES,  
APPARENT EASEMENTS, ROADWAYS, AND VISIBLE  
ENCROACHMENTS, IF ANY, TO THE BEST OF MY  
KNOWLEDGE AND BELIEF.

THIS SURVEY IS MADE FOR THE USE OF THE  
PRESENT OWNERS OF THE PROPERTY, AND ALSO  
THOSE WHO PURCHASE, MORTGAGE, OR GUARANTEE  
THE TITLE THERETO WITHIN ONE (1) YEAR FROM  
DATE HEREOF.

*David F. Abell*  
DAVID F. ABELL  
WISCONSIN REGISTERED LAND SURVEYOR, S-1596

DATE *March 6, 1986* JOB NUMBER - 0386001

117-701A