

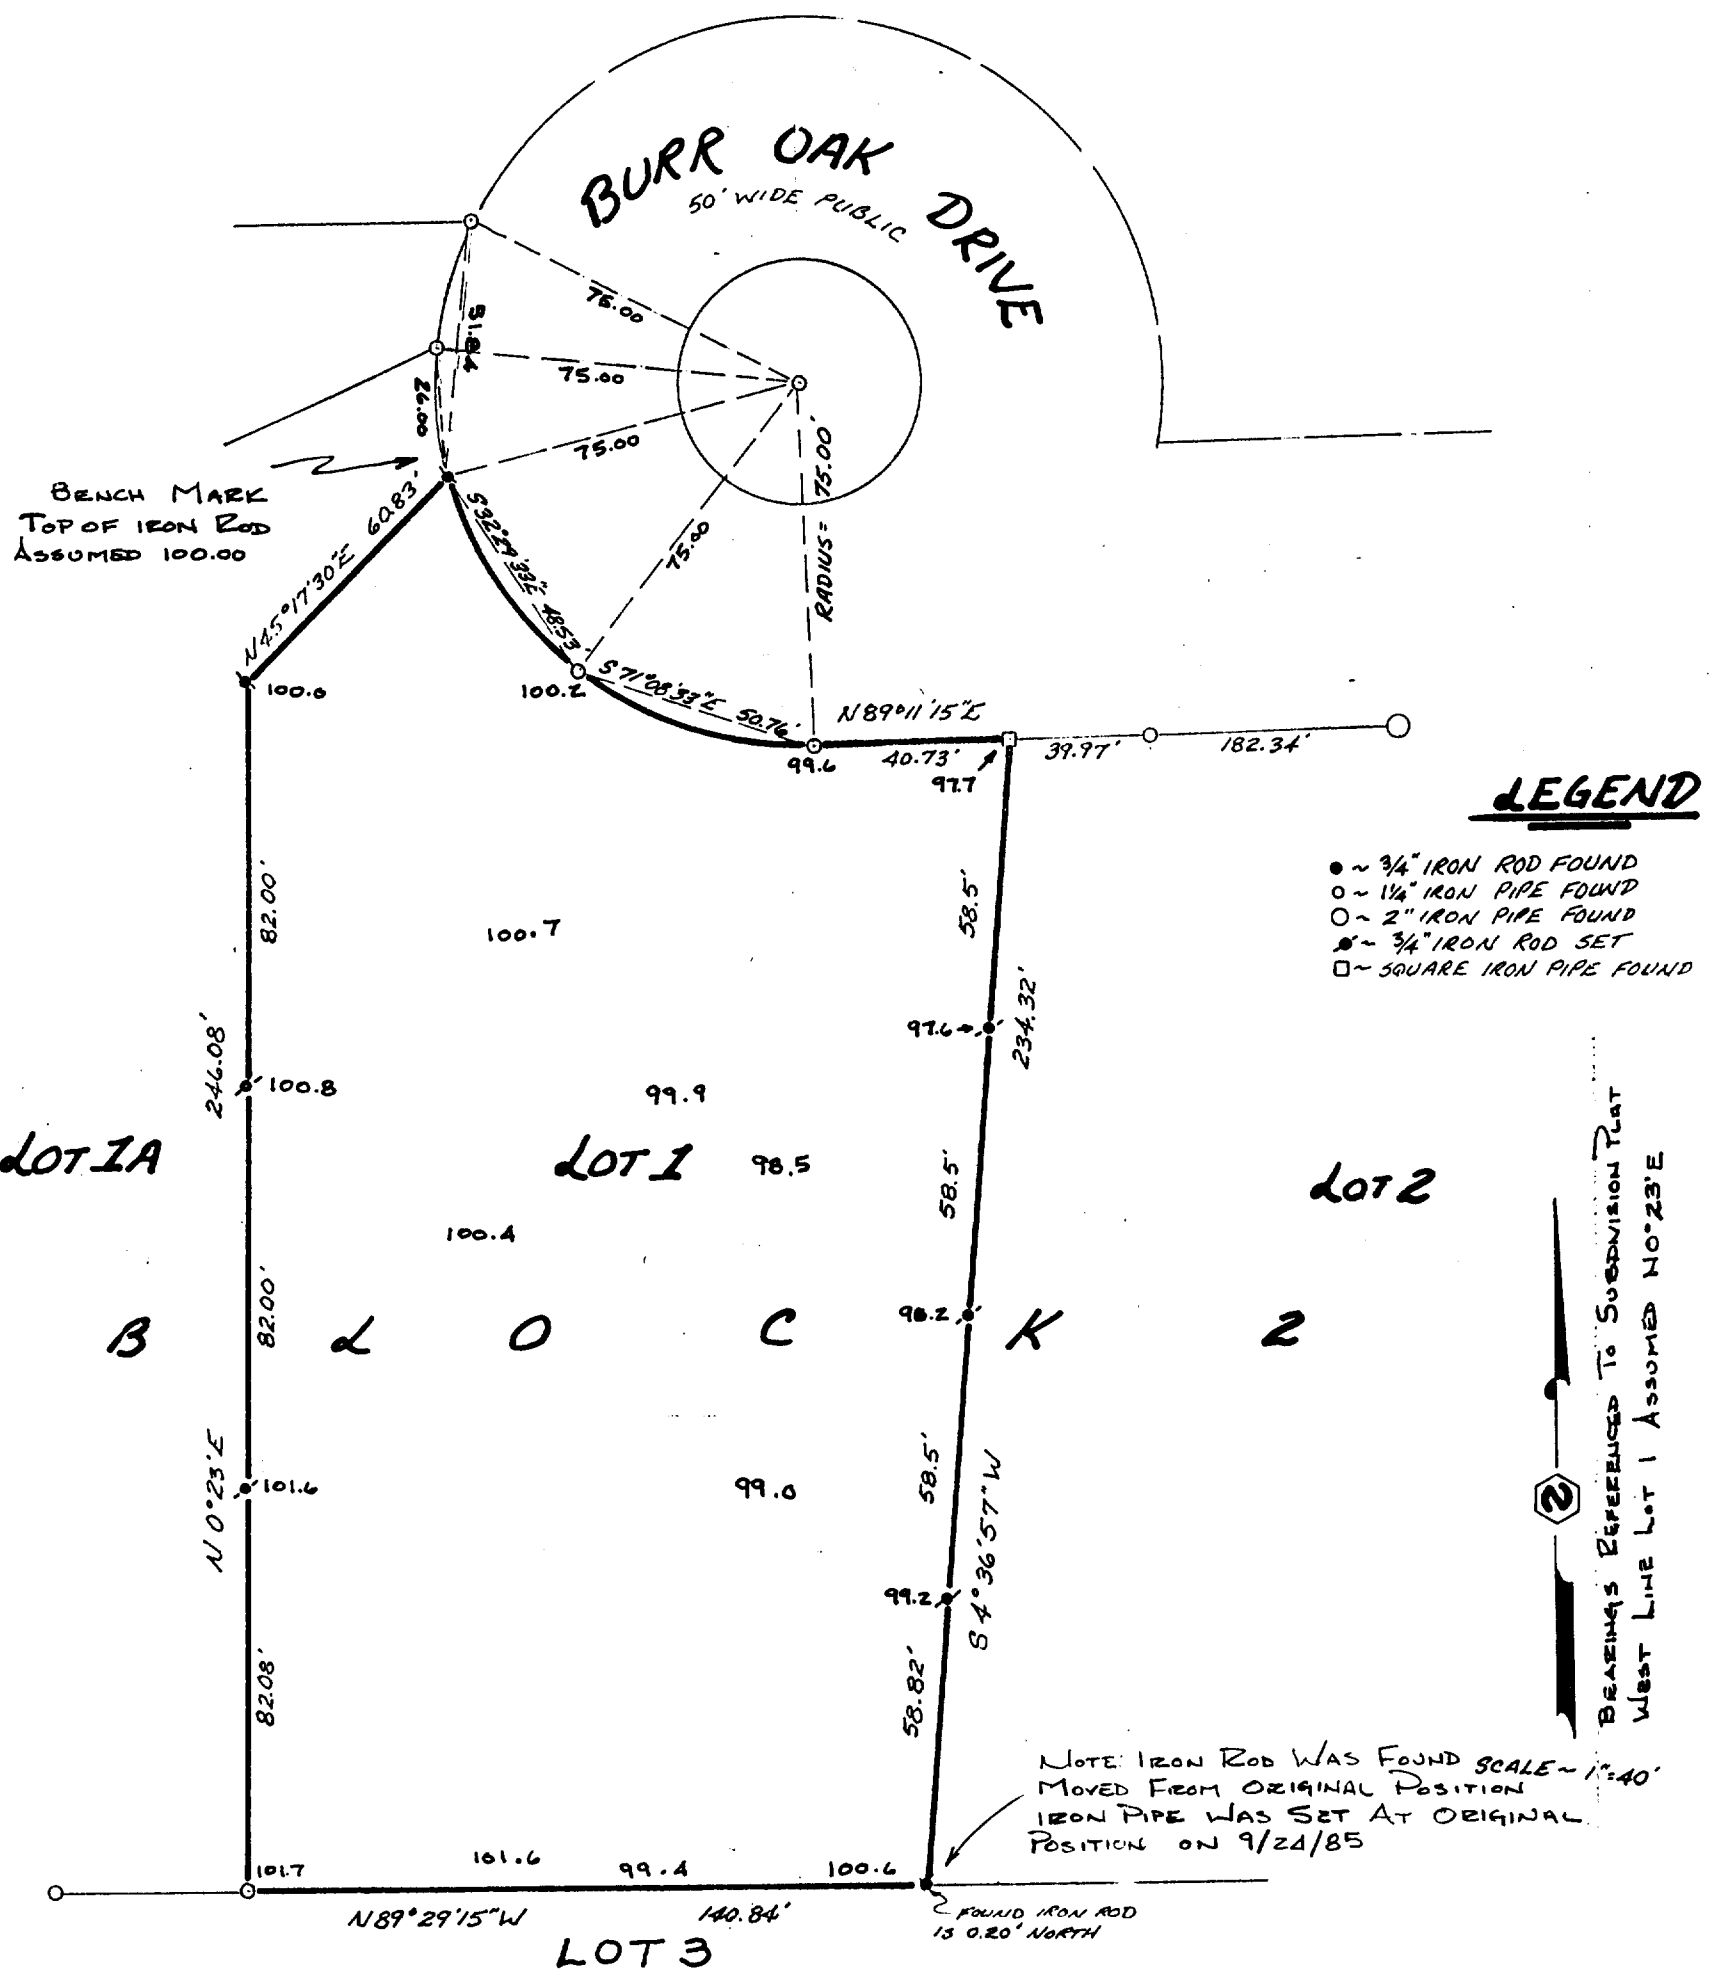


PLAT OF SURVEY OF LOT 1 BLK 2 TRINKE ESTATES

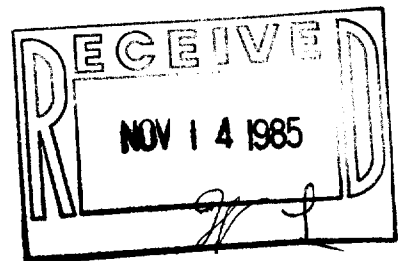

DESCRIPTION: Lot 1, Block Two of Trinke Estates,
Located in Section 10, T1N R17E,
Walworth County, Wis.

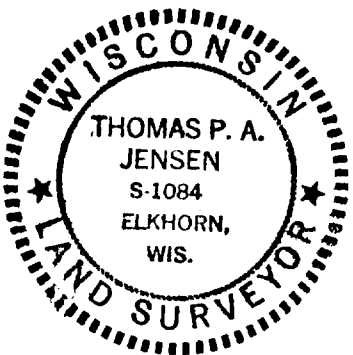

I, THOMAS P. A. JENSEN, WIS. REGISTERED LAND SURVEYOR, DO
HEREBY CERTIFY THAT THIS SURVEY WAS PERFORMED BY ME, OR UNDER MY
DIRECTION, IN FULL COMPLIANCE WITH THE OWNERS/AGENTS INSTRUCTIONS AND
CHAPTER A-E 5 OF WIS. ADMIN. CODE "MINIMUM STANDARDS FOR PROPERTY SURVEYS";
AND THAT THIS MAP IS AN ACCURATE REPRESENTATION THEREOF TO THE BEST
OF MY KNOWLEDGE AND BELIEF.

Thomas P. A. Jensen
THOMAS P. A. JENSEN S-1084

25 MARCH, 1985

Revised to show NE. Corner still in place. 9/20/85
REVISED 9/24/85

117-704-J