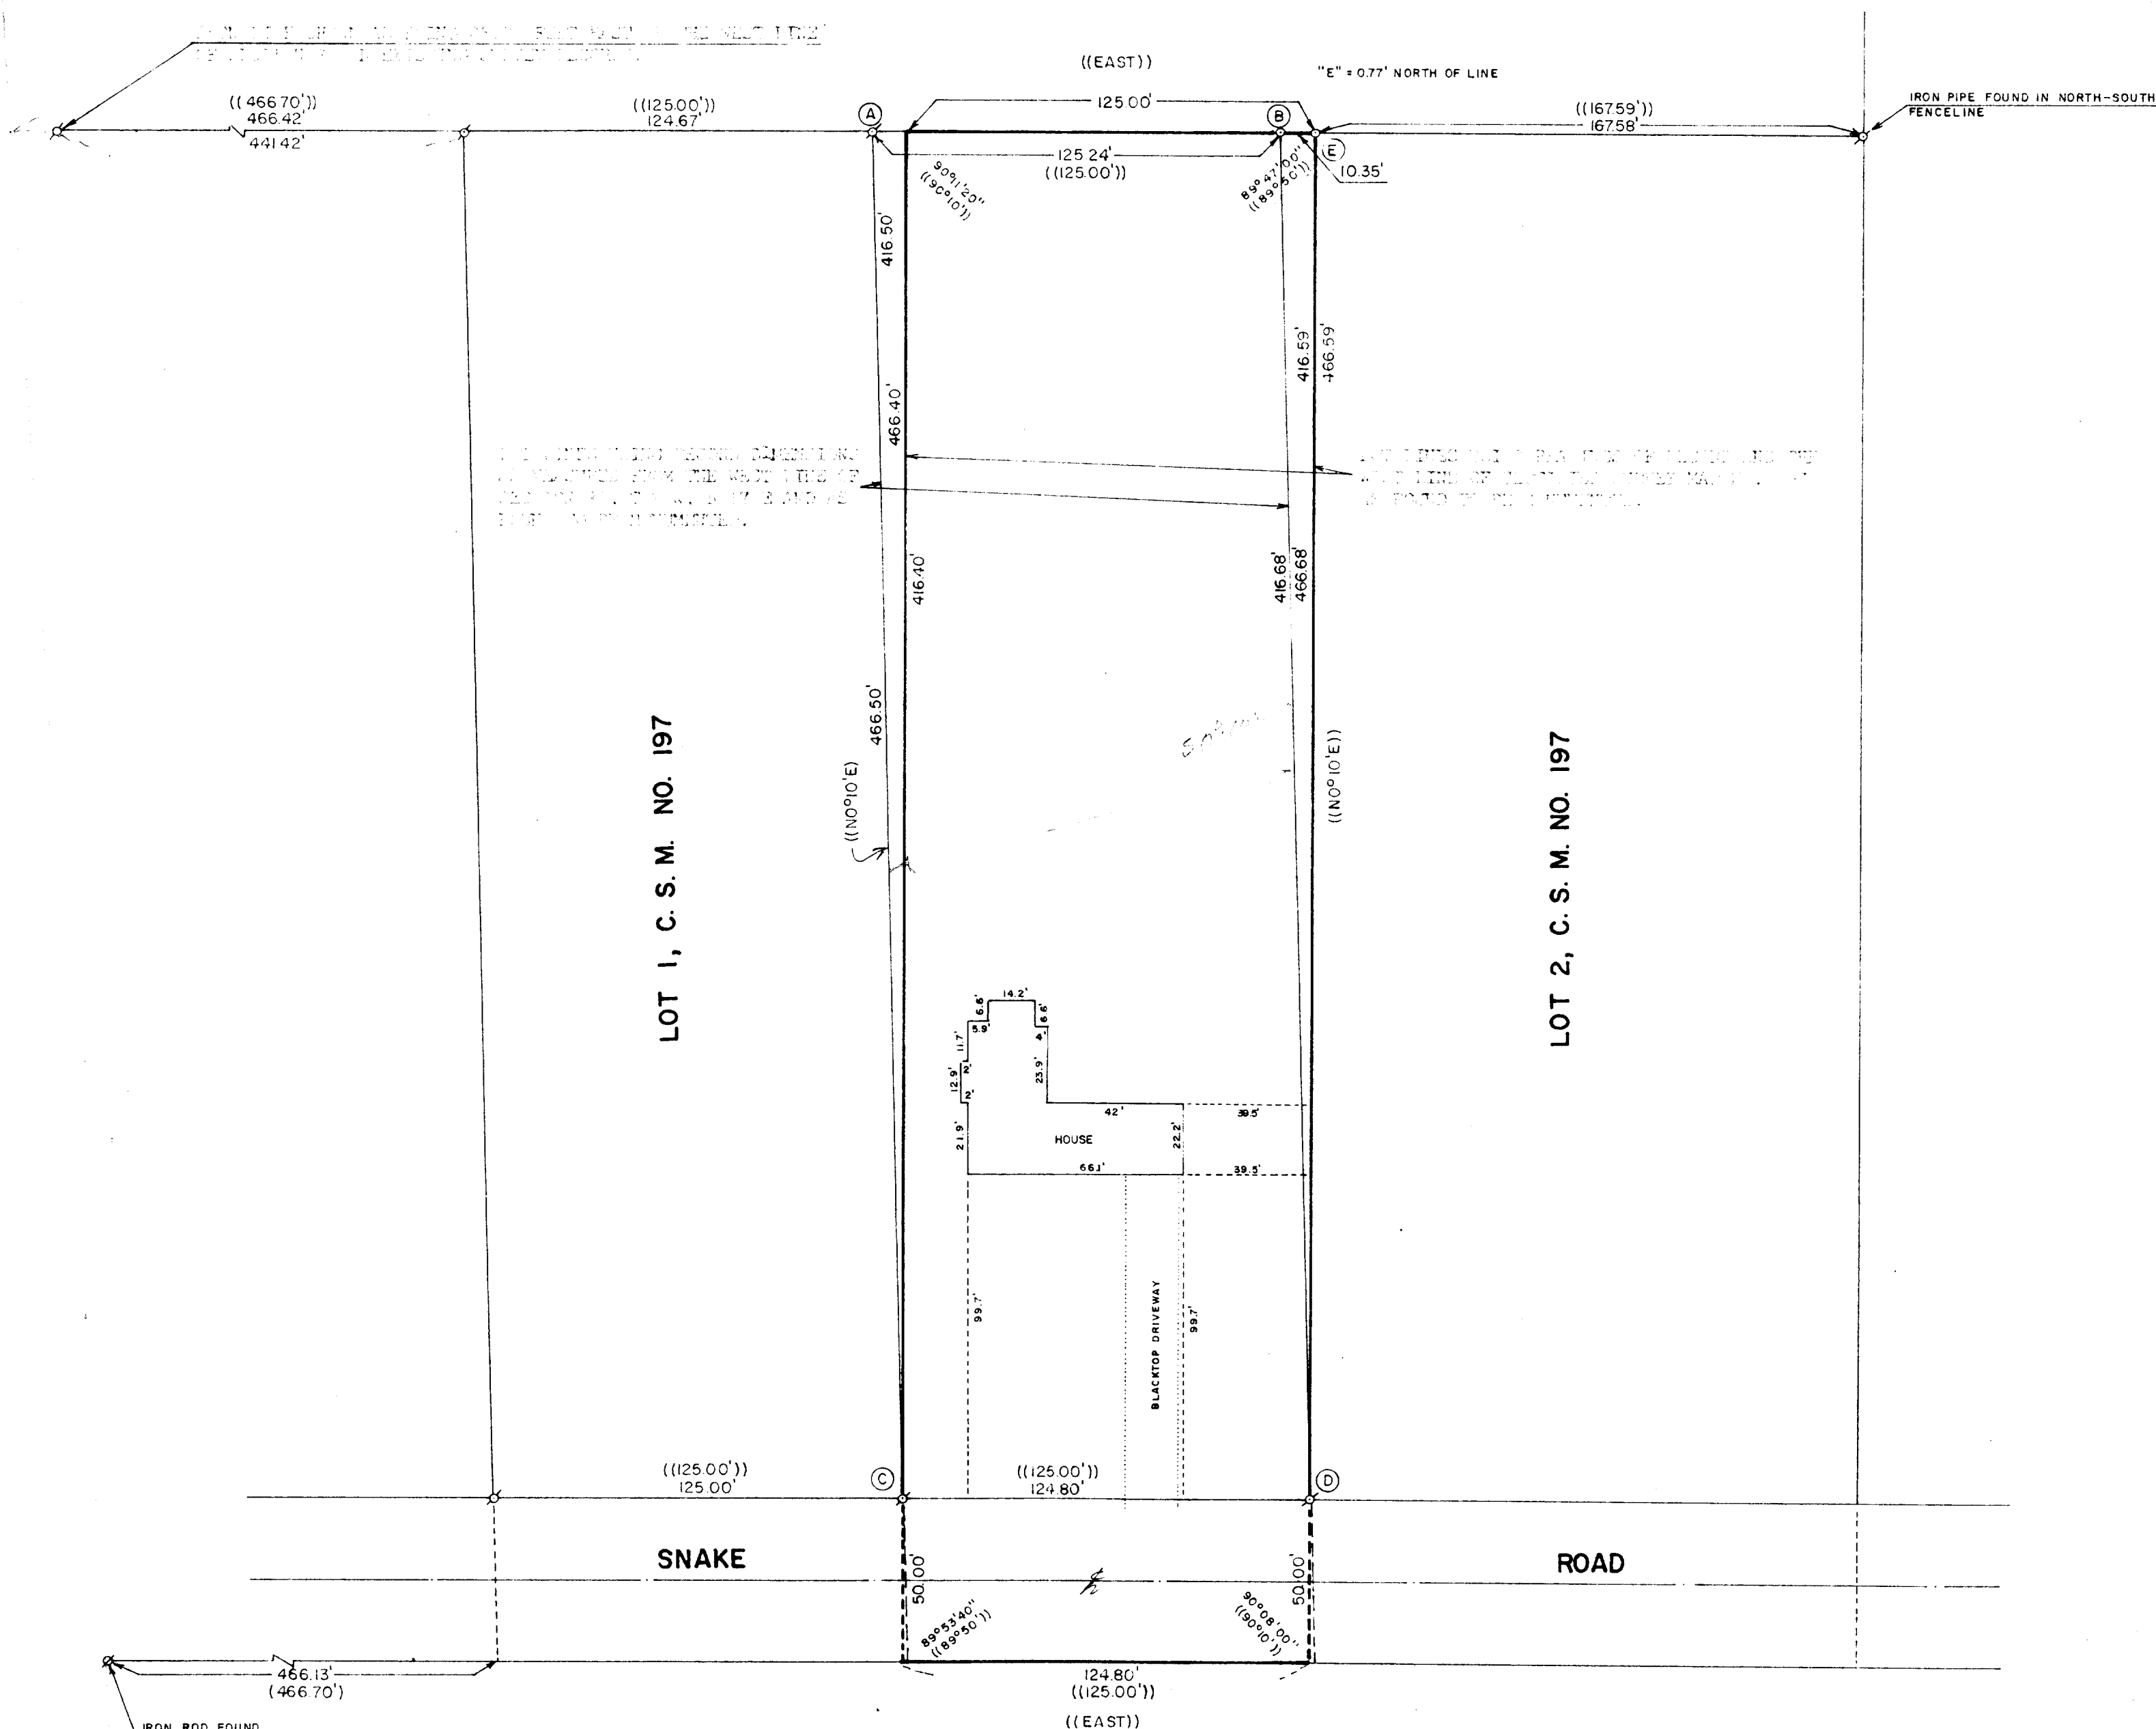


[illegible]

IRON AND PORTLAND CEMENT WEST HILLS CO. GIBBONS, N. Y.

PLAT OF SURVEY OF

2. PARCEL OF LAND LOCATED IN THE NORTHWEST 1/4 OF THE NORTHWEST 1/4 OF SECTION 3, T. 1 N., R. 7 E., WAPOKA COUNTY, WISCONSIN, DESCRIBED AS FOLLOWS: BEGINNING AT THE NORTHWEST CORNER OF SAID SEC. 3, THENCE S64°00'00"E 98.0 FEET; THENCE EAST 50.0 FEET TO THE POINT OF BEGINNING; THENCE S64°00'00"E 1/4 MILE; THENCE EAST 125.0 FEET; THENCE N64°00'00"E 1/4 MILE; THENCE WEST 125.0 FEET TO THE POINT OF BEGINNING.

ORDERED BY: GOLDWELL, WYNNE-CLIFF, JAMES AREA HAWTONE
803 MAIN STREET
LAKE CHARLE, VIRGINIA 22083



ϕ - 100% (100% P-100)
 ϕ - 100% (100% P-100)
 ϕ - 100% (100% P-100)
 (100% P-100) (100% P-100)

I, ROBERT M. WICKSTRALE, of the County of Jersey, State of New Jersey, do hereby certify that I have reviewed the previously stated charges against the principal subjects and that the filed herein is a correct representation of the previous lines to the best of my knowledge and belief.

Robert M. Baumwald
AGENT M. BAUMWALD
FIVE NORTH PULVERED LANE SUITE 200, J-1400

Aug. 28, 1986