

ABERNATHY and ASSOCIATES

Kenneth B. Abernathy Jr.

Wisconsin Registered Land Surveyor S-1594

Rt. 3, Box 273
Elkhorn, Wisconsin 53121
Phone: (414) 723-4260 (office)
(414) 723-4813 (residence)

PLAT OF SURVEY



Lots 3 and 4 and the North $\frac{1}{2}$ of Lot 6 of "SHORE HAVEN SUBDIVISION",
being a subdivision of part of Government Lot No. 2, Section 18,
Town 1 North, Range 17 East, Walworth County, Wisconsin.

surveyed for: Frank Sottrel
2955 N. Mannheim Rd.
Franklin Park, Ill. 60131

Note: This survey retraces a survey done by Lloyd L. Jensen, dated
July 1949. (on record with Walworth County Surveyor's Office.)

A survey done by Robert P. Brauer, dated August 25, 1982 was also
used. (this survey was never recorded.) Copy was provided by the
owner and then placed on record.

NOTE: THERE IS AN EXISTING PIER ON LOT 4

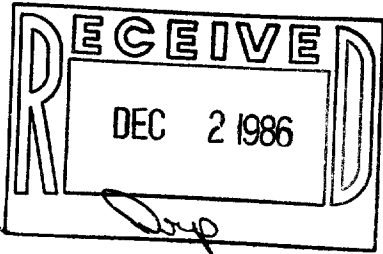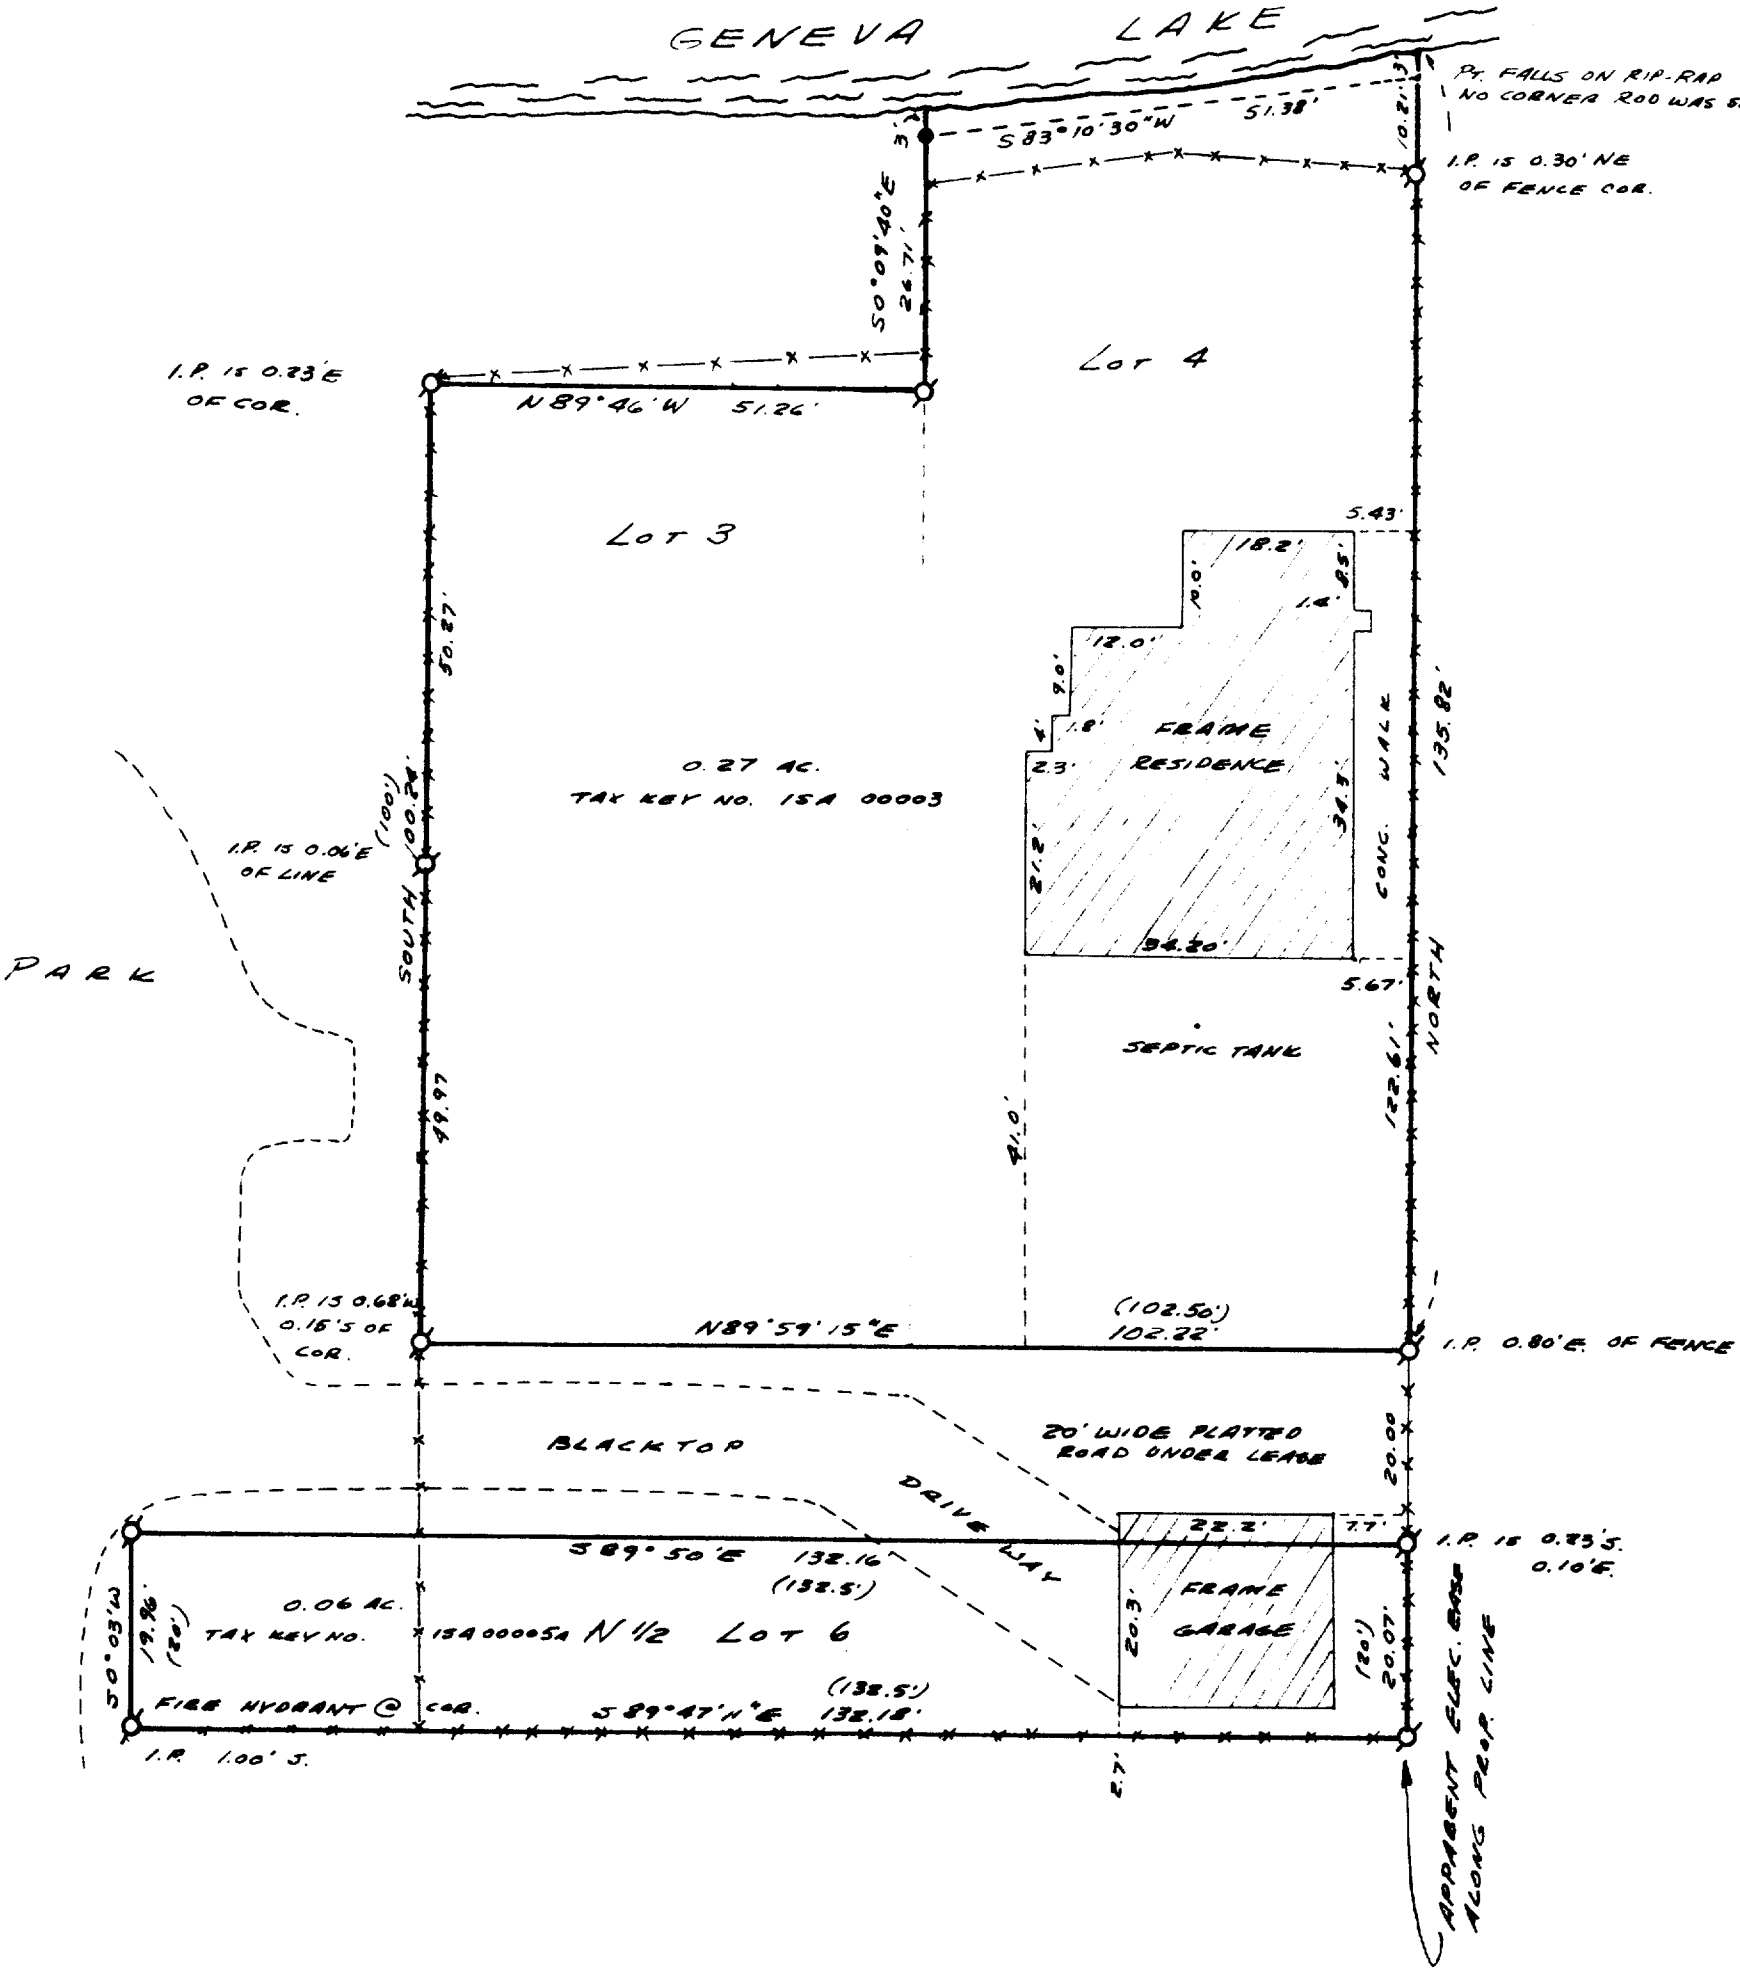

Legend

- FOUND IRON PIPE
- FOUND IRON ROD
- FOUND BRASS CAPPED MONUMENT
- FOUND CONCRETE MONUMENT
- CHISEL CUT IN CONCRETE
- SET IRON ROD, 24" LONG, WEIGHING 1.5 LBS./LINEAL FT., 3/4" DIA.
- SET IRON ROD, 30" LONG, WEIGHING 4.5 LBS./LINEAL FT., 1-11/16" DIA.
- RECORDED AS DIMENSION
- EXISTING FENCE



SCALE: 1" = 20' FEET

"I hereby certify that I have surveyed the above described
property and that the above map is a true representation
thereof and shows the size and location of the property, its
exterior boundaries, the location of all visible structures
and dimensions of all principal buildings thereon, boundary
fences, apparent easements, roadways and visible encroach-
ments, if any."
"This survey is made for the use of the present owners of
the property, and also those who purchase, mortgage, or
guarantee the title thereto within one year from date
hereof."

Kenneth B. Abernathy, Jr.

KENNETH B. ABERNATHY, JR.
WISCONSIN REGISTERED LAND SURVEYOR,
S-1594

Date: SEPT. 16, 1986 Job No. 902