


GEORGE T. DUNHAM
SURVEYING & SUBDIVIDING
DELAVAN, WISCONSIN

N

Scale - 1" = 100'
○ = Iron Pipe

Plat of survey of Lots 20-24 Inclusive and Lots 1, 2, 3, 4, 5, 8, 9, 12, 13, 16, 17, 20, 21, 23, 24, and 25 in Block 8 of Lake View Terrace located in Section 15, T 1 N, R 17 E, Walworth County, Wisconsin.
June 18, 1969

George T. Dunham
George T. Dunham, Surveyor

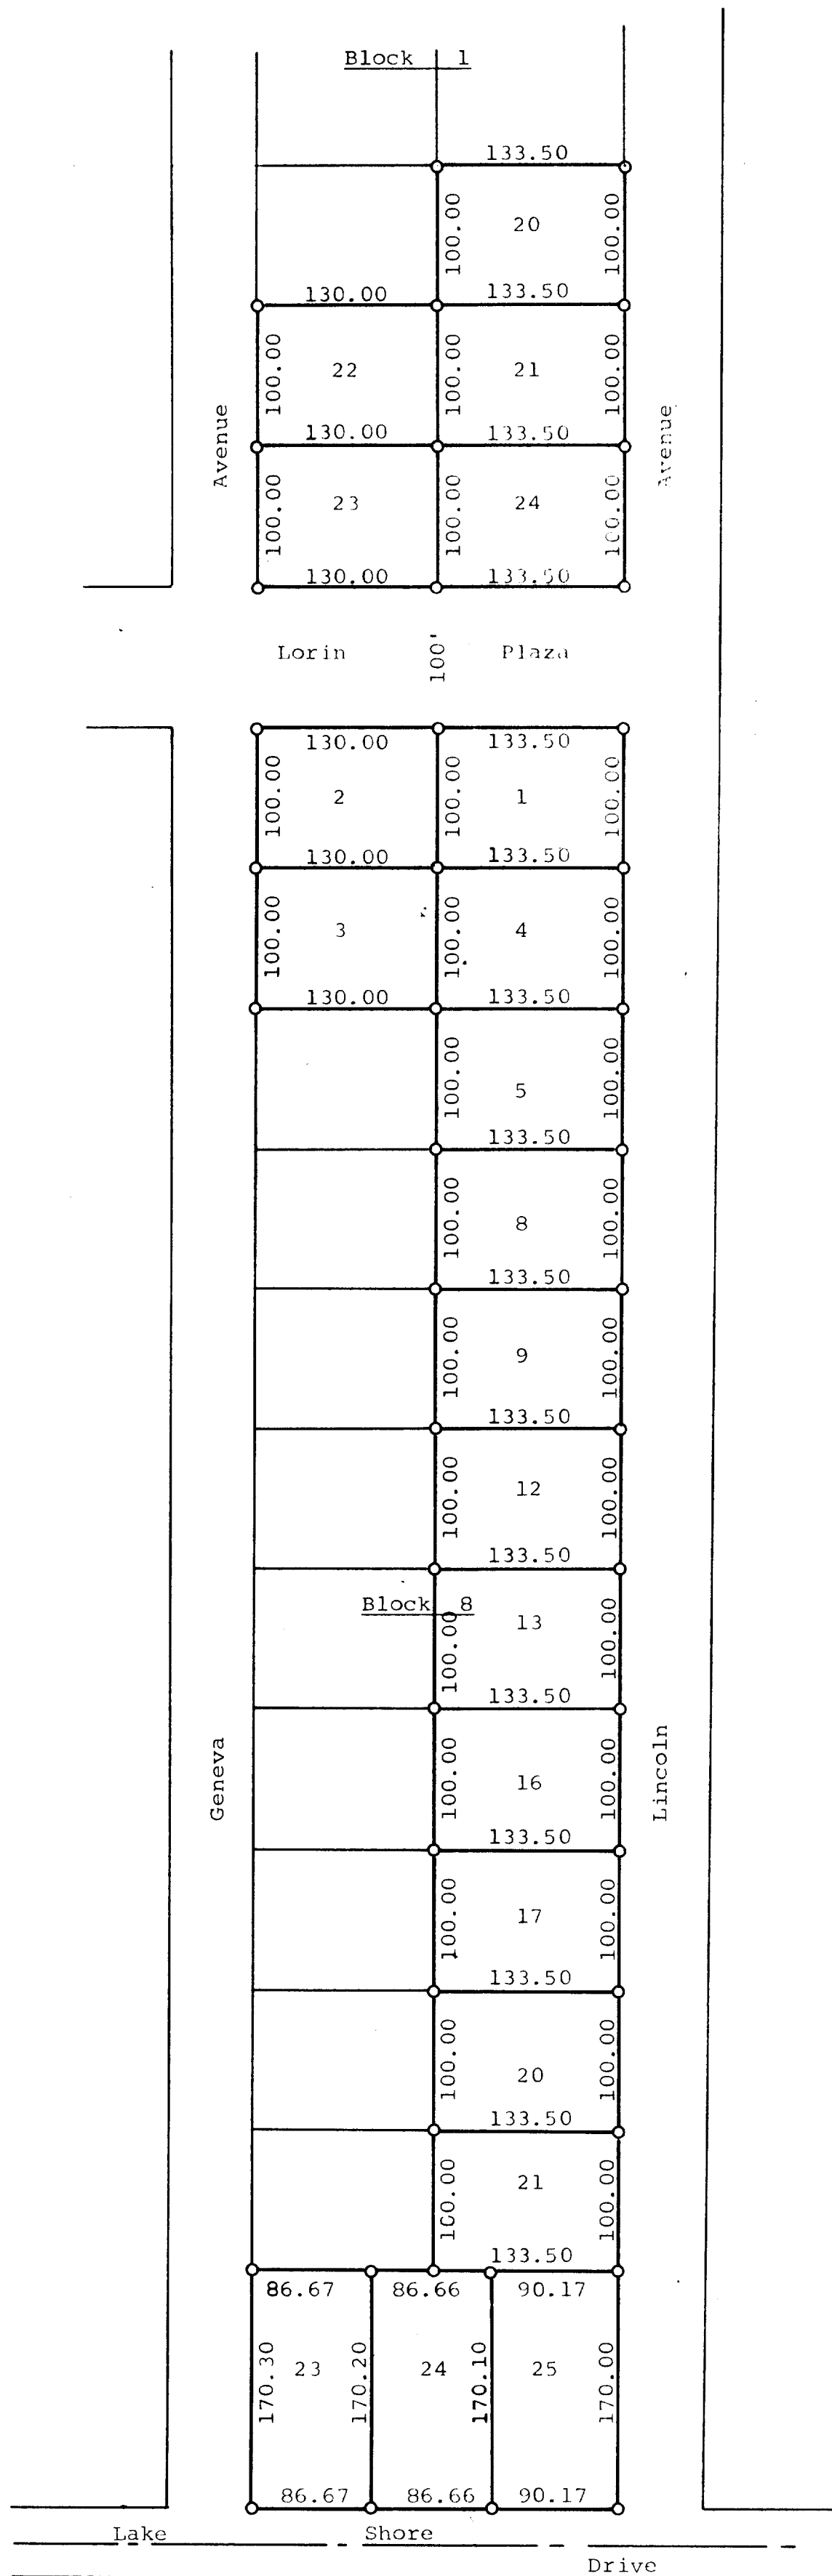

PLAT-13, 14, 15, 32, 32A1, 32A2, 32C, 32C1A
320, 33