


WALWORTH COUNTY
SURVEYING & MAPPING
LAKE GENEVA, WISCONSIN

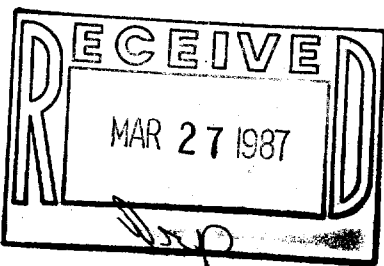

CERTIFIED SURVEY MAP NO. 74

PLAT OF SURVEY OF
PARCELS OF LAND LOCATED IN THE NORTHEAST 1/4 OF SECTION
18, T 1 N, R 17 E, WALWORTH COUNTY, WISCONSIN.


ORDERED BY: ASSURED REALTY
54 WEST GENEVA STREET
WILLIAMS BAY, WISCONSIN 53191

NOTE: THIS SURVEY REPRESENTS A LOT LINE ADJUSTMENT.

I, ROBERT M. BAERENWALD, DO HEREBY CERTIFY THAT I
HAVE SURVEYED THE PROPERTY HEREON DESCRIBED ACCORDING
TO THE OFFICIAL RECORDS AND THAT THE PLAT HEREON IS A
CORRECT REPRESENTATION OF THE PROPERTY LINES TO THE
BEST OF MY KNOWLEDGE AND BELIEF.

Robert M. Baerenwald
ROBERT M. BAERENWALD
WISCONSIN REGISTERED LAND SURVEYOR, S-1508

Dec. 23, 1986
DATE JOB NO. 0808
REVISED DATE: JAN. 4, 1987

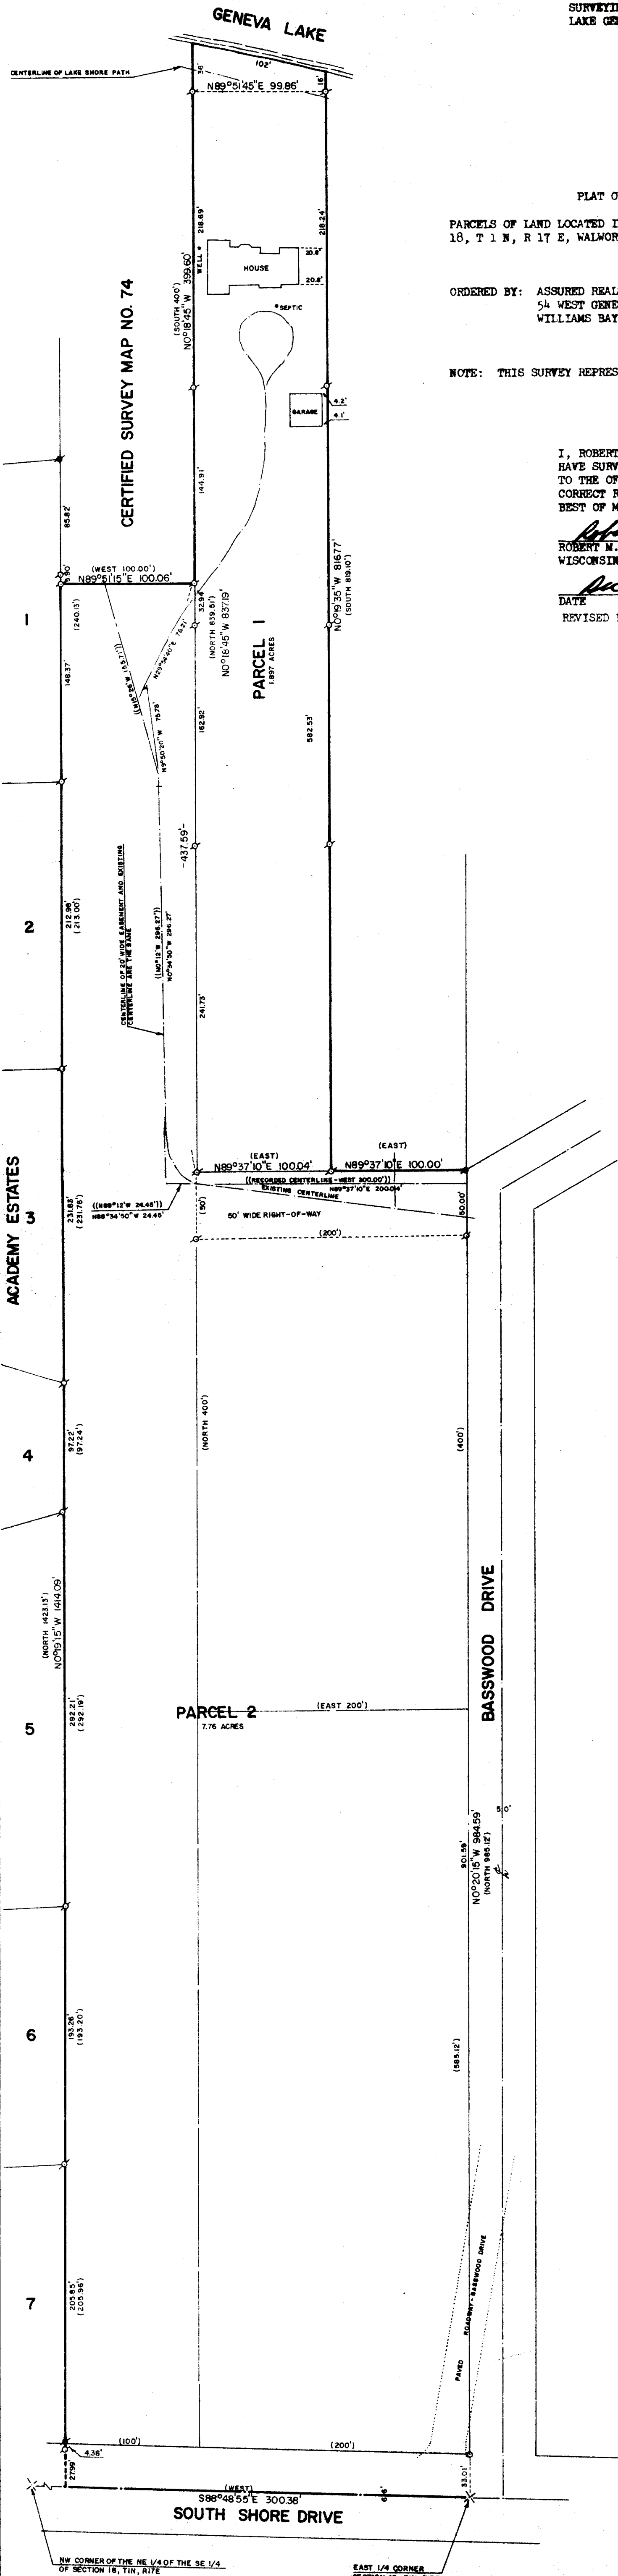

SCALE: 1"=60'

- o - IRON PIPE FOUND
- - CONCRETE MONUMENT FOUND
- x - SPIKE FOUND
- o - IRON ROD PLACED
- () - RECORDED AS