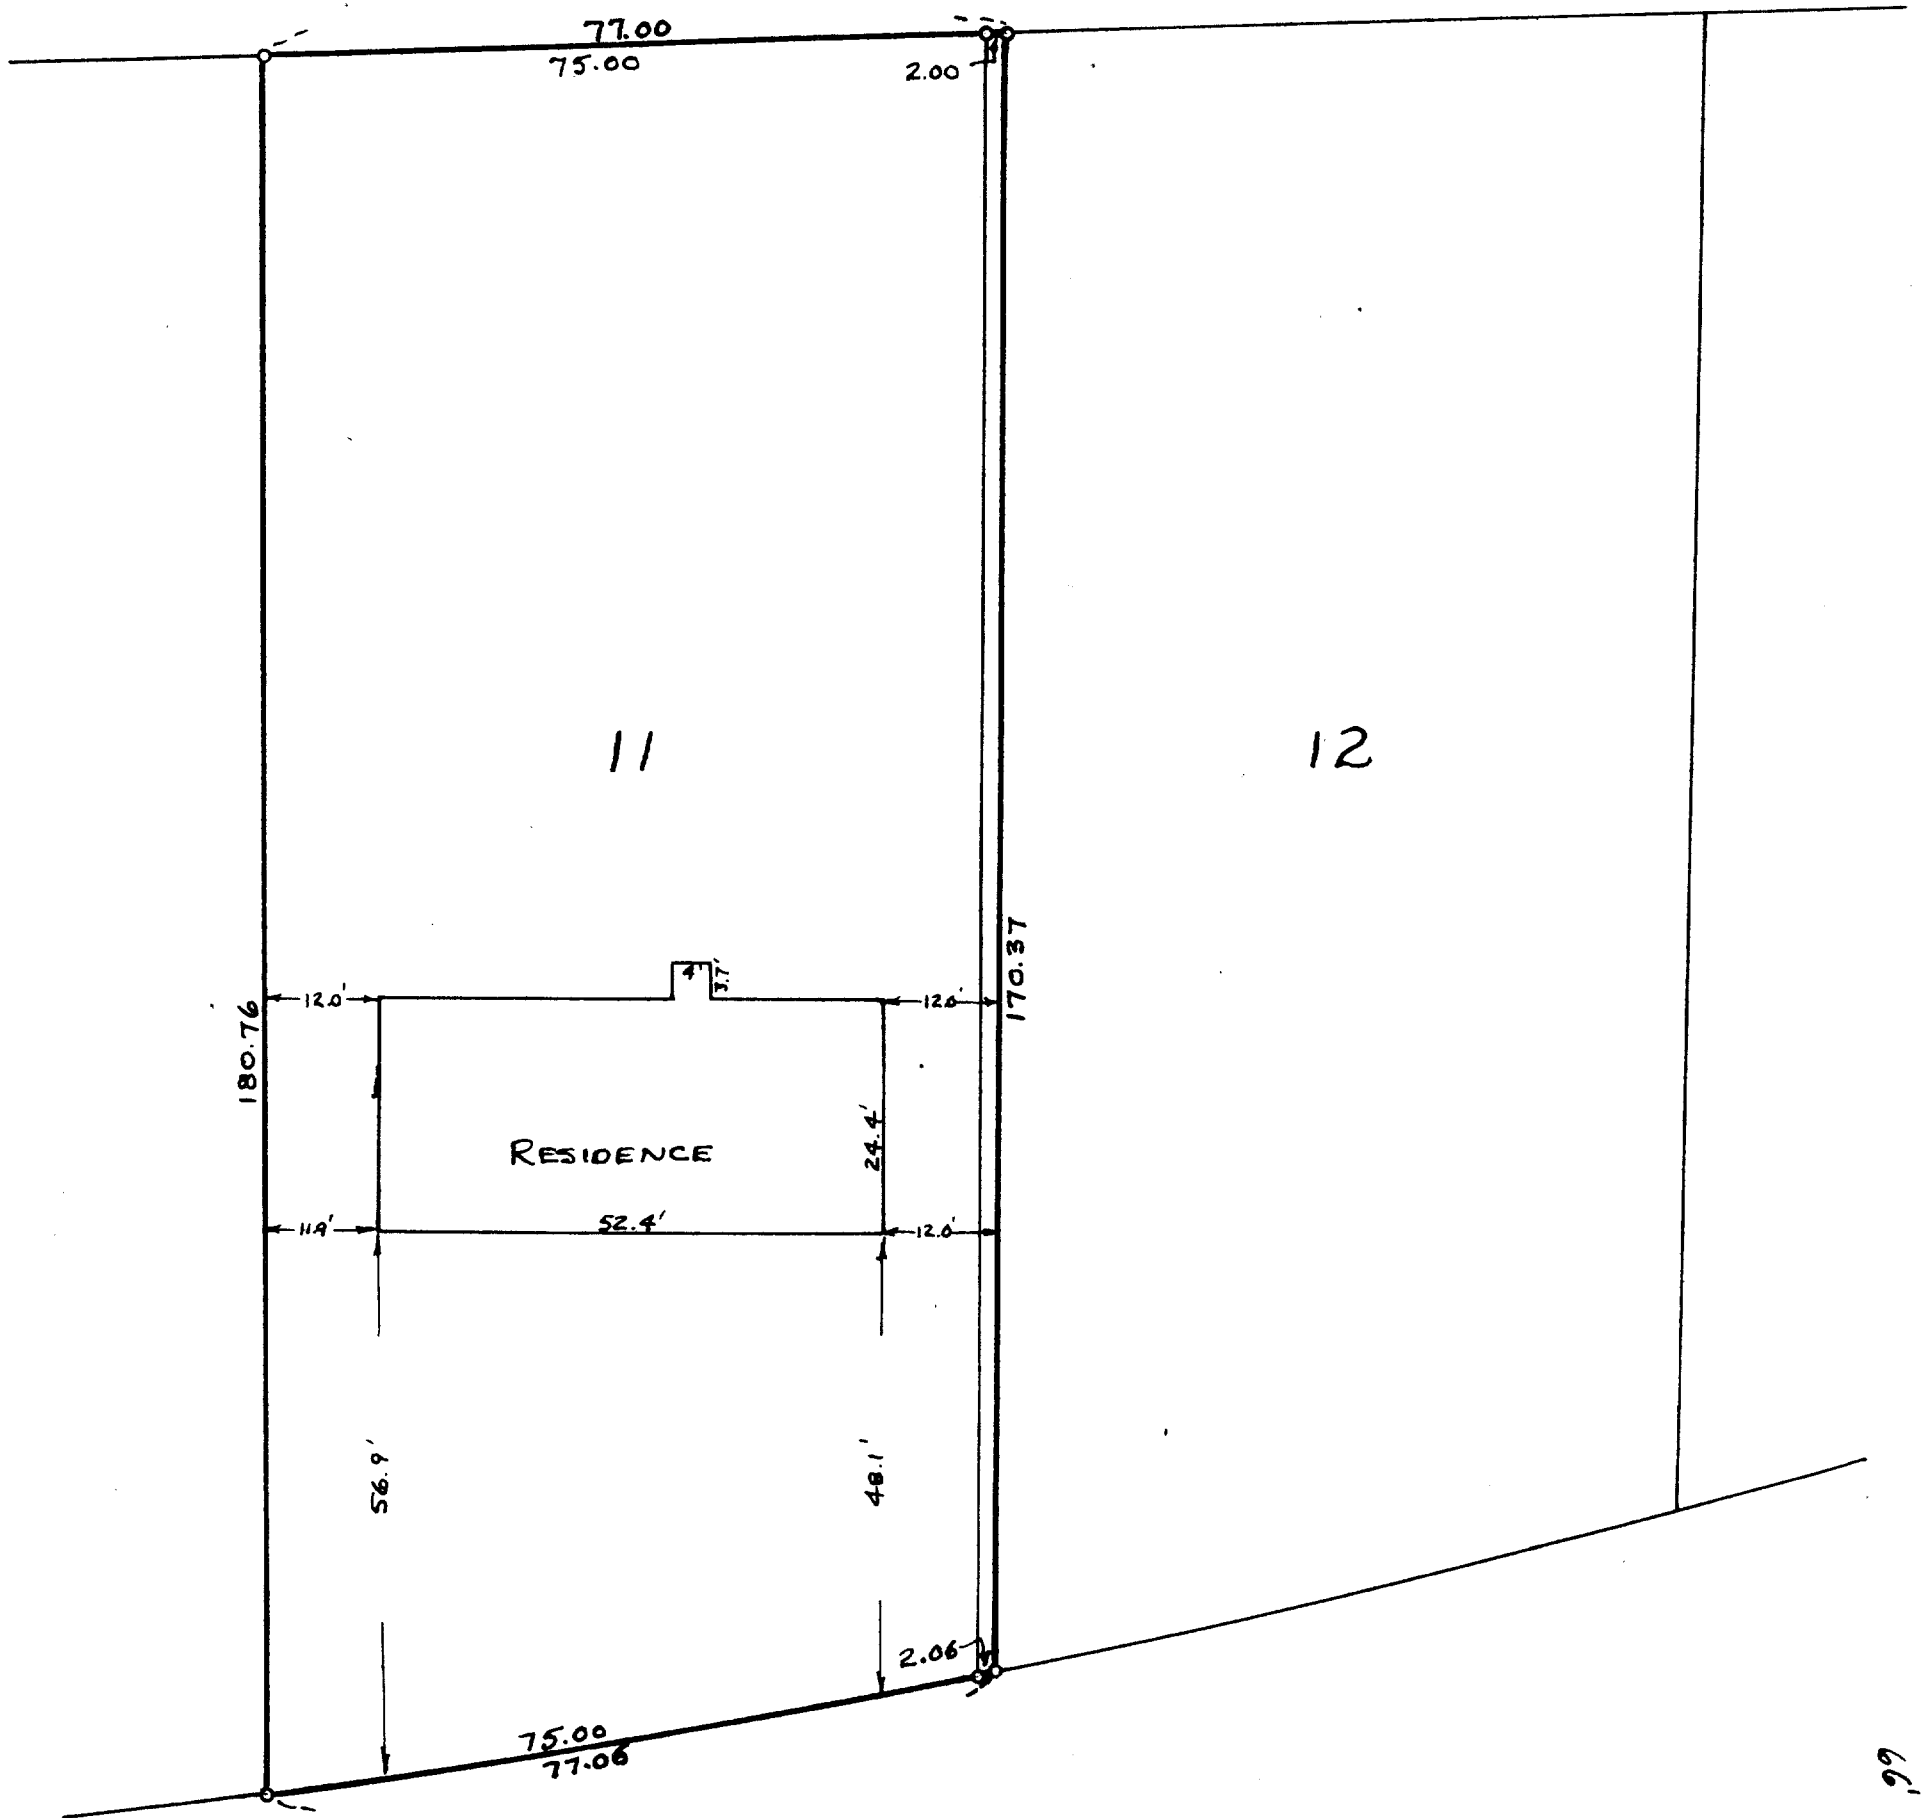


SCALE 1" = 20'
 O = IRON PIPE

PLAT OF SURVEY OF LOT 11 AND THE SOUTH
 2' OF LOT 12 OF BLOCK 6 OF WOODDALE ADDITION
 LOCATED IN T1N17E OF WALWORTH CO., WIS.

SEPT. 1949

Floyd L. Jensen
 COUNTY SURVEYOR

IW-55A
 " 55B