
OF Lot 33 except the northerly 5 feet and Lot 35, Lake Geneva Club, section 18, T 1 N, R 17 E, Town of Linn, Walworth County, Wisconsin.

SURVEYED FOR: L. Sweet, Elkhorn, Wis.

Jensen Surveying & Mapping, S.C. Elkhorn, Wis. 53121 (414) 723-3434 SURVEYED BY:

1, Thomas P.A. Jensen, Wisconsin Registered Land Surveyor, do hereby certify that this survey was performed by me, or under my direction, in full compliance with the owner's/agent's instructions and Chapter A-E 5 of the Wisconsin Administrative Code "Minimum Standards For Property Surveys"; and that this map is an accurate representation thereof to the best of my knowledge and halief



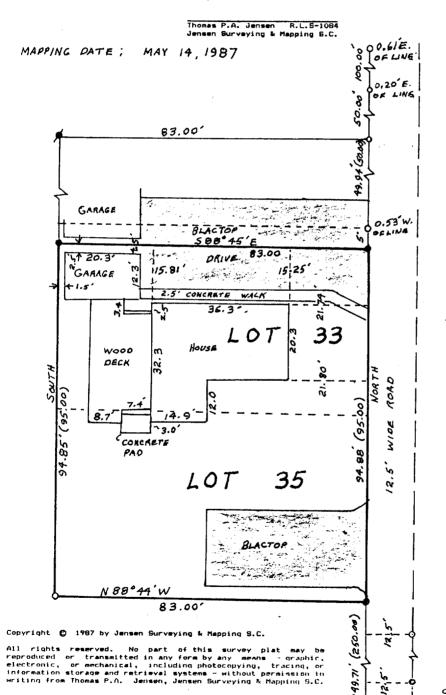

Note: This survey plat is not certified

unless signed and sealed in red ink.

LEGEND

- O FOUND IRON PIPE
- . SET IRON ROD
- # FOUND IRON ROD

BEARINGS REFERENCED ROAD LINE

SCALE: 1" = 20'

1987.046