

PLAT OF SURVEY

SHOWING RIPARIAN RIGHTS

FOR

LOT 3 OF S.B. CHAPINS SUBDIVISION AND LOT A
OF CERTIFIED SURVEY MAP NO. 22, LOCATED IN
SAID SUBDIVISION WHICH IS LOCATED IN THE
SOUTHWEST 1/4 OF SECTION 4, T1N, R17E, TOWN
OF LINN, WALWORTH COUNTY, WISCONSIN.

SURVEYED FOR: EDWARD F. THOMPSON
CLAIR LAW OFFICES, S.C.
617 E. WALWORTH AVE.
DELAVER, WI 53115
(414) 728-9196



SURVEYED BY: Jensen Surveying & Mapping S.C.
45 S. Wisconsin St. P.O. Box 322
Elkhorn, Wisconsin. 53121
(414) 723-3434

NOTE BOUNDARIES OF RIPARIAN
INTERESTS DETERMINED UNDER
SECTION NR 326.07 (2)(c)
WISCONSIN ADMINISTRATIVE CODE

(c) Extended lot lines. Under the extended lot line method the area
of water within which each riparian may place a pier to reach the line of
navigation is determined by extending the lot lines along the same align-
ment from the upland to the line of navigation.

SCALE: 1" = 20'

BEARINGS ASSUMED AS SHOWN ON
EXISTING SURVEY RECORDS

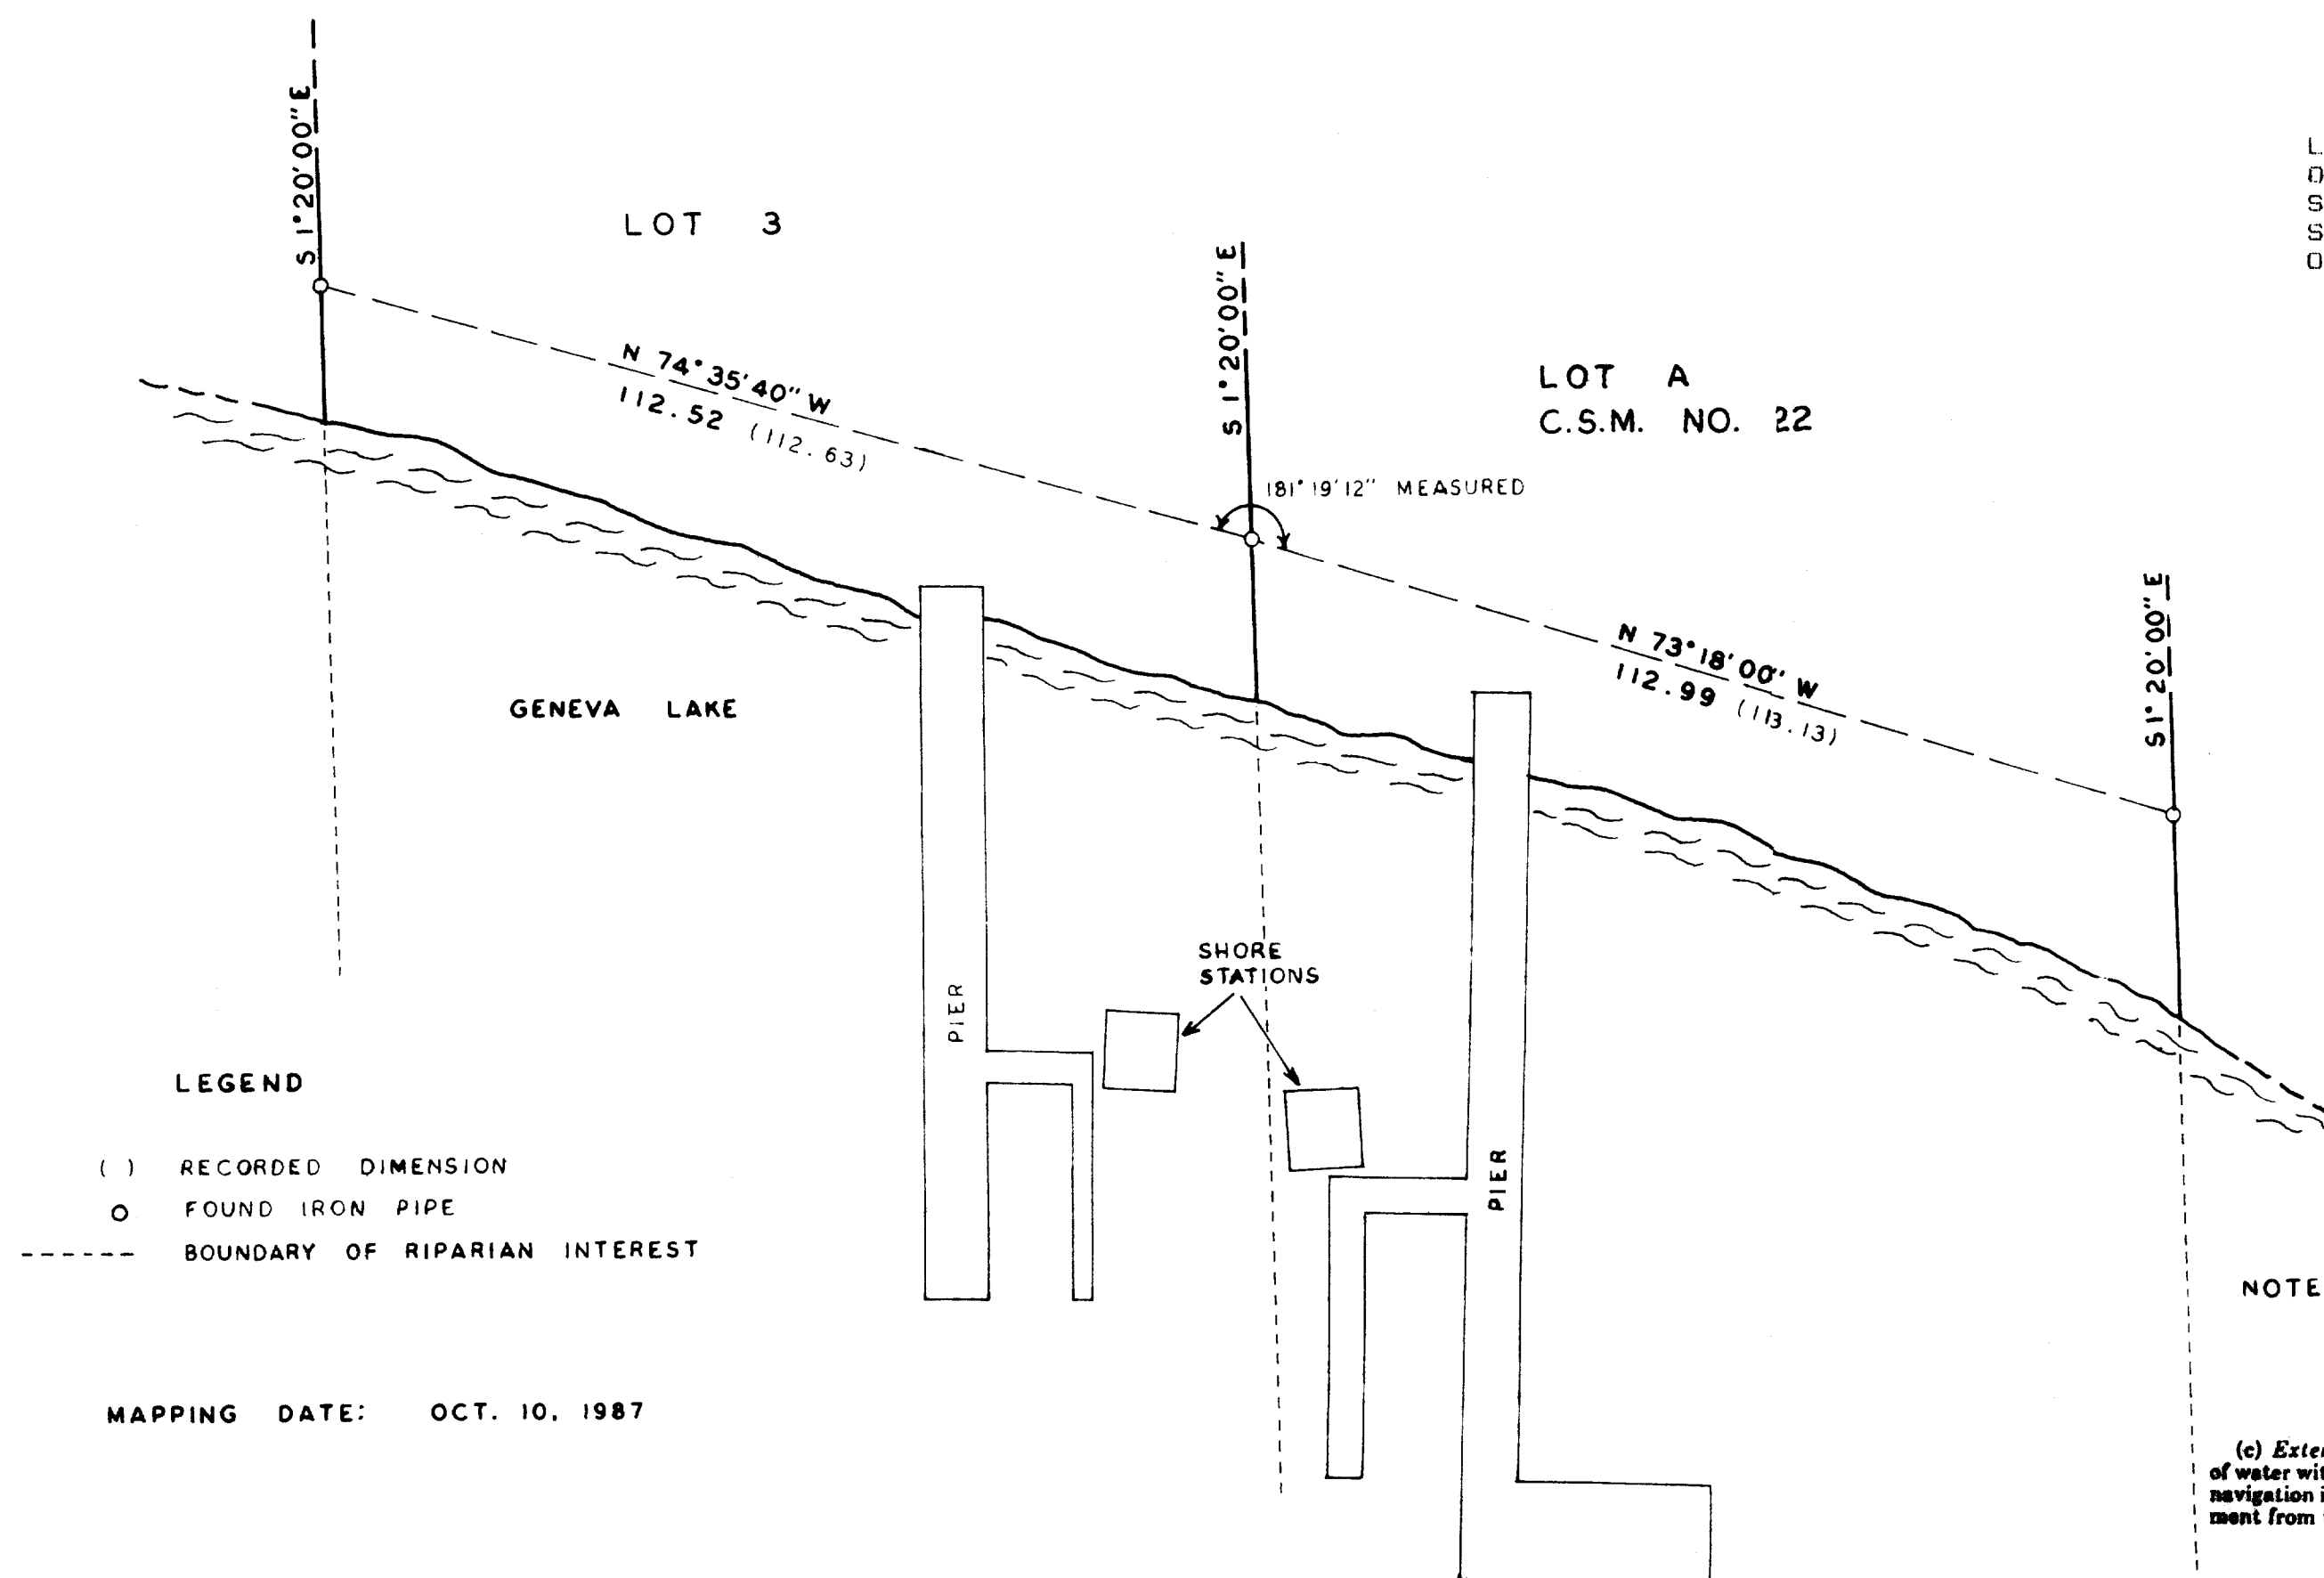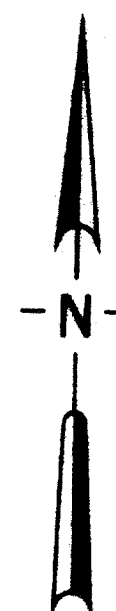

Note: This survey plat is not certified
unless signed and sealed in red ink.

I, Thomas P.A. Jensen, Wisconsin Registered Land Surveyor,
do hereby certify that this survey was performed by me, or under
my direction, in full compliance with the owner's/agent's instru-
ctions and Chapter A-E 5 of the Wisconsin Administrative Code
"Minimum Standards For Property Surveys"; and that this map is
an accurate representation thereof to the best of my knowledge
and belief.

Thomas P.A. Jensen R.L.S-1084
Jensen Surveying & Mapping S.C.

Copyright © 1987 by Jensen Surveying & Mapping S.C.

All rights reserved. No part of this survey plat may be
reproduced or transmitted in any form by any means - graphic,
electronic, or mechanical, including photocopying, tracing, or
information storage and retrieval systems - without permission in
writing from Thomas P.A. Jensen, Jensen Surveying & Mapping S.C.

1987.105

