
WALWORTH COUNTY SURVEYING & MAPPING LAKE GENEVA, WISCONSIN

POPLAR STREET



PLAT OF SURVEY OF

LOT 19, EXCEPT THE EASTERLY 43.5 FEET, OF ROBINSON'S FIRST ADDITION, LOCATED IN T 1 N, R 17 E, WALWORTH COUNTY, WISCONSIN.

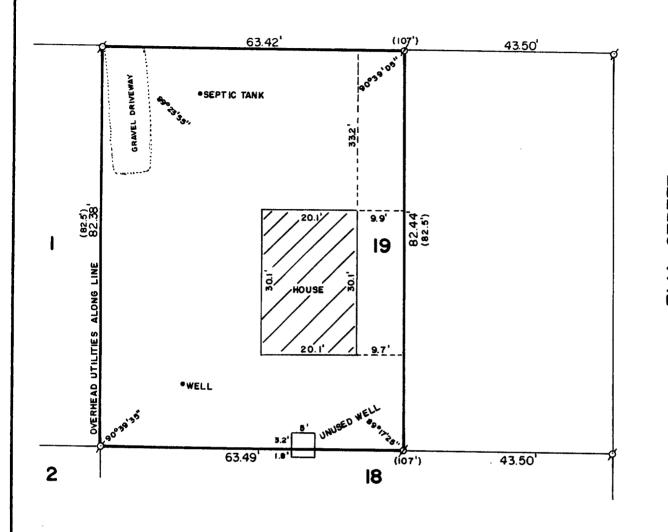

SCALE: 1"=20'

ø-IRON PIPE FOUND ø-IRON ROD FOUND ()-RECORDED AS ORDERED BY: CENTURY 21 GENEVA LAKE

503 CENTER STREET

LAKE GENEVA, WISCONSIN

53147

IHEREBY CERTIFY THAT I HAVE SURVEYED THE ABOVE DESCRIBED PROPERTY AND THAT THE ABOVE MAP IS A TRUE REPRESENTATION THEREOF AND BHOWS THE SIZE AND LOCATION OF THE PROPERTY, ITS EXTERIOR BOUNDARIES, THE LOCATION OF ALL VISIBLE STRUCTURES AND DIMENSIONS OF ALL PRINCIPAL BUILDINGS THEREON, BOUNDARY FENCES, APPARENT EASEMENTS AND ROADWAYS AND VISIBLE ENCROACHMENTS, IF ANY.

THIS SURVEY IS MADE FOR THE EXCLUSIVE USE OF THE PRESENT OWNERS OF THE PROPERTY, AND ALSO THOSE WHO PURCHASE, MORTGAGE, OR GUARANTEE THE TITLE THERETO WITHIN ONE (1) YEAR FROM DATE HEREOF.

DODEDIT M. DADDENIAND

ROBERT M. BAERENWALD

WISCONSIN REGISTERED LAND SURVEYOR, S-1508

DATE JOB NO. 1668

NOTE: THIS IS NOT A CERTIFIED COPY UNLESS SEALED.

117-909

I Charles