


SCALE 1" = 20'
 O = IRON PIPE
 ● = CONCR. MONU.

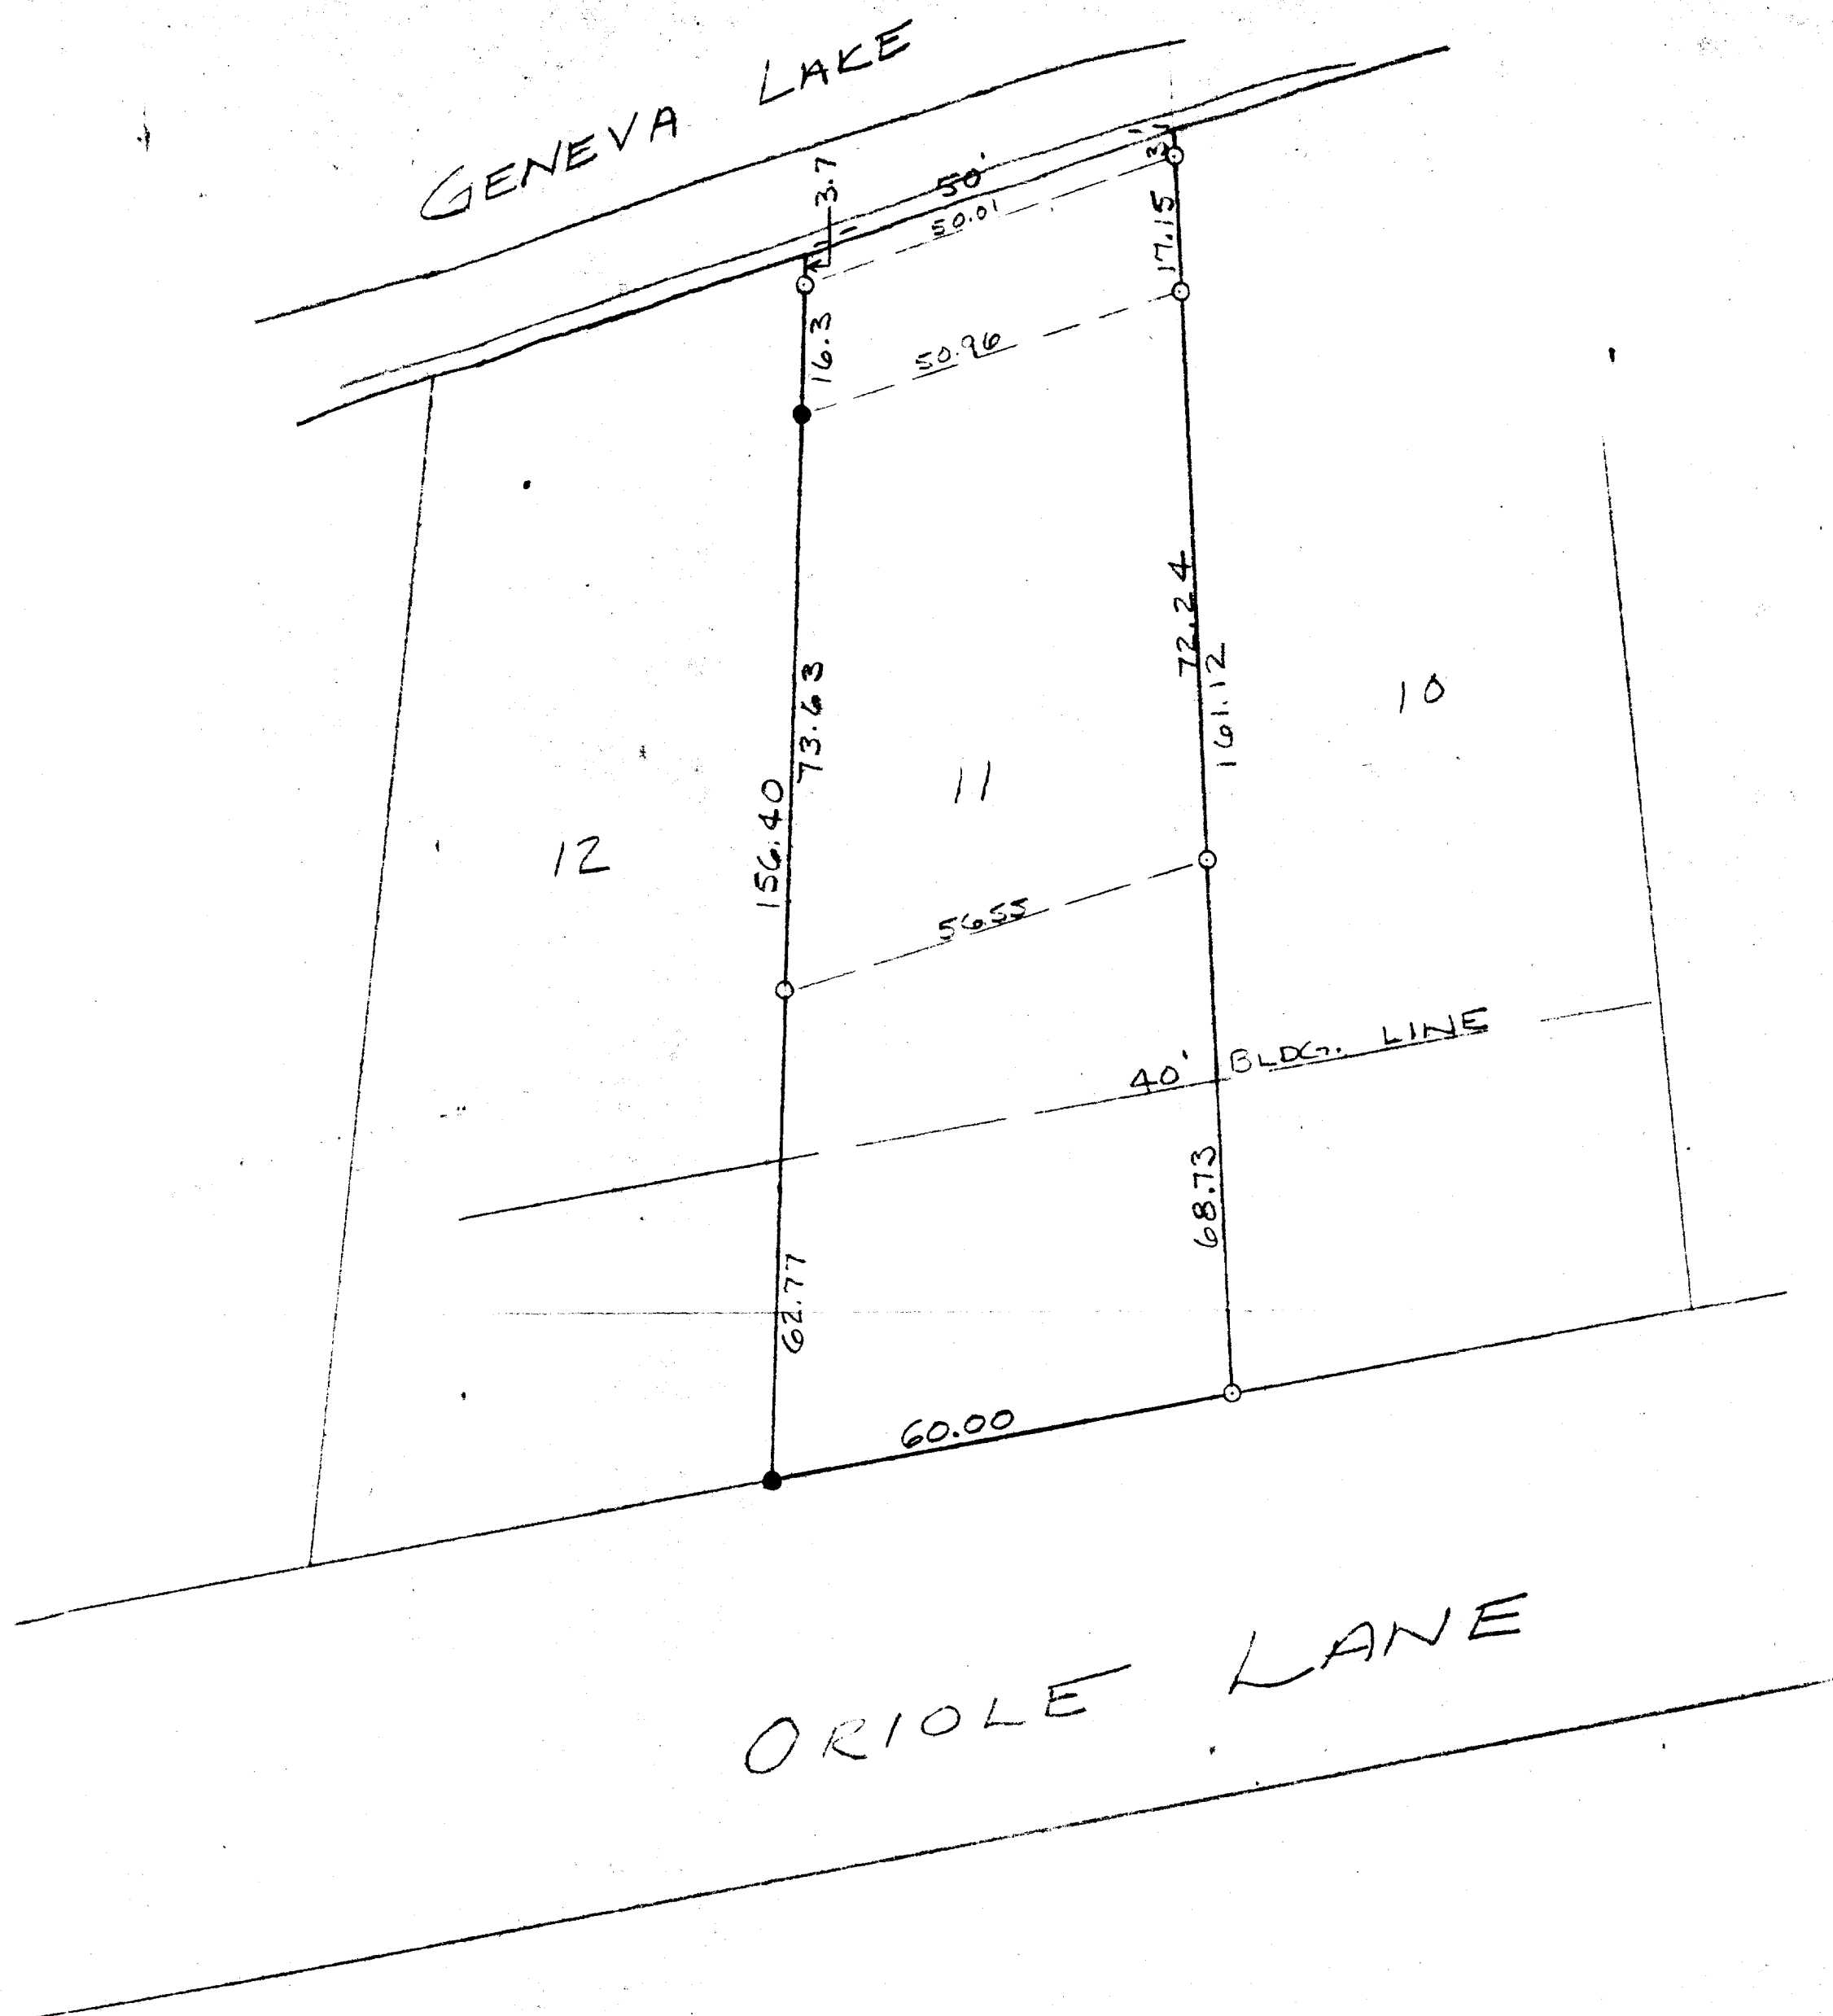

PLAT OF SURVEY OF LOT 11 OF BLOCK A OF
 CISCO BEACH SUBDIVISION LOCATED IN SECTION
 5 OF T1N R1E, WALWORTH COUNTY, WISCONSIN.

NOVEMBER, 1950

Lloyd L. Jensen
 COUNTY SURVEYOR