


WHITEWATER, WISCONSIN 53190



LEGEND

98 | 1

RECEIVED
MAR 14 1989
Bry

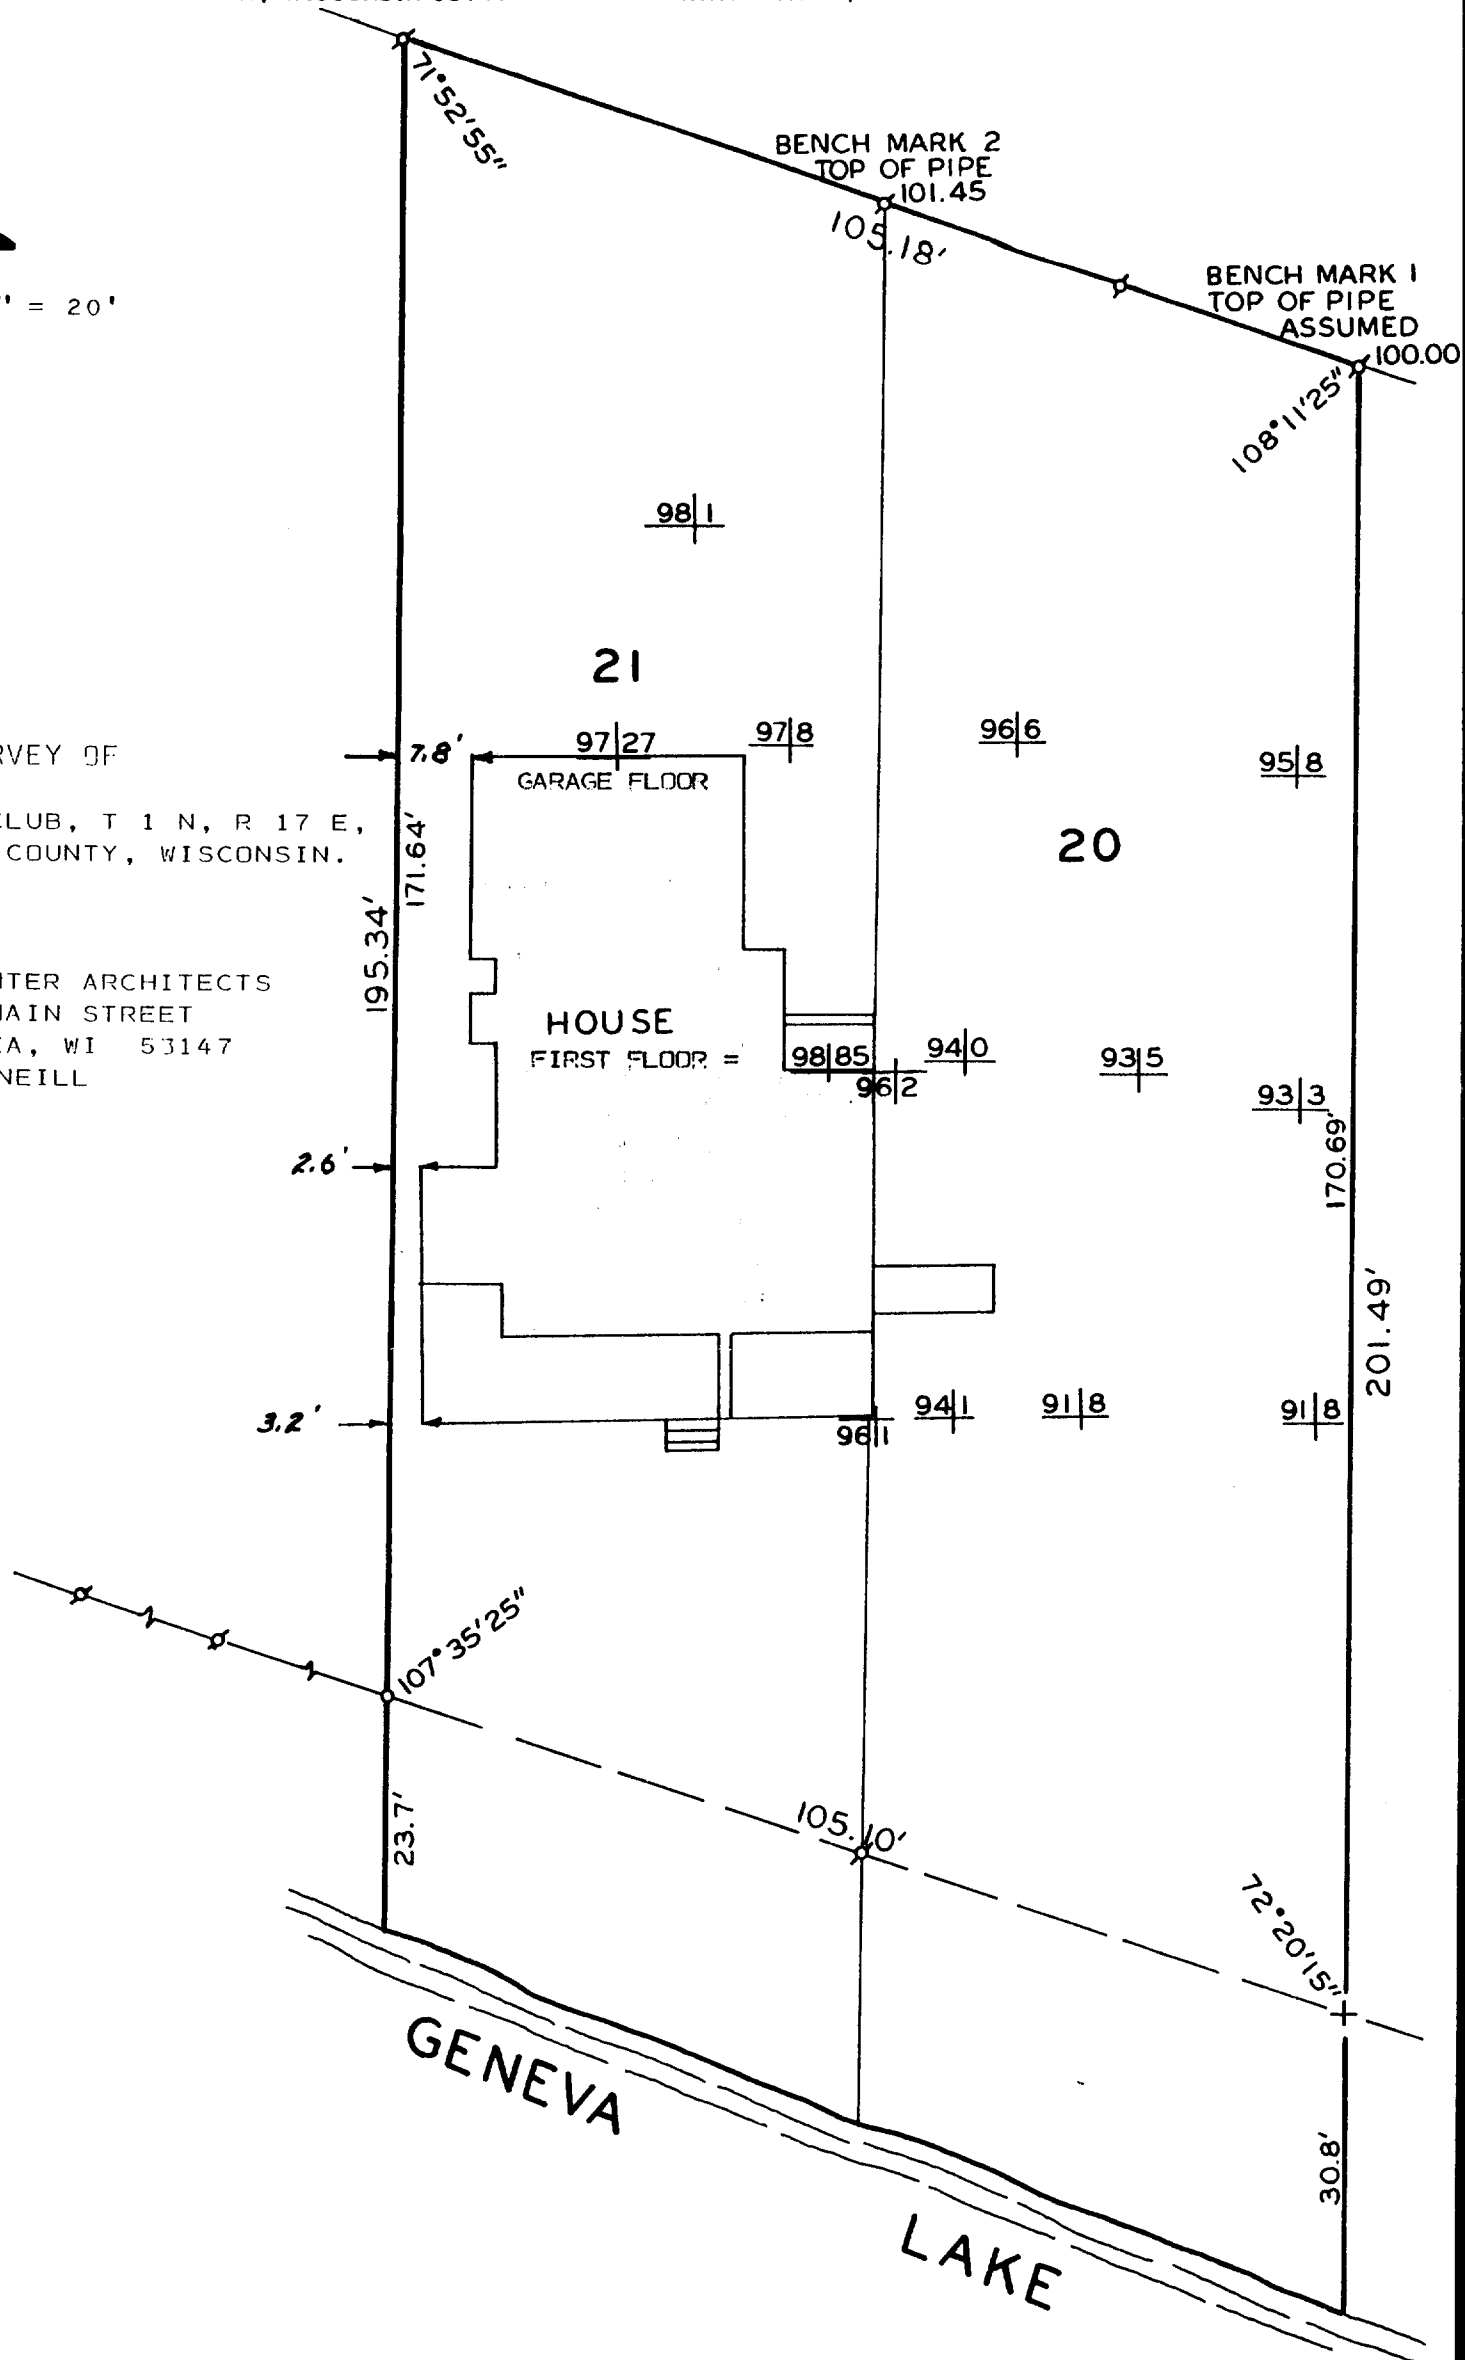

HAROLD H. KOLB
WISCONSIN REGISTERED LAND SURVEYOR, S-187
DATE NOVEMBER 17, 1988

117-952