



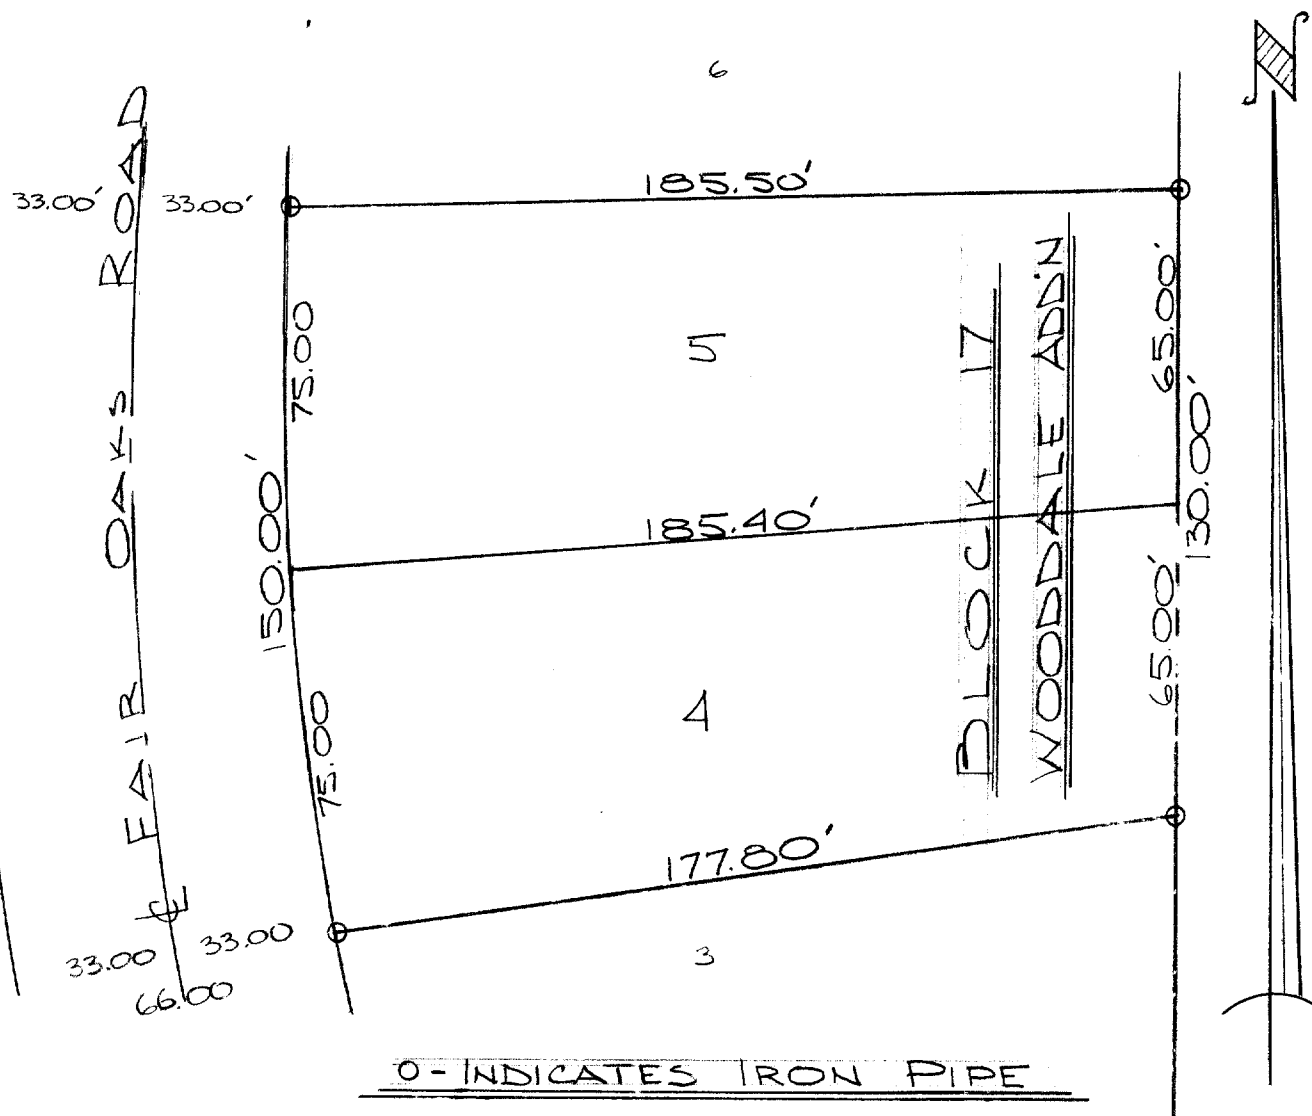

DESCRIPTION: Lots 4 and 5 of Block 17 of Wooddale Addition, located in Section 16, T. 1 N., R. 17 E., Walworth County, Wisconsin.

CERTIFICATE: I, James F. Biagi, surveyor, do hereby certify that I have surveyed the property hereon described.

Sept. 27, 1968.

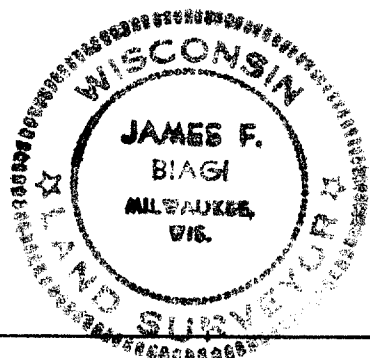

James F. Biagi, RLS 272