


**WALWORTH COUNTY  
SURVEYING & MAPPING**

727 HENRY STREET  
LAKE GENEVA, WISCONSIN  
414-248-0505

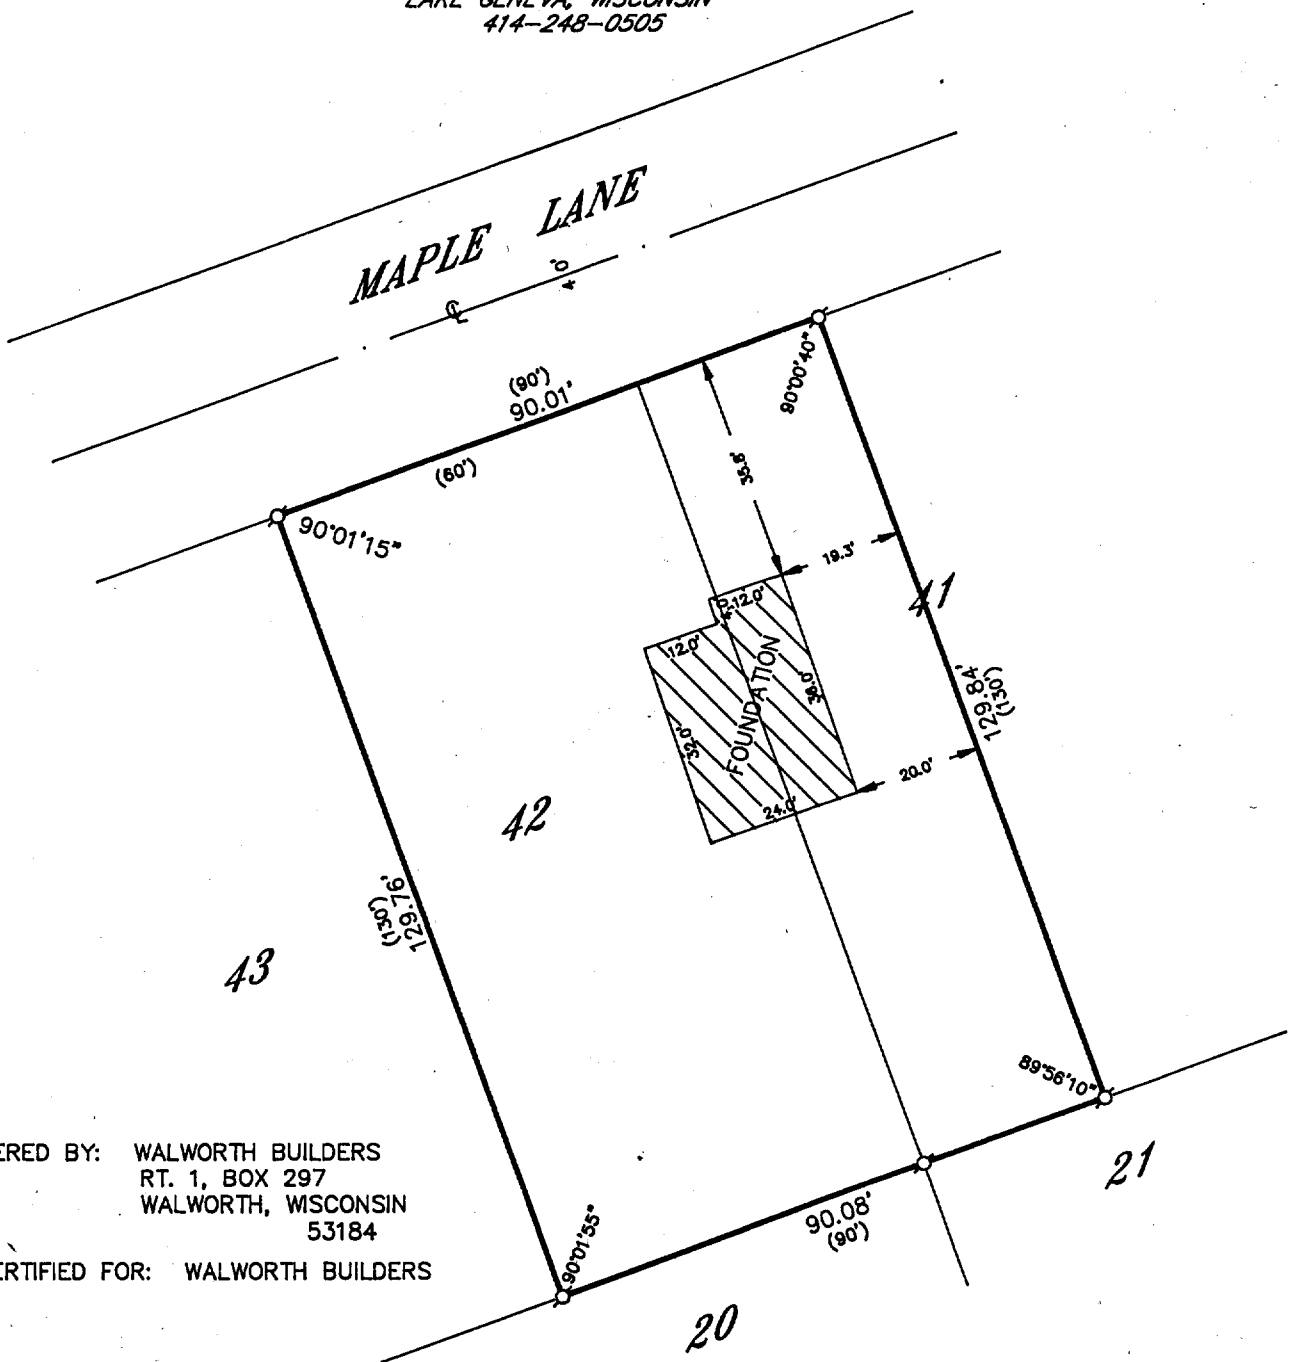

ORDERED BY: WALWORTH BUILDERS  
RT. 1, BOX 297  
WALWORTH, WISCONSIN  
53184

RECERTIFIED FOR: WALWORTH BUILDERS

**PLAT OF SURVEY OF**

THE LOCATION OF A PROPOSED RESIDENCE ON LOT 42 AND THE WESTERLY 1/2 OF LOT 41 OF THE BIRCHES 2ND ADDITION, LOCATED IN T 1 N, R 17 E, WALWORTH COUNTY, WISCONSIN.

I HEREBY CERTIFY THAT I HAVE SURVEYED THE ABOVE DESCRIBED PROPERTY AND THAT THE ABOVE MAP IS A TRUE REPRESENTATION THEREOF AND SHOWS THE SIZE AND LOCATION OF THE PROPERTY, ITS EXTERIOR BOUNDARIES, THE LOCATION OF ALL VISIBLE STRUCTURES AND DIMENSIONS OF ALL PRINCIPAL BUILDINGS THEREON, BOUNDARY FENCES, APPARENT EASEMENTS, ROADWAYS AND VISIBLE ENCROACHMENTS, IF ANY, TO THE BEST OF MY KNOWLEDGE AND BELIEF.


THIS SURVEY IS MADE FOR THE USE OF THE PRESENT OWNERS OF THE PROPERTY AND ALSO THOSE WHO PURCHASE, MORTGAGE OR GUARANTEE THE TITLE THERETO WITHIN ONE (1) YEAR FROM DATE HEREOF.

*Robert M. Baerenwald*  
ROBERT M. BAERENWALD  
WISCONSIN REGISTERED LAND SURVEYOR, S-1508

REVISED: JAN. 23, 1991  
DATE JOB NO. 1269

NOTE: THIS IS NOT A CERTIFIED COPY UNLESS SEALED.

RECEIVED  
JAN 16 1992

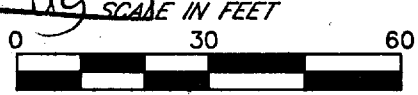

**LEGEND**  
S- IRON PIPE FOUND  
R- IRON ROD FOUND  
■- CONCRETE MONUMENT FOUND  
○- IRON PIPE PLACED  
()- RECORDED AS

117-1185

IBA2-6A