


LOCATION & ELEVATIONS FOR FUTURE HOME, OF
WILLIAM HARDT
FOREST REST SUBDIVISION

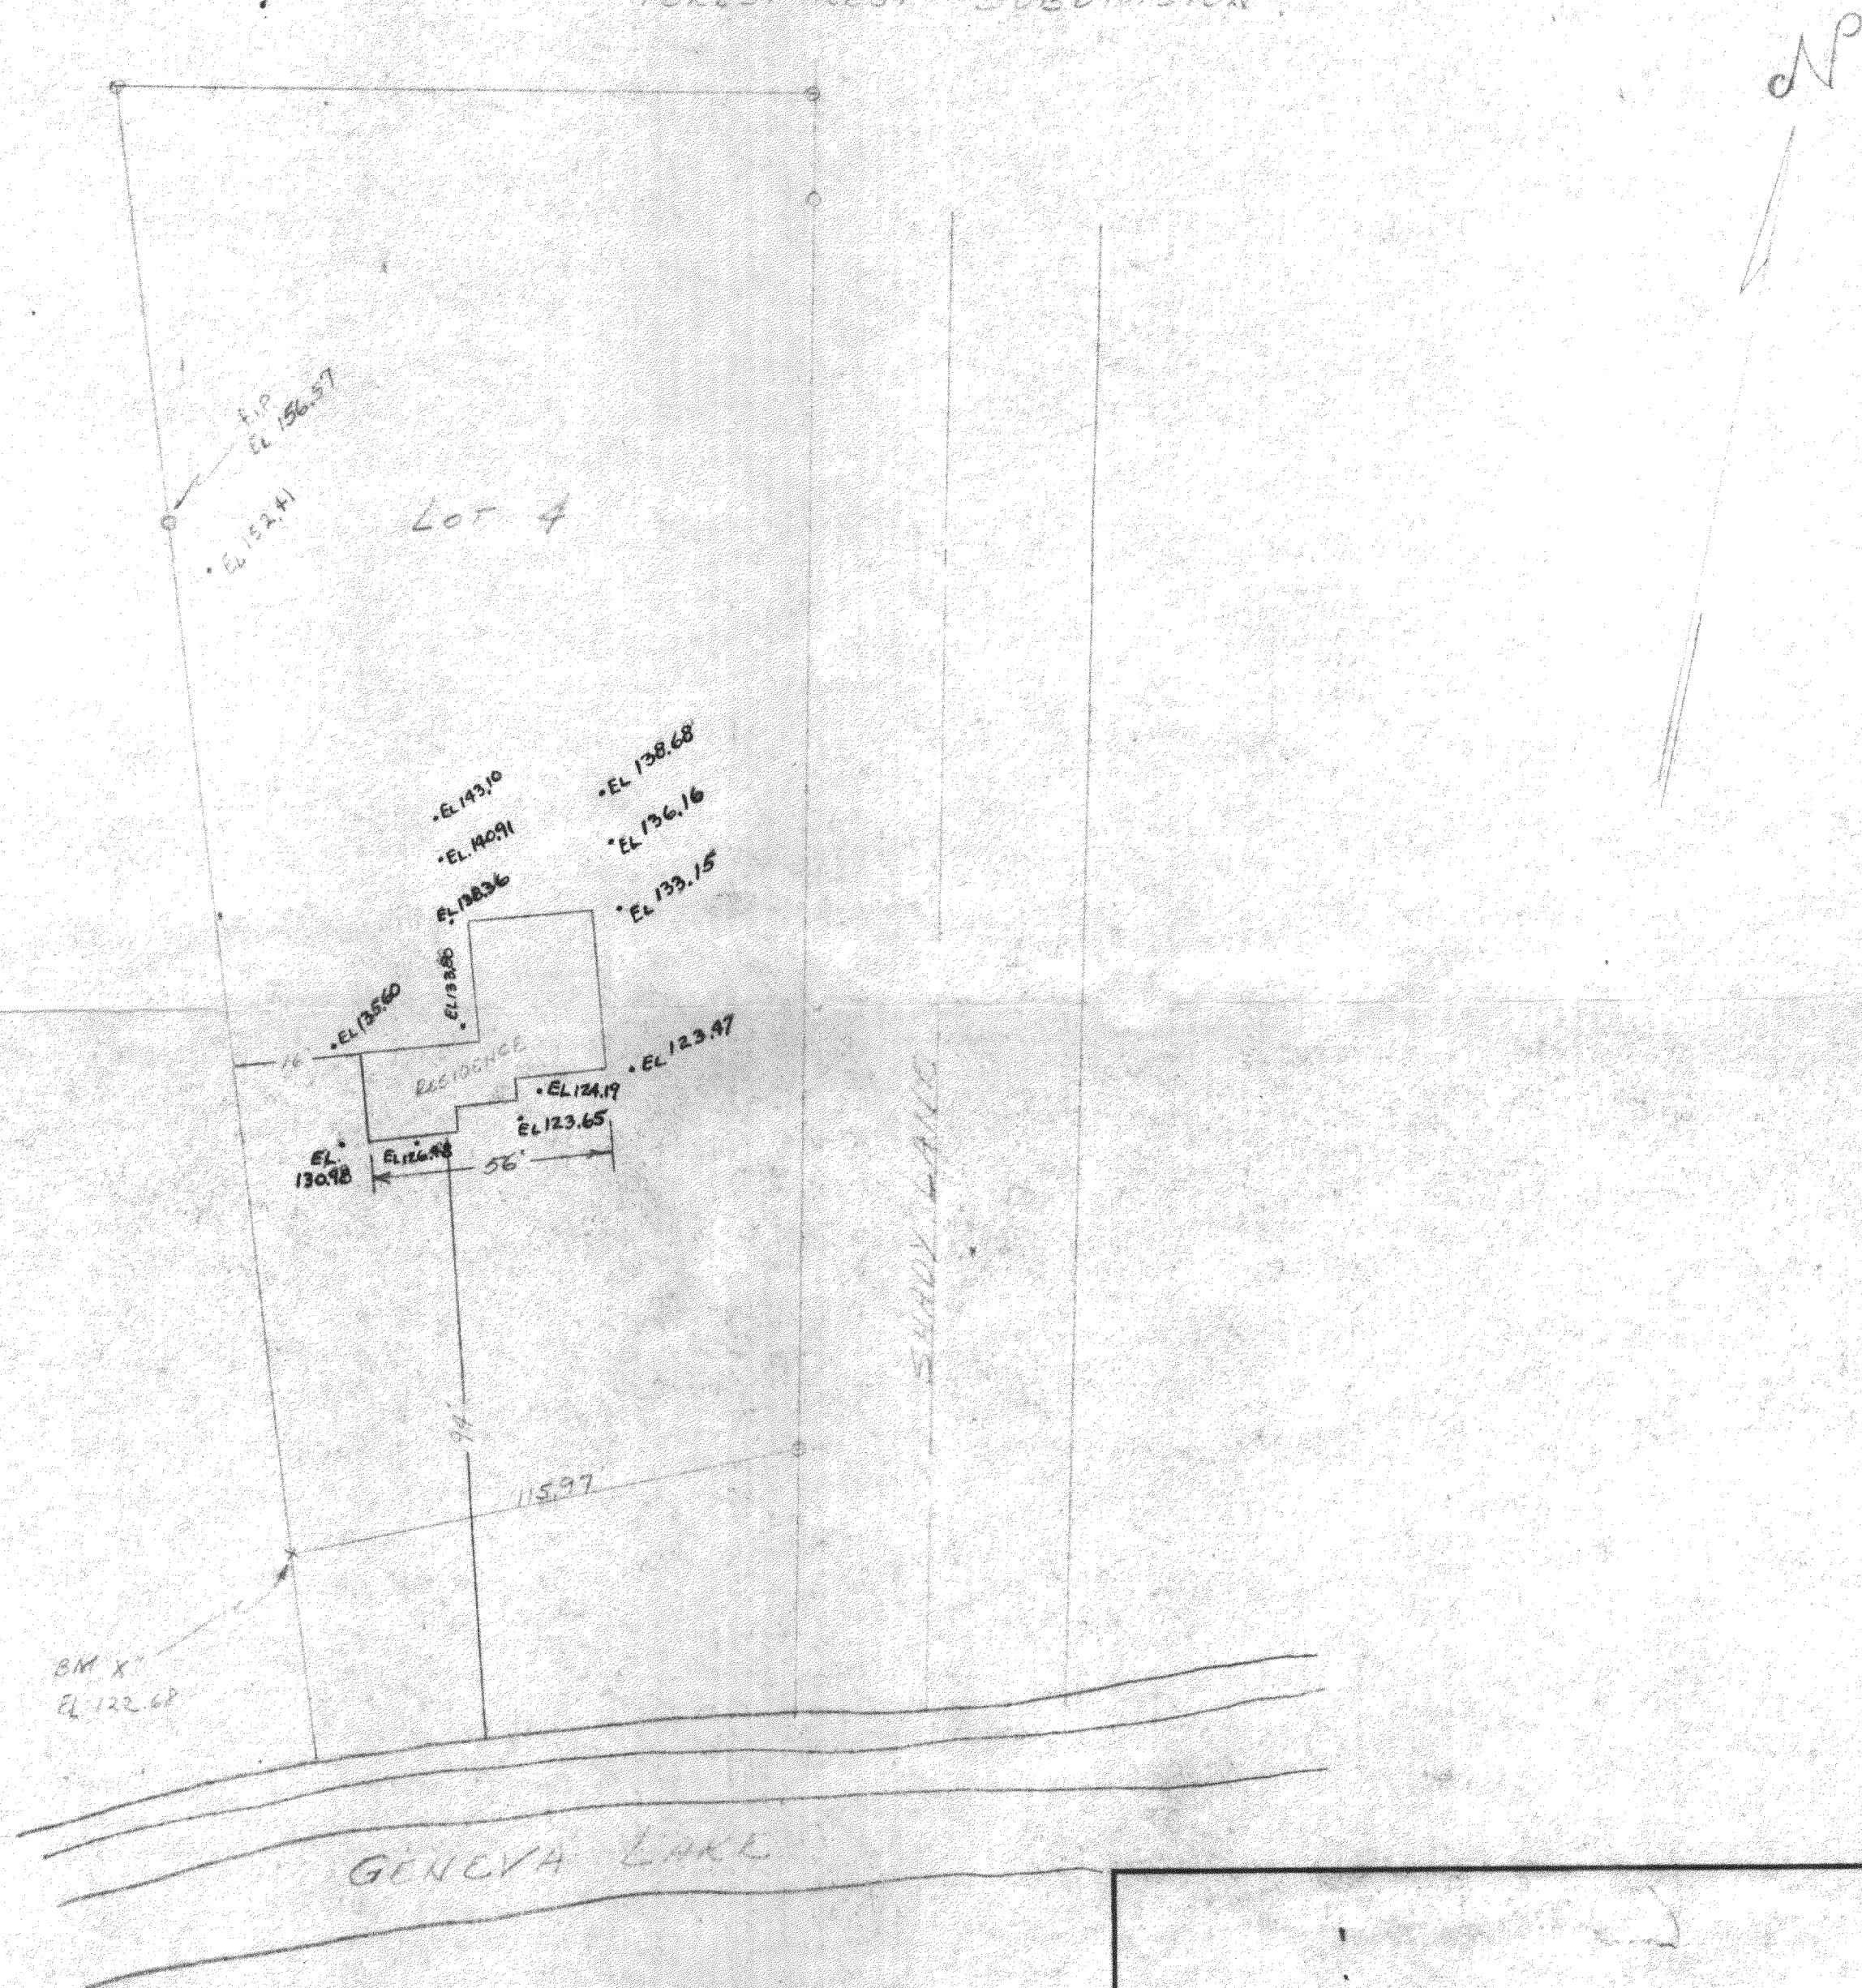

- ELEVATION STAKES
- x CROSS CUT IN CONCRETE STAKES
- o IRON PIPE

IFR-4 - proposed
Bldg location

DATE 3 Aug 59