

PLAT OF SURVEY
-OF-

LOTS 22 AND 23 OF PARADISE VISTA, ACCORDING TO THE RECORDED PLAT THEREOF. SAID LAND BEING IN THE TOWN OF LINN, WALWORTH COUNTY, WISCONSIN.

PREPARED FOR: COLDWELL BANKER


"I hereby certify that I have surveyed the above described property and that the above map is a correct representation thereof and shows the size and location of the property, its exterior boundaries, the location of all visible structures and dimensions of all principal buildings thereon, boundary fences, apparent easements, roadways and encroachments, if any."

"This survey is made for the use of the present owners of the property, and those who purchase, mortgage, or guarantee the title thereto within one year from date hereof."





B.W. SURVEYING, INC.

412 N. PINE STREET
 BURLINGTON, WI 53105
 (262)-767-0225

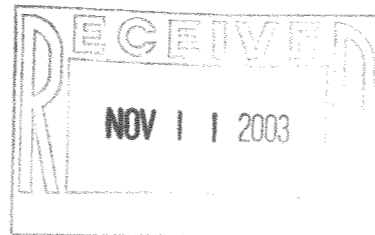

WILMOT
 40' WIDE
BOULEVARD

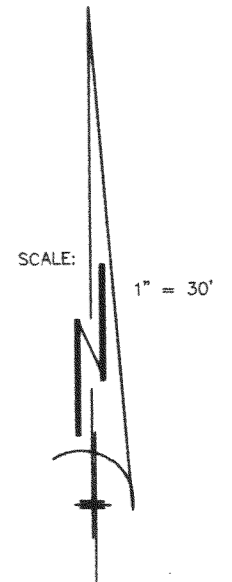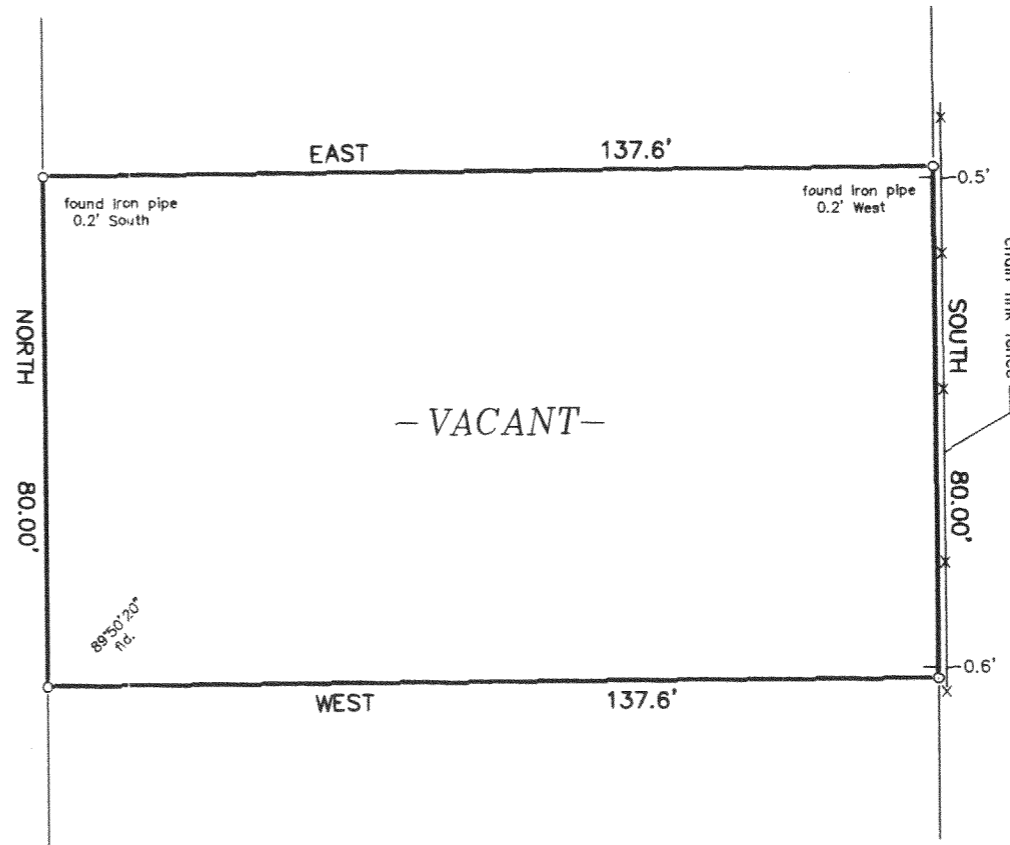

LEGEND
 ○ FOUND IRON PIPE



THIS IS NOT AN ORIGINAL PRINT
 UNLESS THIS SEAL IS RED.

Robert J. Wetzel
 ROBERT J. WETZEL S-1778

AUGUST 25, 2003
 DATE

6040
 JOB NUMBER

IPV-3E

117-2384