

PLAT OF SURVEY


ASSIGNED THE WESTERLY LINE OF LOT 6
N18°12'00"W

Lot 6 and part of Lot 7, Block 1, Forest Rest, a subdivision located in Section 2, T1N, R17E, and in Section 35, T2N, R17E, Walworth County, Wisconsin, and described as follows, to-wit: Beginning at the Southwest corner of said Lot 7; thence North 22° 16' West 154.68 feet; thence South 36° 46' East 100.96 feet; thence South 0° 52' East 59.87 feet to the place of beginning.

EXCEPTING therefrom the following described parcel: Beginning at the Northeast corner of said Lot 6; thence South 22° 16' East 107.21 feet; thence North 67° 16' West 28.28 feet; thence North 22° 16' West 79.26 feet; thence North 46° 24' East 21.47 feet to the place of beginning.

TOGETHER WITH a non-exclusive easement for ingress and egress as set forth in a Grant of Easement and Agreement between Adjoining Owners for Maintenance and Repair of Common Roadway Easement and Well recorded in Volume 285 of Records, page 653, as Document No. 79124.

Tax Key No. IFR 00006

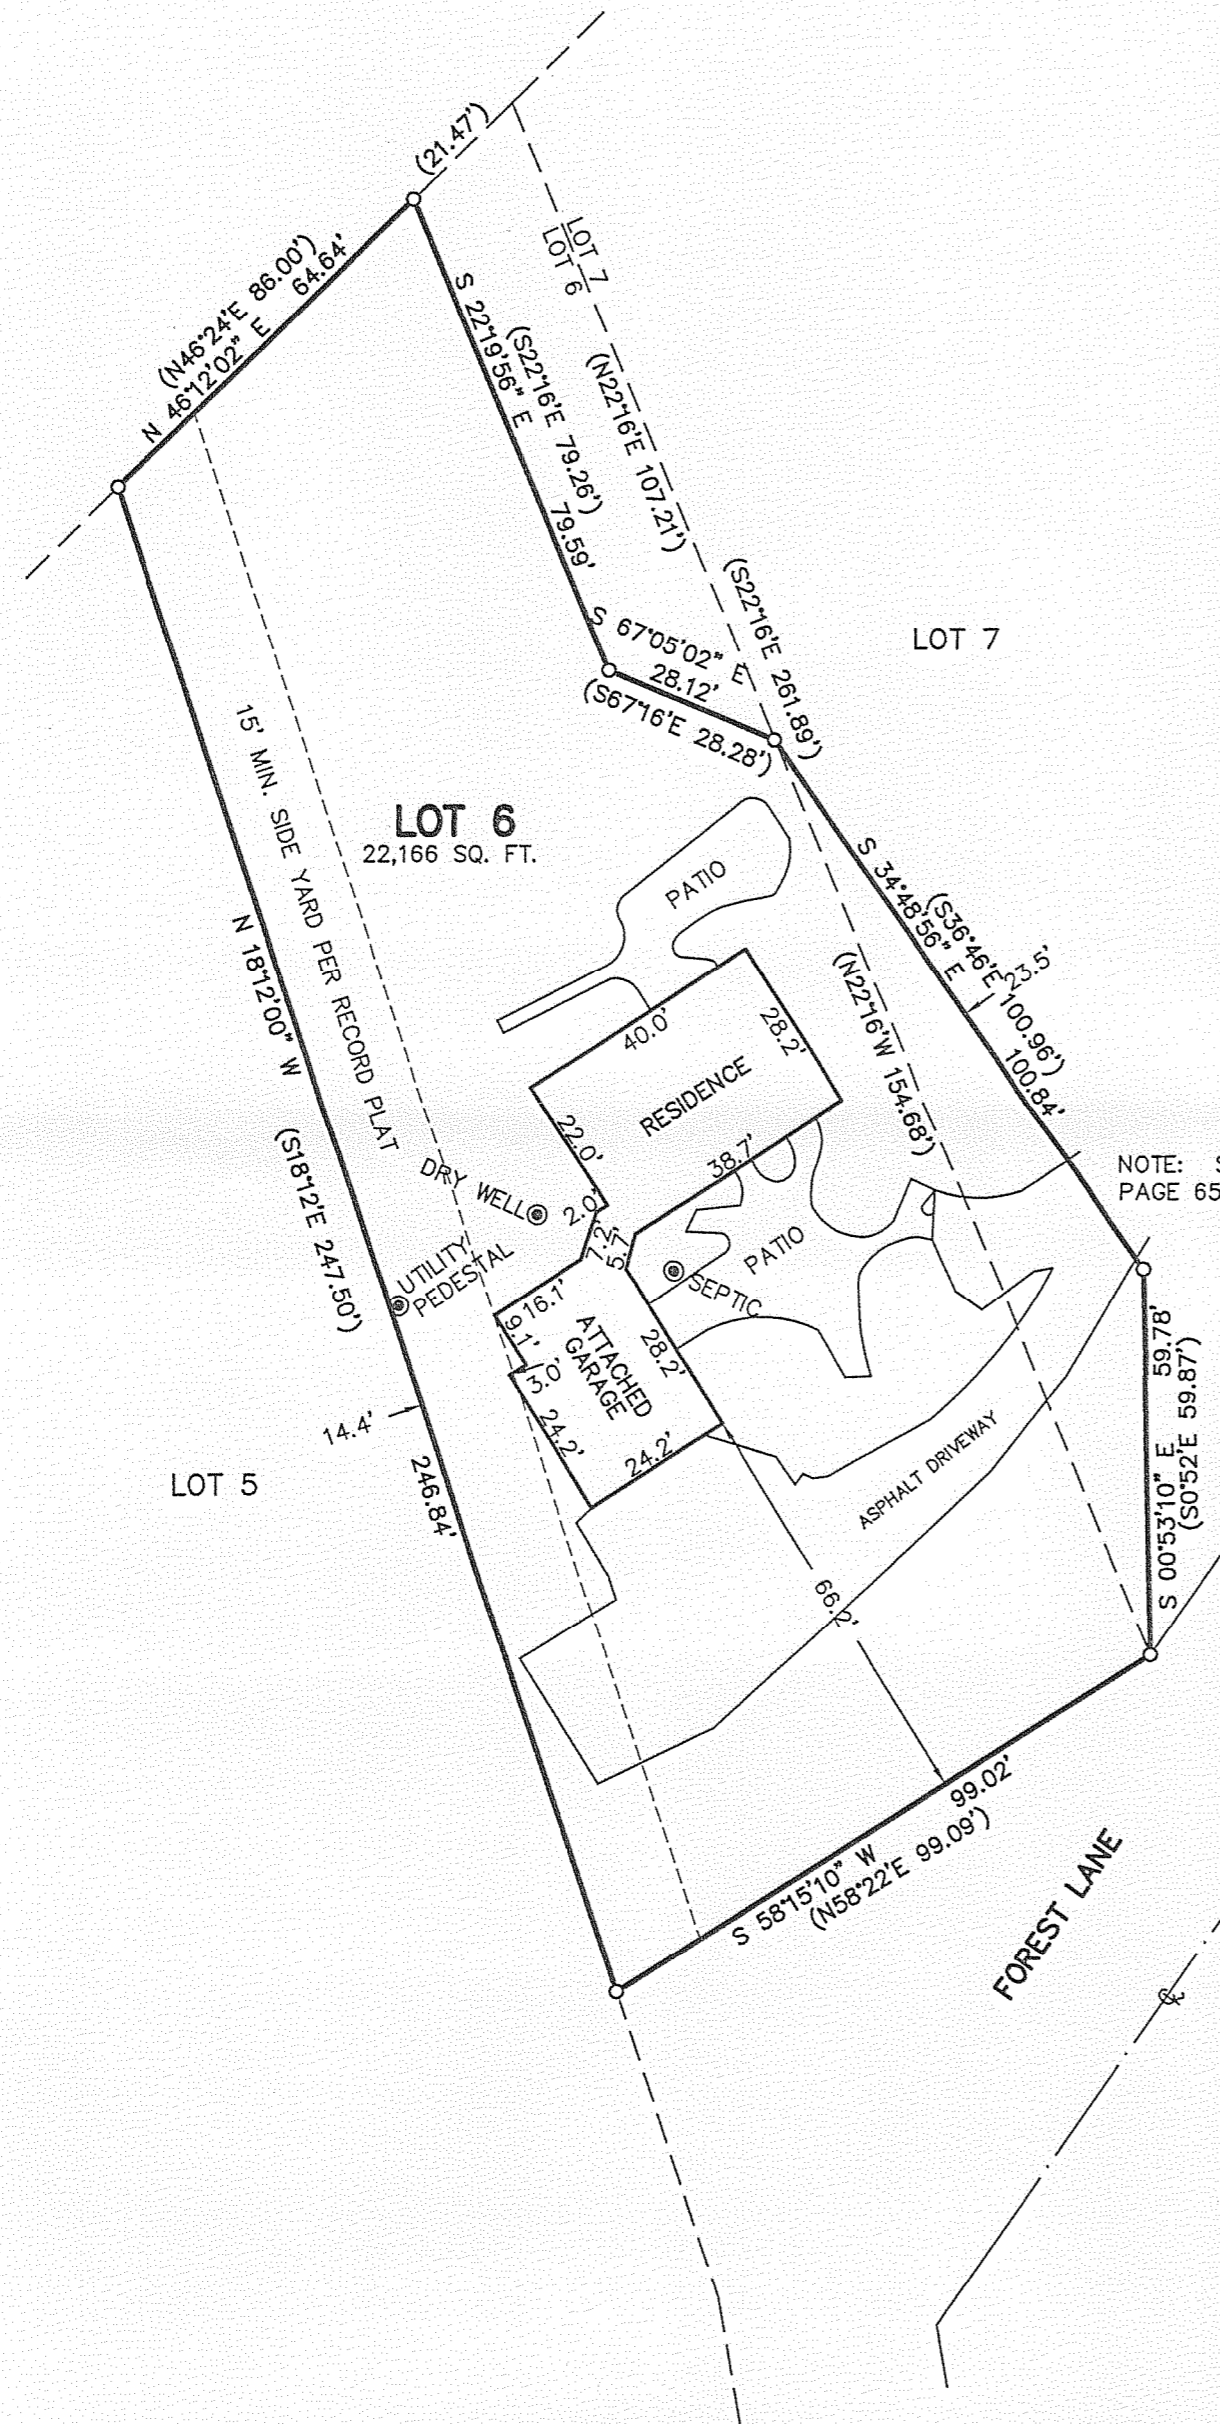

NOTE: SEE DRIVEWAY AGREEMENT, VOL. 285, PAGE 653, DOC. NO. 79124

LEGEND
 ○—FOUND IRON PIPE STAKE
 □—FOUND CONCRETE MONUMENT
 (xxx)—RECORDED AS

NOTE: DOCUMENT NO. 599197 GRANTS LOT 6 RIGHTS TO A COMMON WELL SERVING LOTS 6, 7, & 8 TOGETHER WITH THE RIGHT TO MAINTAIN LINES FROM THE WELL TO LOT 6.

RECEIVED
 OCT 19 2009
 By: *[Signature]*

NOTE: COPIES OF THIS MAP TO WHICH THE FOLLOWING CERTIFICATE WILL APPLY SHOW THE SURVEYOR'S ORIGINAL SEAL AND SIGNATURE IN RED INK. COPIES BY ANY OTHER MEANS MAY HAVE ALTERATIONS WHICH DO NOT REPRESENT THE SURVEYOR'S WORK PRODUCT.

I HEREBY CERTIFY THAT THE ABOVE DESCRIBED PROPERTY HAS BEEN SURVEYED UNDER MY DIRECTION AND THAT THE ABOVE MAP IS A TRUE REPRESENTATION THEREOF AND SHOWS THE SIZE AND LOCATION OF THE PROPERTY, ITS EXTERIOR BOUNDARIES, THE LOCATION OF ALL VISIBLE STRUCTURES, AND DIMENSIONS OF ALL PRINCIPLE BUILDINGS THEREON, BOUNDARY FENCES, APPARENT EASEMENTS, ROADWAYS, AND VISIBLE ENCROACHMENTS, IF ANY. THIS SURVEY IS MADE FOR THE USE OF THE PRESENT OWNERS OF THE PROPERTY, AND ALSO THOSE WHO PURCHASE, MORTGAGE, OR GUARANTEE THE TITLE THERETO WITHIN ONE YEAR FROM THE DATE HEREOF.



DATED: 7/31/2009

[Signature]
 PETER S. GORDON

MAP SCALE IN FEET — ORIGINAL 1"=30'

IFR-6

117-3089



PLAT OF SURVEY

WORK ORDERED BY —
 KEEFE REAL ESTATE
 751 GENEVA PARKWAY
 LAKE GENEVA, WI 53147

FARRIS, HANSEN & ASSOCIATES, INC.
 ENGINEERING — ARCHITECTURE — SURVEYING
 7 RIDGWAY COURT P.O. BOX 437
 ELKHORN, WISCONSIN 53121
 OFFICE: (262) 723-2098 FAX: (262) 723-5886

REVISIONS

PROJECT NO.
 7956
 DATE:
 07/31/2009
 SHEET NO.
 1 OF 1