

PLAT OF SURVEY

ASSIGNED THE WESTERLY LINE OF LOT 6
N 18°12'00" W


Lot 6 and part of Lot 7, Block 1, Forest Rest, a subdivision located in Section 2, T1N, R17E, and in Section 35, T2N, R17E, Walworth County, Wisconsin, and described as follows, to-wit: Beginning at the Southwest corner of said Lot 7; thence North 22° 16' West 154.68 feet; thence South 36° 46' East 100.96 feet; thence South 0° 52' East 59.87 feet to the place of beginning.

EXCEPTING therefrom the following described parcel: Beginning at the Northeast corner of said Lot 6; thence South 22° 16' East 107.21 feet; thence North 67° 16' West 28.28 feet; thence North 22° 16' West 79.26 feet; thence North 46° 24' East 21.47 feet to the place of beginning.

TOGETHER WITH a non-exclusive easement for ingress and egress as set forth in a Grant of Easement and Agreement between Adjoining Owners for Maintenance and Repair of Common Roadway Easement and Well recorded in Volume 285 of Records, page 653, as Document No. 79124.

Tax Key No. IFR 00006

NOTE: SEE DRIVEWAY AGREEMTN, VOL. 285,
PAGE 653, DOC. NO. 79124.

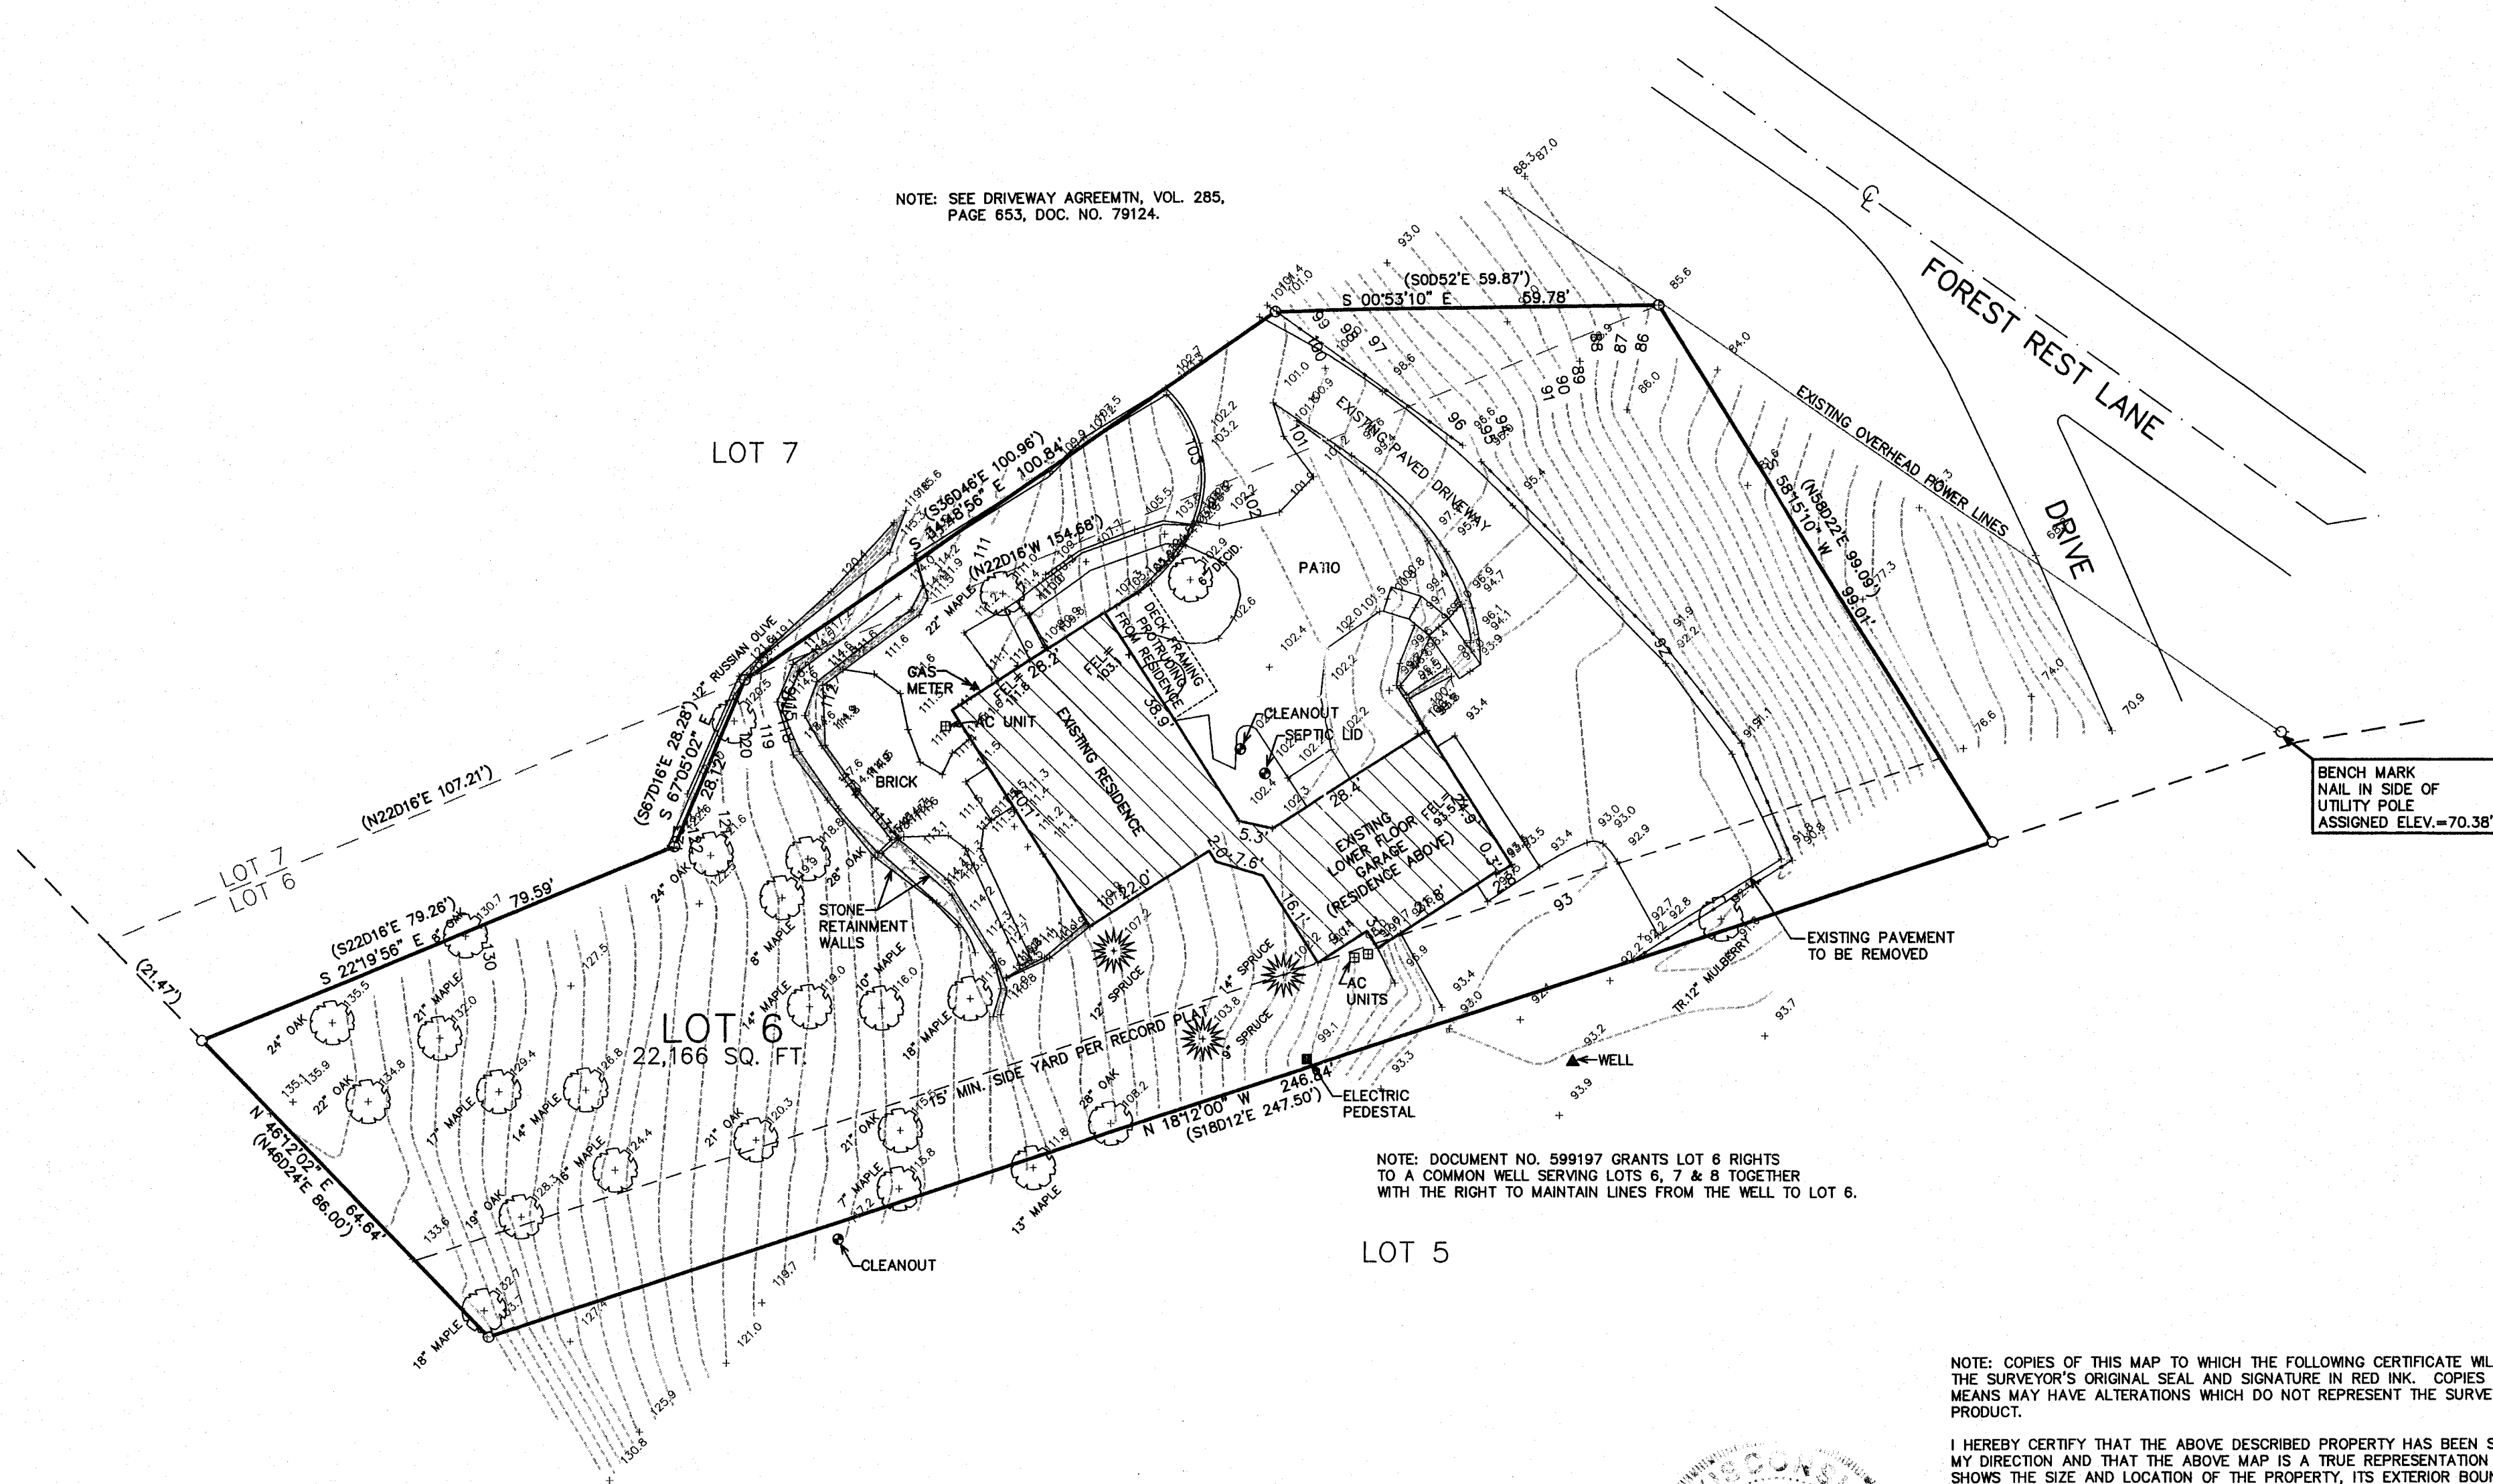

BENCH MARK
NAIL IN SIDE OF
UTILITY POLE
ASSIGNED ELEV.=70.38'

NOTE: DOCUMENT NO. 599197 GRANTS LOT 6 RIGHTS
TO A COMMON WELL SERVING LOTS 6, 7 & 8 TOGETHER
WITH THE RIGHT TO MAINTAIN LINES FROM THE WELL TO LOT 6.


NOTE: COPIES OF THIS MAP TO WHICH THE FOLLOWING CERTIFICATE WILL APPLY SHOW
THE SURVEYOR'S ORIGINAL SEAL AND SIGNATURE IN RED INK. COPIES BY ANY OTHER
MEANS MAY HAVE ALTERATIONS WHICH DO NOT REPRESENT THE SURVEYOR'S WORK
PRODUCT.

I HEREBY CERTIFY THAT THE ABOVE DESCRIBED PROPERTY HAS BEEN SURVEYED UNDER
MY DIRECTION AND THAT THE ABOVE MAP IS A TRUE REPRESENTATION THEREOF AND
SHOWS THE SIZE AND LOCATION OF THE PROPERTY, ITS EXTERIOR BOUNDARIES, THE
LOCATION OF ALL VISIBLE STRUCTURES, AND DIMENSIONS OF ALL PRINCIPLE
BUILDINGS THEREON, BOUNDARY FENCES, APPARENT EASEMENTS, ROADWAYS, AND
VISIBLE ENCROACHMENTS, IF ANY. THIS SURVEY IS MADE FOR THE USE OF THE
PRESENT OWNERS OF THE PROPERTY, AND ALSO THOSE WHO PURCHASE, MORTGAGE, OR
GUARANTEE THE TITLE THERETO WITHIN ONE YEAR FROM THE DATE HEREOF.


DATED: 7/31/2009

REVISED 6/17/2014 TO SHOW
EXISTING IMPROVEMENTS

RECEIVED
SEP 5 2014
By *[Signature]*

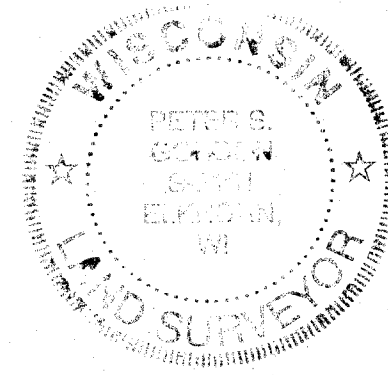

[Signature]
PETER S. GORDON

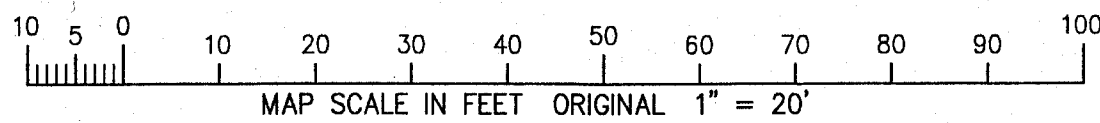

WORK ORDERED BY -
C/O DESIGNS BY MALDA
5050 NEWPORT SUITE 6
ROLLING MEADOWS, IL 60008

FARRIS, HANSEN & ASSOCIATES, INC.
ENGINEERING - ARCHITECTURE - SURVEYING
7 RIDGWAY COURT P.O. BOX 437
ELKHORN, WISCONSIN 53121
OFFICE: (262) 723-2098 FAX: (262) 723-5886

REVISIONS

PROJECT NO.
7956.09

DATE:
10/26/2011

SHEET NO.
1 OF 1

IFR-6 117-3673

JUN 17 2014

6/17/2014 X:\Projects\7956\Draw\Survey