


# HAROLD H. KOLB

REGISTERED PROFESSIONAL LAND SURVEYOR  
LAKE GENEVA, WISCONSIN

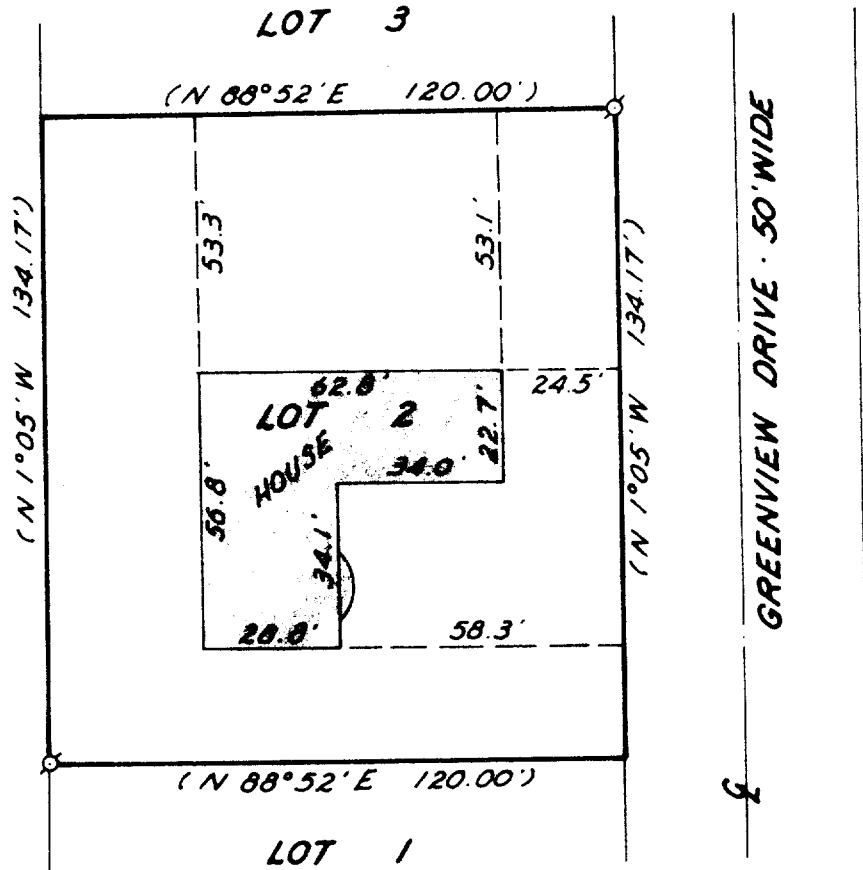

PLAT OF

HOUSE LOCATION ON LOT 2, SUNSET HILLS  
SHORES, T 1 N, R 17 E, WALWORTH COUNTY,  
WISCONSIN.

OWNER: FRANK LEWIS

N



SCALE: 1"=40'

## LEGEND

- φ - IRON PIPE FOUND
- - IRON PIPE PLACED
- - CONCRETE MONUMENT
- (x) - SPIKE
- ( ) - Platted As

I, Eugene Blomquist, DO HEREBY CERTIFY THAT I HAVE  
SURVEYED THE PROPERTY HEREON DESCRIBED ACCORDING  
TO THE OFFICIAL RECORDS, AND THAT THE PLAT HEREON  
IS A CORRECT REPRESENTATION OF THE LOT LINES.

*Eugene A. Blomquist*  
EUGENE A. BLOMQUIST  
WISCONSIN REGISTERED LAND SURVEYOR, S-1279

DATE Sept. 21, 1916

Est. 2

117-541