

HAROLD H. KOLB

REGISTERED PROFESSIONAL LAND SURVEYOR
LAKE GENEVA, WISCONSIN



PLAT OF SURVEY OF

LOT 15, ELGIN CLUB, T1N, R17E,
WALWORTH COUNTY, WISCONSIN.

OWNER: BARBARA BRADY

LOT 15

LOT 14

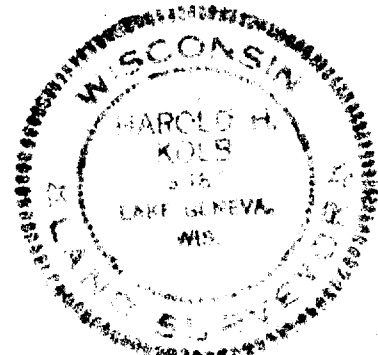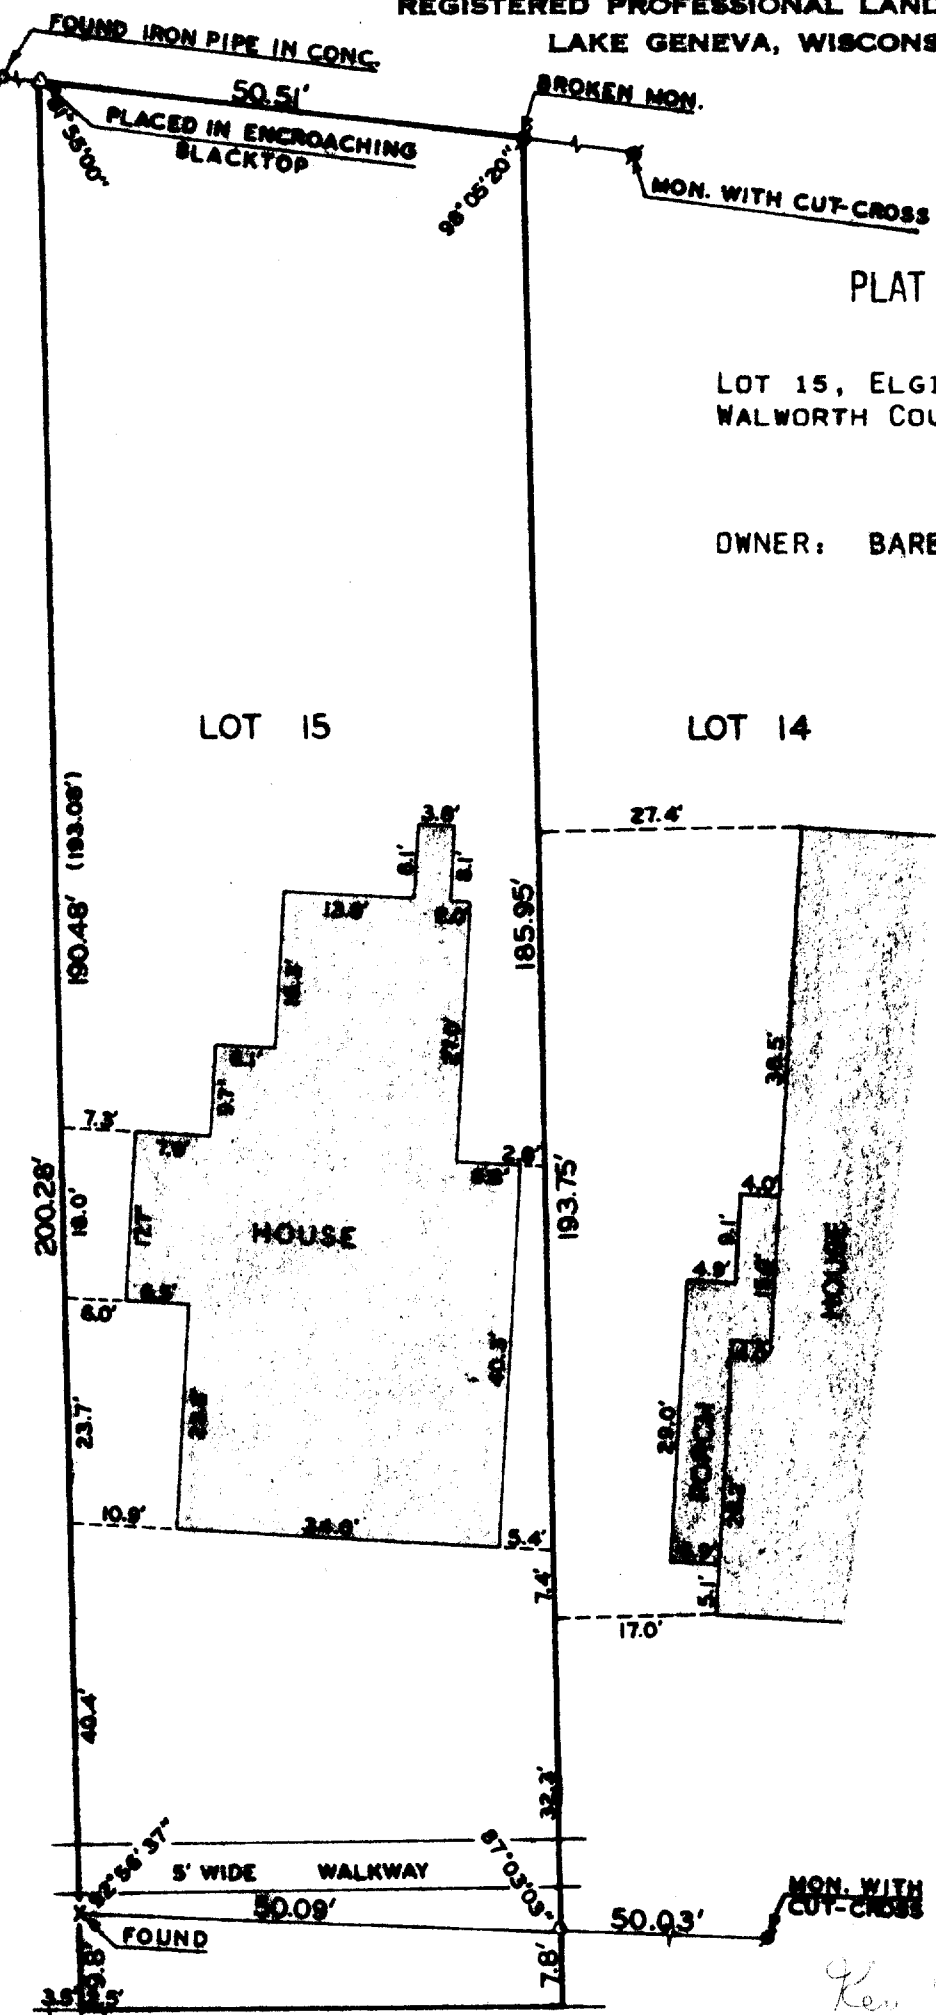

Key No. 7101

I, HAROLD H. KOLB, DO HEREBY CERTIFY THAT I HAVE SURVEYED THE PROPERTY HEREON DESCRIBED ACCORDING TO THE OFFICIAL RECORDS, AND THAT THE PLAT HEREON IS A CORRECT REPRESENTATION OF THE LOT LINES.

Harold H. Kolb
HAROLD H. KOLB
WISCONSIN REGISTERED LAND SURVEYOR, S-187
DATE *Aug. 19, 1977*

GENEVA LAKE



SCALE: 1"=20'
LEGEND

- - IRON PIPE PLACED
- - STONE MONUMENT FOUND
- △ - RAILROAD SPIKE
- X - CUT-CROSS
- () - AS PLATTED
- ⊖ - IRON PIPE FOUND

117-589