



**ABELL**  
**SURVEYING & MAPPING**  
 DELAVAN, WISCONSIN 53118  
 414-720-6787

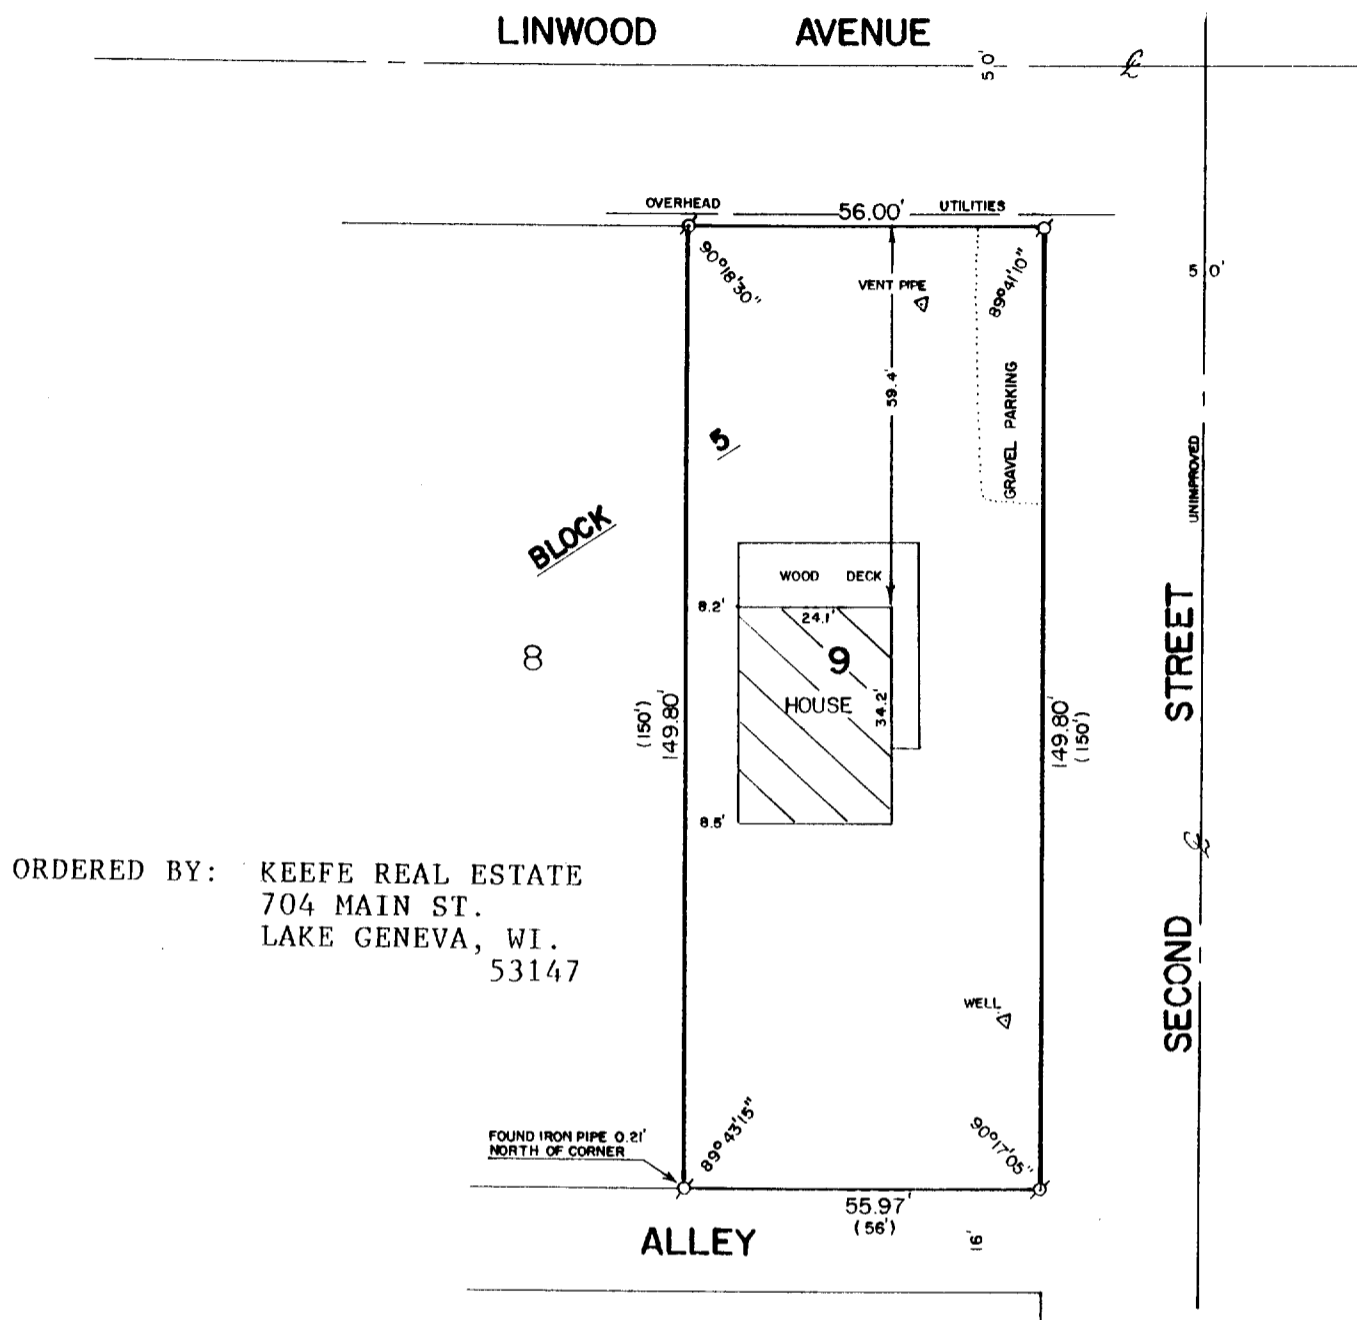

PLAT OF SURVEY OF

LOT 9, BLOCK 5 OF GENEVISTA, A SUBDIVISION  
 LOCATED IN T1N, R17E, WALWORTH COUNTY,  
 WISCONSIN.

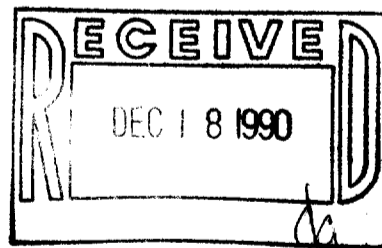

SCALE - 1"=30'

**LEGEND**

⊗ - IRON PIPE FOUND  
 ( ) - RECORDED AS

I HEREBY CERTIFY THAT I HAVE SURVEYED THE ABOVE DESCRIBED PROPERTY AND THAT THE ABOVE MAP IS A TRUE REPRESENTATION THEREOF AND SHOWS THE SIZE AND LOCATION OF THE PROPERTY, ITS EXTERIOR BOUNDARIES, THE LOCATION OF ALL VISIBLE STRUCTURES AND DIMENSIONS OF ALL PRINCIPAL BUILDINGS THEREON, BOUNDARY FENCES, APPARENT EASEMENTS, ROADWAYS AND VISIBLE ENCROACHMENTS, IF ANY, TO THE BEST OF MY KNOWLEDGE AND BELIEF.

THIS SURVEY IS MADE FOR THE USE OF THE PRESENT OWNERS OF THE PROPERTY, AND ALSO THOSE WHO PURCHASE, MORTGAGE, OR GUARANTEE THE TITLE THERETO WITHIN ONE (1) YEAR FROM DATE HEREOF.

*David F. Abell*

DAVID F. ABELL  
 WISCONSIN REGISTERED LAND SURVEYOR, S-1596

*June 20, 1990*

DATE: *June 20, 1990* JOB NUMBER: 90112  
 NOTE: THIS IS NOT A CERTIFIED COPY UNLESS SEALED.