



**ABELL**  
**SURVEYING & MAPPING**  
 DELAVAN, WISCONSIN 53115  
 414-728-6737

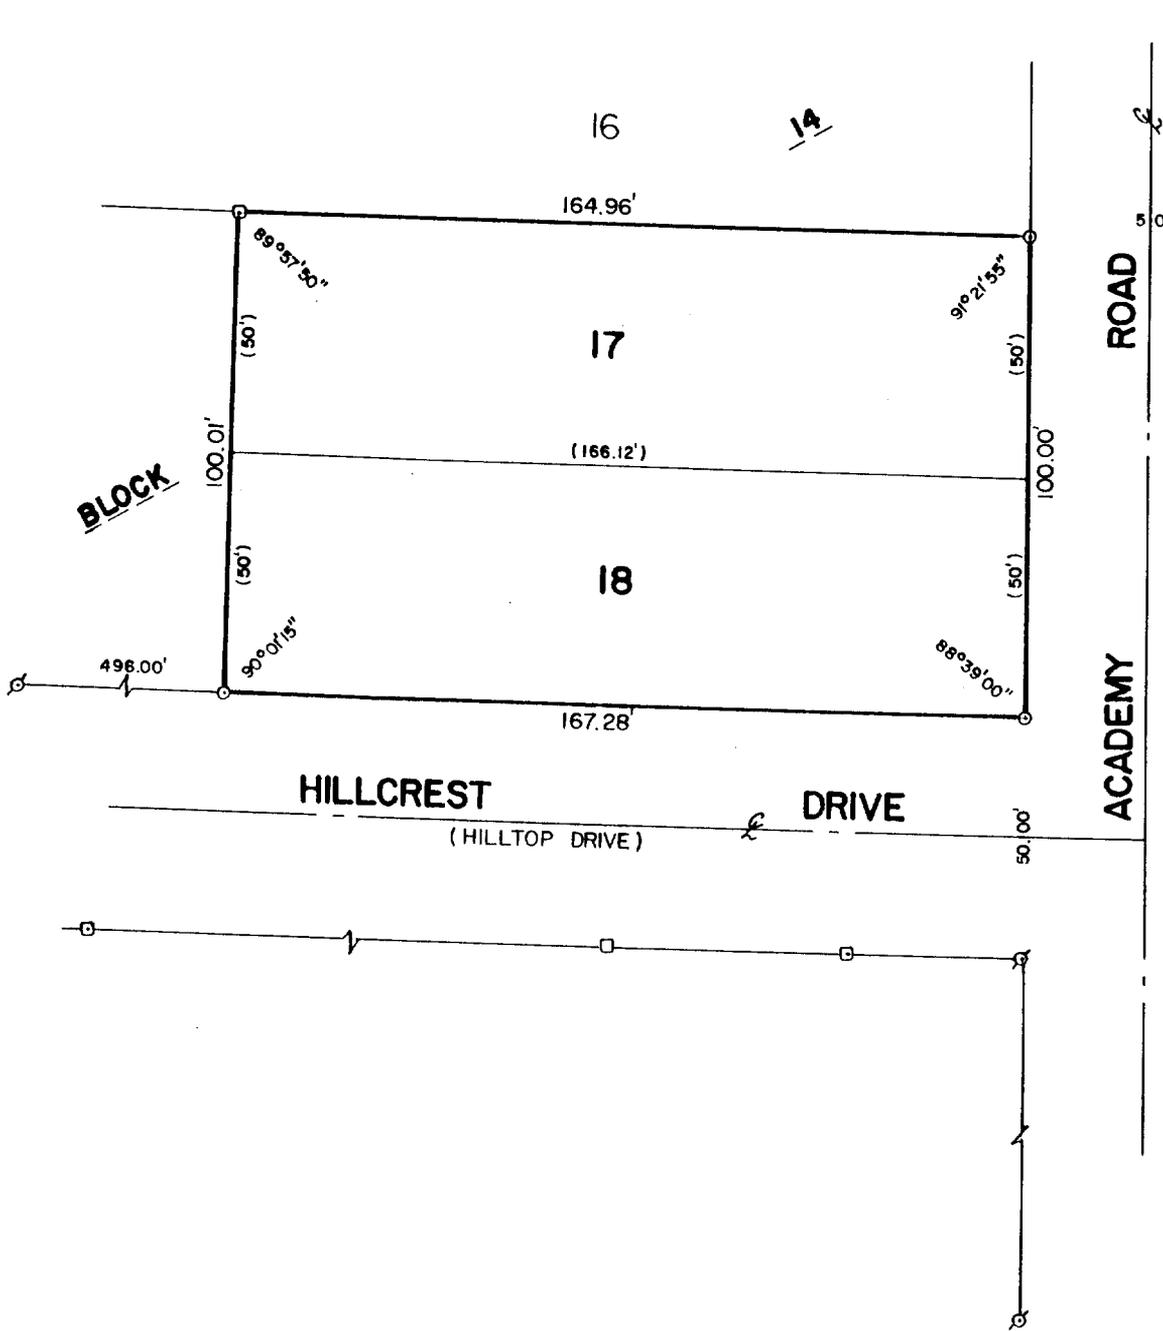

PLAT OF SURVEY OF

LOTS 17 AND 18, BLOCK 14, MAPLE HILLS "A" SUBDIVISION,  
 T1N, R17E, WALWORTH COUNTY, WISCONSIN.

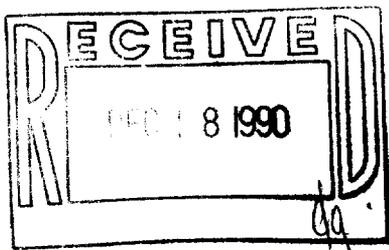

ORDERED BY: LOU KREPEL  
 4119 CHERRY ST.  
 DELAVAN, WI. 53115



SCALE - 1"=40'

**LEGEND**

- ⊕ - IRON PIPE FOUND
- - SQUARE IRON ROD FOUND
- - IRON ROD SET
- ( ) - RECORDED AS

I, DAVID F. ABELL, DO HEREBY CERTIFY THAT I HAVE SURVEYED THE PROPERTY HEREON DESCRIBED ACCORDING TO THE OFFICIAL RECORDS AND THAT THE PLAT HEREON IS A CORRECT REPRESENTATION OF THE PROPERTY LINES TO THE BEST OF MY KNOWLEDGE AND BELIEF.

*David F. Abell*  
 \_\_\_\_\_  
 DAVID F. ABELL  
 WISCONSIN REGISTERED LAND SURVEYOR, S-1596

*June 9, 1990*  
 \_\_\_\_\_  
 DATE JOB NUMBER - 90106

NOTE: THIS IS NOT A CERTIFIED COPY UNLESS SEALED.

117-1060

IMH 00287