

KOLB LAND CONSULTING, INC.  
 LAND SURVEYING • SUBDIVIDING • LAND PLANNING


929 WILLIAMS STREET LAKE GENEVA, WISCONSIN 53147 414-248-3697



SCALE: 1" = 60'

LEGEND

- ⊕ - IRON PIPE FOUND
- G - GARAGE
- ( ) - AS RECORDED

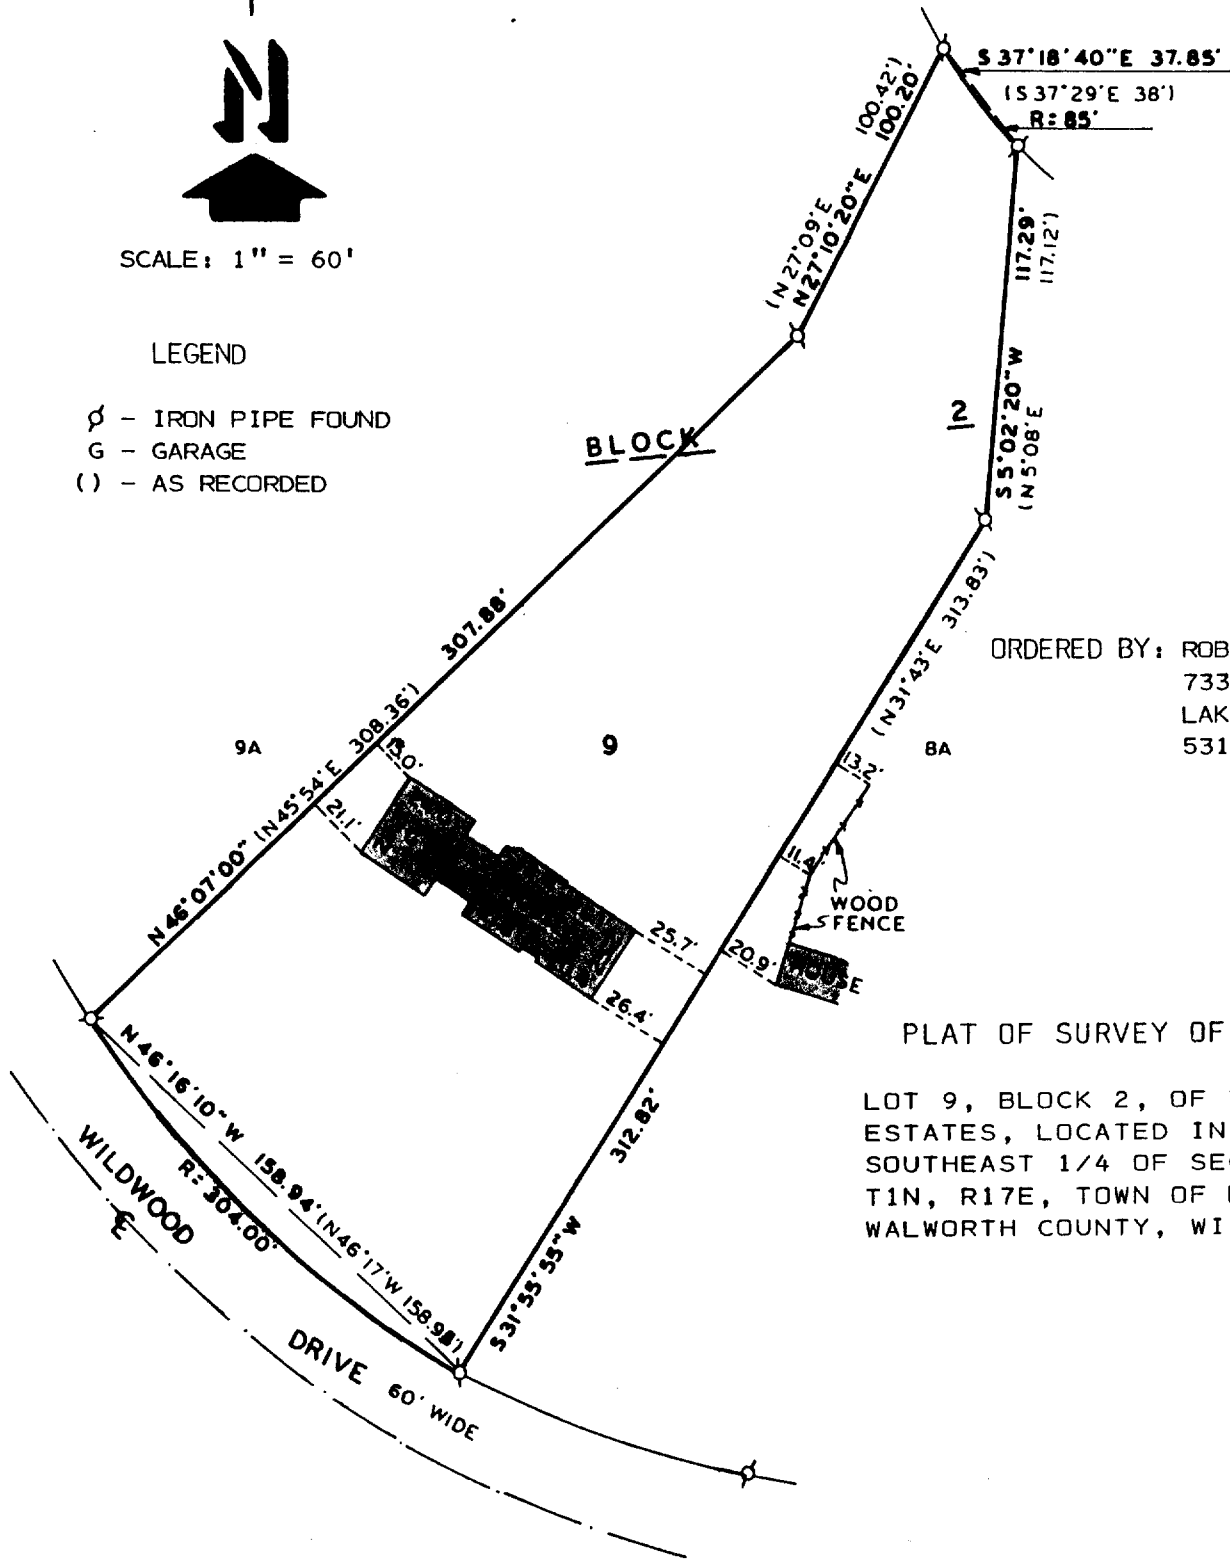


ORDERED BY: ROBERT FRANKLIN  
 733 WILDWOOD DR.  
 LAKE GENEVA, WI.  
 53147

PLAT OF SURVEY OF

LOT 9, BLOCK 2, OF TRINKE  
 ESTATES, LOCATED IN THE  
 SOUTHEAST 1/4 OF SECTION 10  
 T1N, R17E, TOWN OF LINN,  
 WALWORTH COUNTY, WISCONSIN.

I, HAROLD H. KOLB, DO HEREBY CERTIFY  
 THAT I HAVE SURVEYED THE PROPERTY  
 HEREON DESCRIBED ACCORDING TO THE  
 OFFICIAL RECORDS AND THAT THE PLAT  
 HEREON IS A CORRECT REPRESENTATION  
 OF THE LOT LINES AND THE PRINCIPAL  
 LINES OF THE BUILDINGS, TO THE BEST  
 OF MY KNOWLEDGE AND BELIEF.  
 SURVEY NOT VALID UNLESS SURVEYOR'S  
 SIGNATURE IS IN RED.

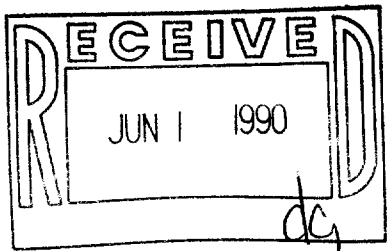

HAROLD H. KOLB

WISCONSIN REGISTERED LAND SURVEYOR, S-187

DATE OCTOBER 2, 1989

REVISED \_\_\_\_\_

REVISED \_\_\_\_\_