

Rt. 3, Box 273
Elkhorn, Wisconsin 53121
Phone: (414) 723-4260 (office)
(414) 723-4813 (residence)

LOTS 38-41 INCLUSIVE OF BLOCK "H" OF CISCO BEACH, A SUBDIVISION LOCATED IN SECTION 5, TOWN 1 NORTH, RANGE 17 EAST, WALWORTH COUNTY, WISCONSIN.



- FOUND IRON PIPE
FOUND IRON ROD
FOUND BRASS CAPPED MONUMENT
● FOUND CONCRETE MONUMENT
+ CHISEL CUT IN CONCRETE
● SET IRON ROD, 24" LONG, WEIGHING
1.5 LBS. LINEAL FT., 3/8" DIA.
● SET IRON ROD, 30" LONG, WEIGHING
4.5 LBS. LINEAL FT., 1-11/16" DIA.
(xx) RECORDED AS DIMENSION
—x—x—
EXISTING FENCE


SCALE: 1" = 20 FEET

"I hereby certify that I have surveyed the above described property and that the above map is a true representation thereof and shows the size and location of the property, its exterior boundaries, the location of all visible structures and dimensions of all principal buildings thereon, boundary fences, apparent easements, roadways and visible encroachments, if any."

"This survey is made for the use of the present owners of the property, and also those who purchase a mortgage or guarantee the title thereto within one year from date hereof."

hereof. *Kenneth B. Abernathy*
 KENNETH B. ABERNATHY, JR.
 WISCONSIN REGISTERED LAND SURVEYOR,
 S-1594

Date: MAY 24, 1991 Job No. 91.517

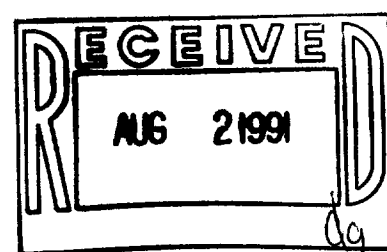

117-1095

ICI 09184