


PLAT OF SURVEY

LEGAL DESCRIPTION
 Part of Lot 9 of S. B. Chapin's Subdivision, Located in the Southeast 1/4 of Section 4, Town 1 North, Range 17 East, Town of Linn, County of Walworth, State of Wisconsin.
 Together with Easements for Ingress & Egress as recorded in Volume 251, Pages 795 & 796, Document Number 58635, Walworth County Register of Deeds Office, Walworth County Courthouse, Elkhorn, Wisconsin 53121

NOTES:
 This survey retraces a previous survey by Harold H. Kolb, R.L.S. #S-187, Dated April 28, 1963.
 Easement monumentation and centerline of driveway as platted in a previous survey by Robert M. Baerenwald, R.L.S. #S-1508, Dated April 15, 1980.

Ordered by: Jeanette Ragen
 Executrix
 S. K. Hummel Estate
 861 Kagawa
 Pacific Palisades, CA 90272


LINE	BEARING	DISTANCE
L1	N 48° 37' 34" E	12.36
L2	N 90° 00' 00" E	5.00
L3	N 90° 00' 00" E	5.00
L4	N 90° 00' 00" E	4.00
L5	S 3° 03' 45" W	18.45
L6	S 34° 02' 50" W	13.87
L7	S 70° 03' 50" W	13.59

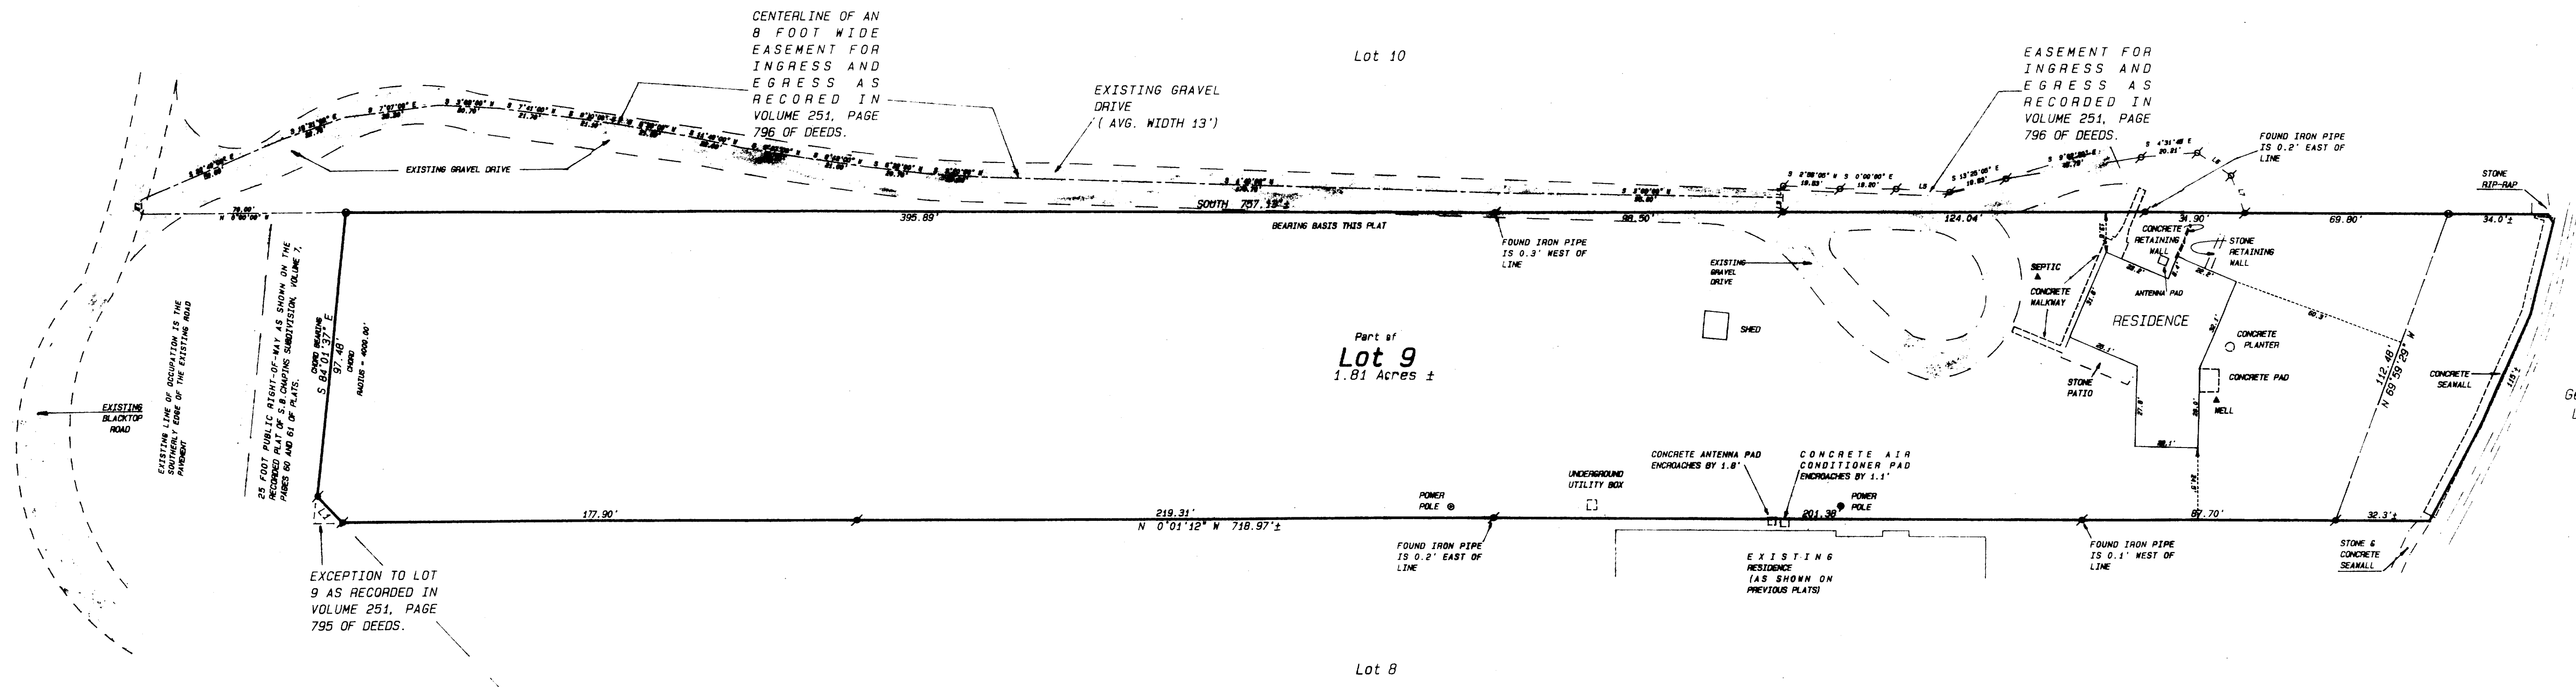

EXCEPTION TO LOT 9 AS RECORDED IN VOLUME 251, PAGE 795 OF DEEDS.


SOUTH LINE OF 100 FOOT ROADWAY AS SHOWN ON THE PLAT OF BROOKDALE ESTATES.

- Legend**
- FOUND IRON PIPE
 - FOUND IRON ROD
 - FOUND BRASS CAPPED MONUMENT
 - FOUND CONCRETE MONUMENT
 - CHISEL CUT IN CONCRETE
 - SET IRON ROD, 24" LONG, WEIGHING 1.5 LBS./LINEAL FT., 3/4" DIA.
 - SET IRON ROD, 36" LONG, WEIGHING 1.5 LBS./LINEAL FT., 1-11/16" DIA.
 - (***) RECORDED AS DIMENSION
 - - - EXISTING FENCE

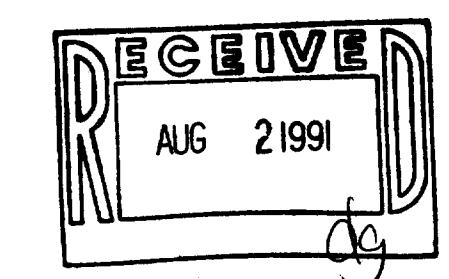

SCALE: 1" = 30 FEET

"I hereby certify that I have surveyed the above described property and that the above map is a true representation thereof and shows the size and location of the property, its exterior boundaries, the location of all visible structures and dimensions of all principal buildings thereon, boundary fences, apparent easements, roadways and visible encroachments, if any."
 "This survey is made for the use of the present owners of the property, and also those who purchase, mortgage, or guarantee the title thereto within one year from date hereof."

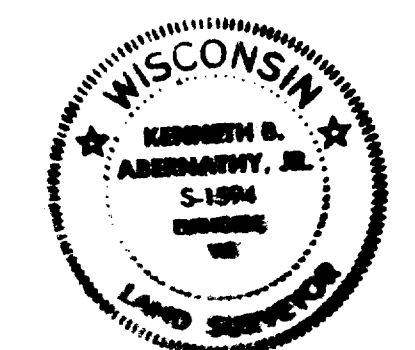

Kenneth B. Abernathy, Jr.
 KENNETH B. ABERNATHY, JR.
 WISCONSIN REGISTERED LAND SURVEYOR,
 S-1594

Date: Aug 16, 1991 Job No. 1891-492