
PLAT OF SURVEY OF

OUTLOT I OF CERTIFIED SURVEY MAP NO. 1906 LOCATED IN THE NW 1/4 OF THE NW 1/4 AND THE NE 1/4 OF THE NW 1/4 OF SECTION 17, TIN, RITE, WALWORTH COUNTY, WISCONSIN

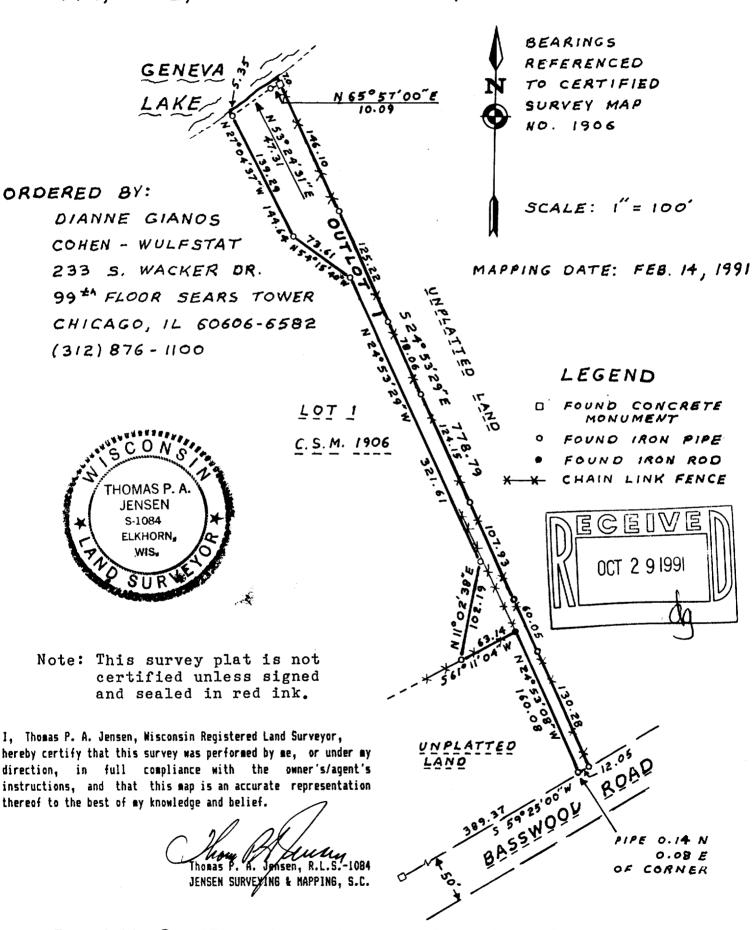

Copyright © 1991 by Jensen Surveying & Mapping S.C.

All rights reserved. No part of this survey plat may be reproduced or transmitted in any form by any means - graphic, electronic, or mechanical, including photocopying, tracing, or information storage and retrieval systems - without permission in writing from Thomas P.A. Jensen, Jensen Surveying & Mapping S.C.

1991.027

17-1099