
## DUNHAM SURVEYING, S.C. SURVEYING & SUBDIVIDING DELAYAN, WISCONSIN 53115

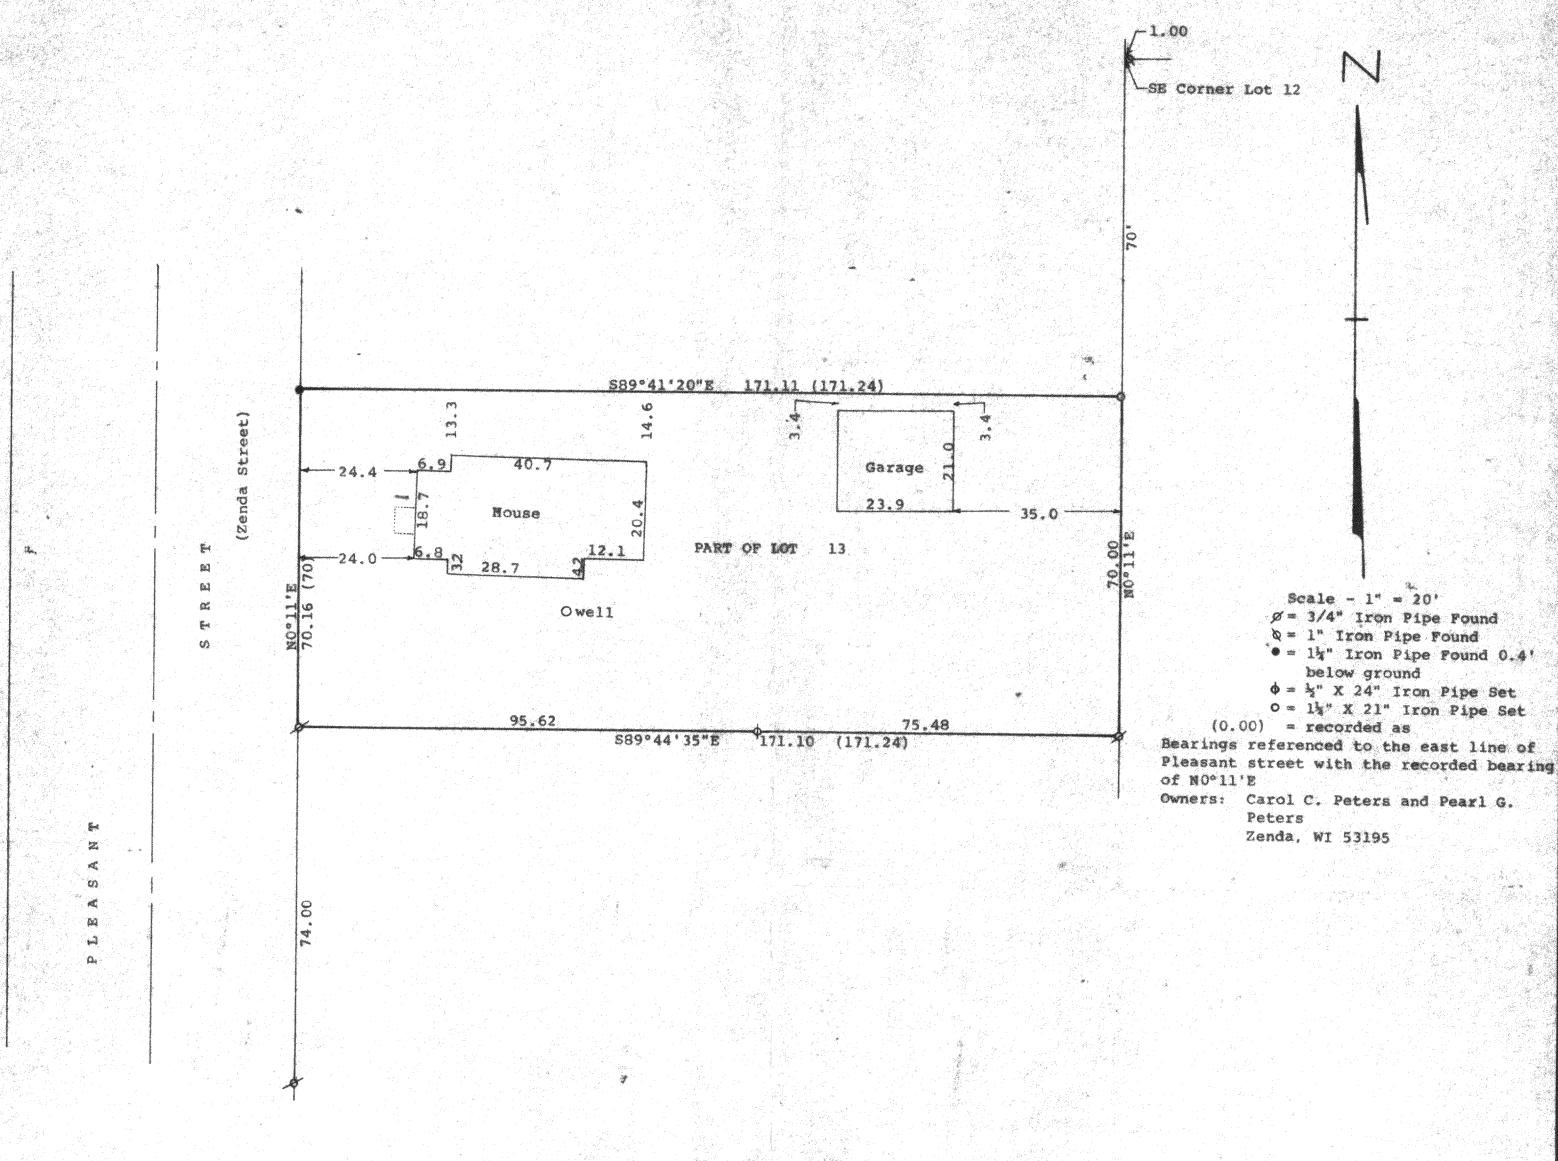

SMAMP OF MICCOMPINA

STATE OF WISCONSIN) SS

I, George T. Dunham, Surveyor, certify that I have surveyed the property described as follows:

The South 70 feet to the west 171.24 feet of Lot 13 in Block 1 of Kuebker's Addition to the Village of Zenda, Section 28, T 1 N, R 17 E, Walworth County, Wisconsin,

and that the plat shown hereon is a correct representation thereof and shows the size and location of the property, its exterior boundaries, the location of all visible structures and dimensions of all principal buildings thereon, boundary fences, apparent easements, roadways and visible encroachments, if any, and that I have surveyed the property hereon described, according to the official records, to the best of my knowledge and belief.

September 17, 1991

George D. Dunham, Surveyor

