

*LAKE VIEW ROAD*

**HIGHLAND ROAD**

A survey map of a residential lot. The lot is bounded by a north line (bearing 89°35', distance 109.88'), an east line (bearing 90°03', distance 109.82'), a south line (bearing 90°01', distance 50.03'), and a west line (bearing 89°38', distance 109.88'). The lot is divided into a hatched "RESIDENCE" area and an unshaded "DECK" area. The residence has a north-south width of 30.2' and an east-west width of 28.4'. The deck is 14.7' wide and 31.2' high. A retaining wall is located 1.9'± south of the north boundary, with an iron pipe at its base. The lot is adjacent to a "20' ORDERED LAKE" and a "110" lot.

110

PLAT OF SURVEY OF

I HEREBY CERTIFY THAT I HAVE SURVEYED THE ABOVE DESCRIBED PROPERTY AND THAT THE ABOVE MAP IS A TRUE REPRESENTATION THEREOF AND SHOWS THE SIZE AND LOCATION OF THE PROPERTY, ITS EXTERIOR BOUNDARIES, THE LOCATION OF ALL VISIBLE STRUCTURES AND DIMENSIONS OF ALL PRINCIPAL BUILDINGS THEREON, BOUNDARY FENCES, APPARENT EASEMENTS, ROADWAYS AND VISIBLE ENCROACHMENTS, IF ANY, TO THE BEST OF MY KNOWLEDGE AND BELIEF.

THIS SURVEY IS MADE FOR THE USE OF THE PRESENT OWNERS OF THE PROPERTY AND ALSO THOSE WHO PURCHASE, MORTGAGE OR GUARANTEE THE TITLE THERETO WITHIN ONE (1) YEAR FROM DATE HEREOF.


HEREOF.

Robert M. Baerenwald  
ROBERT M. BAERENWALD  
WISCONSIN REGISTERED LAND SURVEYOR S-1508

DATE May 14, 1991 JOB NO. 2987

**NOTE: THIS IS NOT A CERTIFIED COPY UNLESS SEALED.**

*SCALE IN FEET*

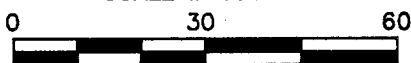

### LEGEND

- O-IRON PIPE FOUND  
 X-IRON ROD FOUND  
 ●-CONCRETE MONUMENT FOUND  
 O-IRON PIPE PLACED  
 ()-RECORDED AS

RECEIVED  
JAN 16 1992

117-1201

ILGH-19