

ABELL

SURVEYING & MAPPING DELAVAN, WISCONSIN 53115 414-720-6787

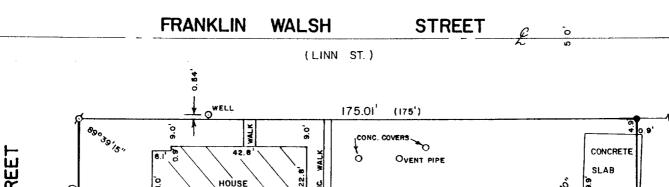

6 0

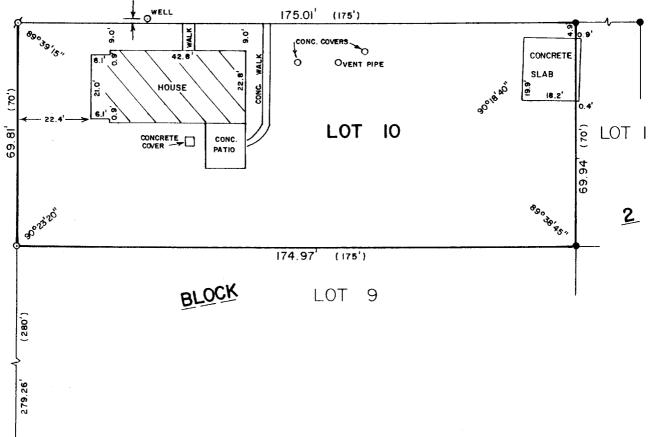

PLAT OF SURVEY OF

LOT 10, BLOCK 2 OF THE PLAT OF ZENDA, LOCATED IN T1N,R17E, WALWORTH COUNTY, WISCONSIN.

ORDERED BY:

RE/MAX - LAKES AREA REALTORS 1815 N. SHORE DRIVE

DELAVAN, WI. 53115



SCALE - 1"=30' LEGEND

IRON ROD FOUND

ø − IRON PIPE FOUND

o - IRON PIPE SET

()- RECORDED AS



I HEREBY CERTIFY THAT I HAVE SURVEYED THE ABOVE DESCRIBED PROPERTY AND THAT THE ABOVE MAP IS A TRUE REPRESENTATION THEREOF AND SHOWS THE SIZE AND LOCATION OF THE PROPERTY, ITS EXTERIOR BOUNDARIES, THE LOCATION OF ALL VISIBLE STRUCTURES AND DIMENSIONS OF ALL PRINCIPAL BUILDINGS THEREON, BOUNDARY FENCES, APPARENT EASEMENTS, ROADWAYS AND VISIBLE ENCROACHMENTS, IF ANY, TO THE BEST OF MY KNOWLEDGE AND BELLEF.

THIS SURVEY IS HADE FOR THE USE OF THE PRESENT OWNERS OF THE PROPERTY, AND ALSO THOSE WHO FURCHASE, MORTGAGE, OR GUARANTEE THE TITLE THERETO WITHIN ONE (I) YEAR FROM DATE HEREOF.

STERED LAND SURVEYOR, \$-1596

May 15, 1992

TE: THIS IS NOT A CERTIFIED COPY UNLESS SEALED.