


KOLB LAND CONSULTING, INC.  
 LAND SURVEYING • SUBDIVIDING • LAND PLANNING

LAKE GENEVA, WISCONSIN 53147 414-248-3697

DETAIL



SCALE: 1" = 10'

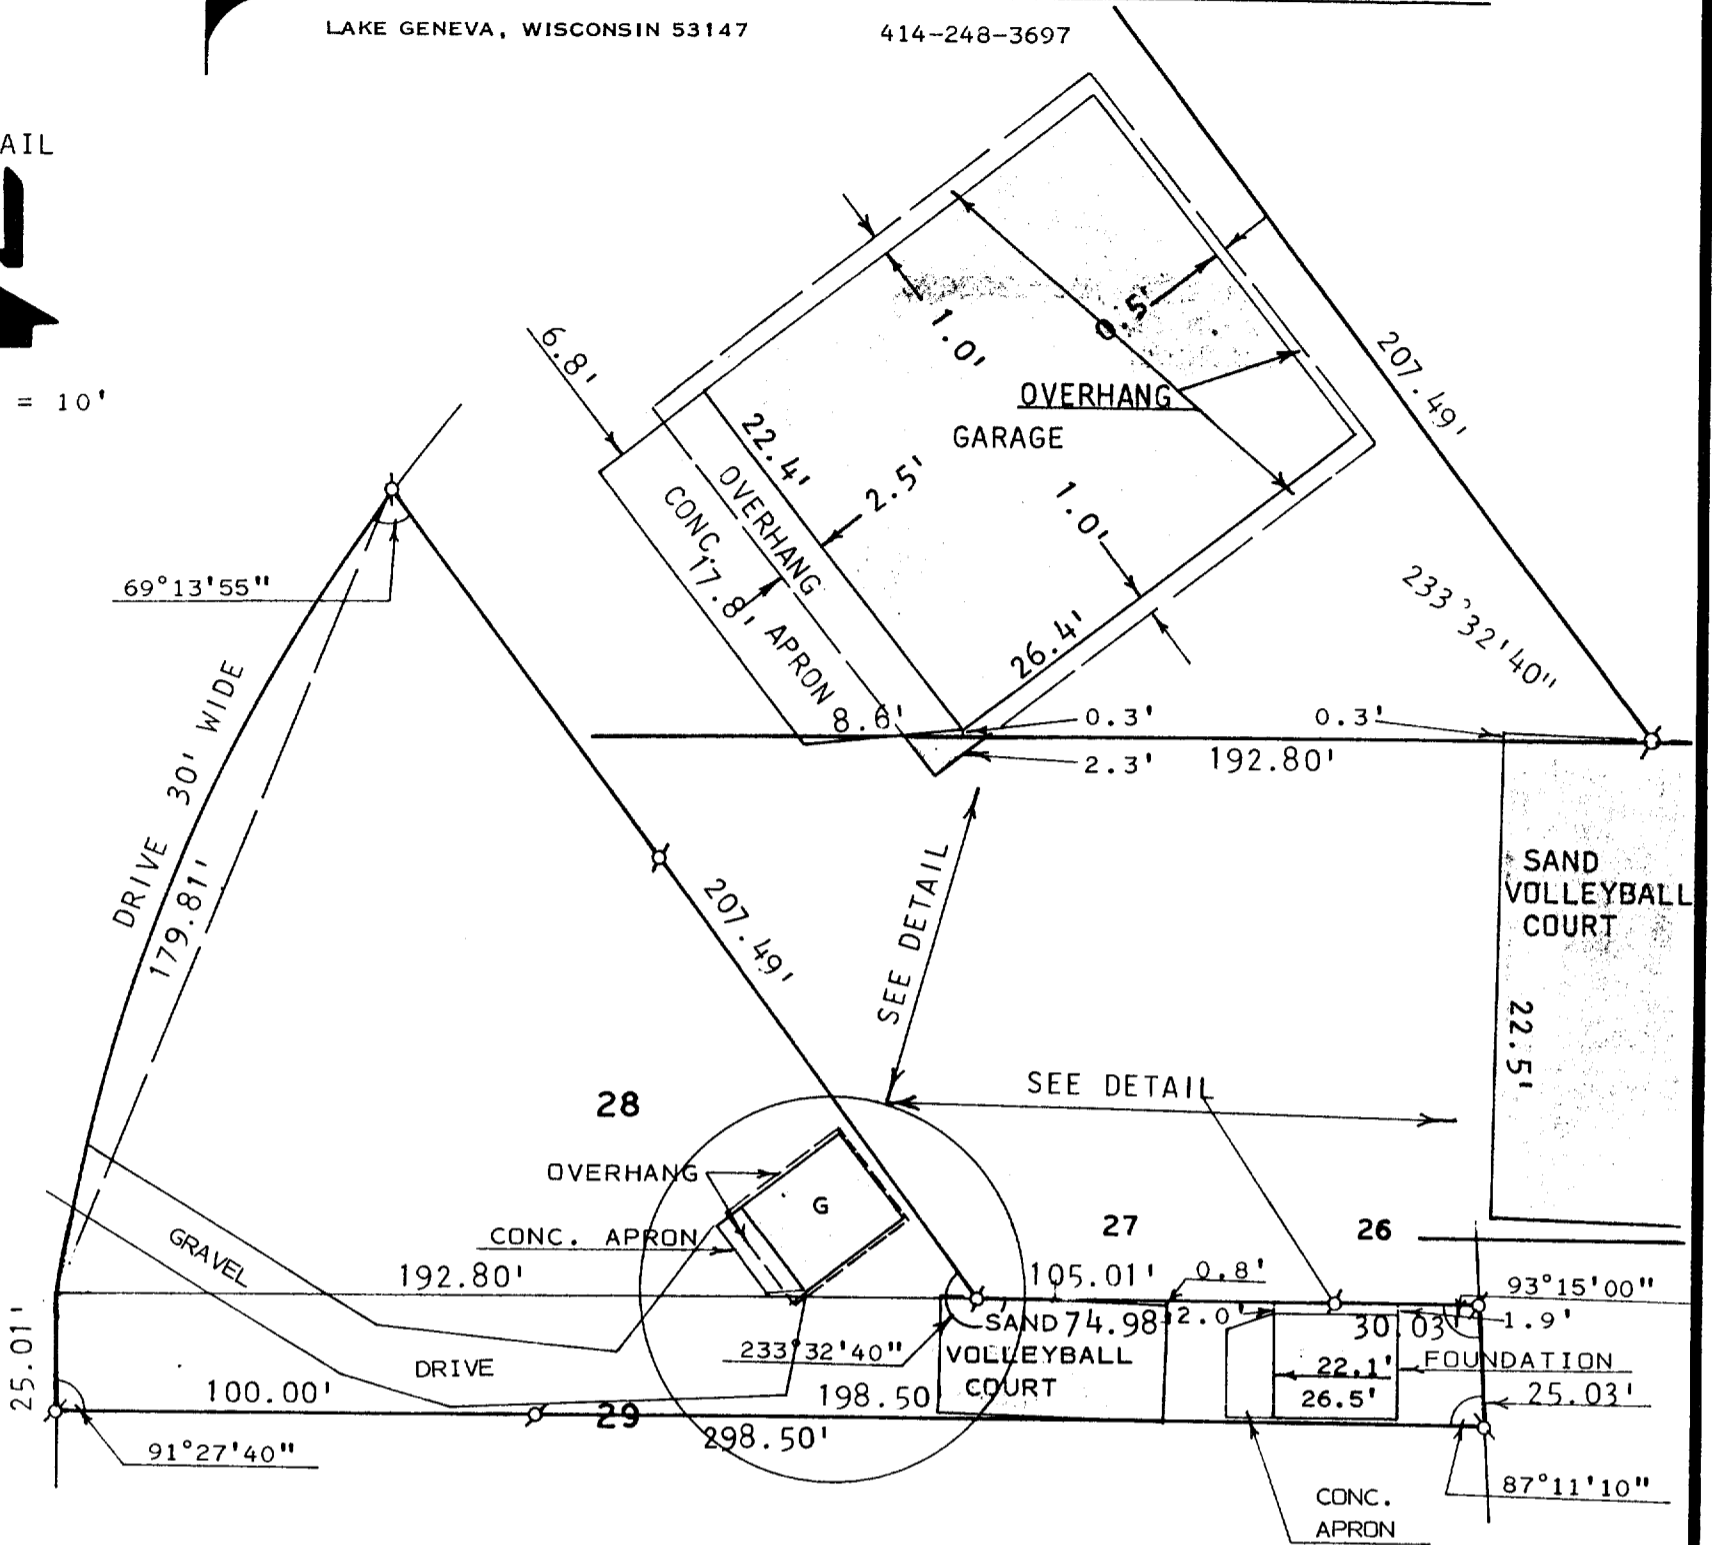

PLAT OF SURVEY OF

LOT 28 AND THE NORTH 25 FEET OF LOT 29  
 OF THE BIRCHES 1ST ADDITION, A SUBDIVISION  
 LOCATED IN T1N, R17E, TOWN OF LINN, WALWORTH  
 COUNTY, WISCONSIN.

NOTE: ANGLES AND DISTANCES ASSUMED AS SHOWN  
 ON RECORDED SURVEY RECORDS.


ORDERED BY: BILL BENTSEN & BILL SEYMOUR  
 23 N. WISCONSIN  
 ELKHORN, WI. 53121



SCALE: 1" = 40'

LEGEND

- ⊕ - IRON PIPE FOUND
- ⊙ - IRON ROD FOUND
- - IRON PIPE SET
- ( ) - AS RECORDED
- G - GARAGE

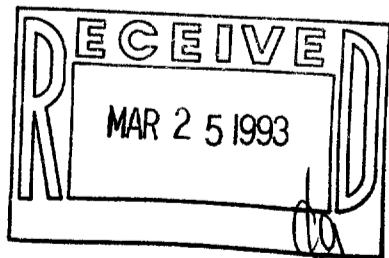

I, HAROLD H. KOLB, DO HEREBY CERTIFY  
 THAT I HAVE SURVEYED THE PROPERTY  
 HEREON DESCRIBED ACCORDING TO THE  
 OFFICIAL RECORDS AND THAT THE PLAT  
 HEREON IS A CORRECT REPRESENTATION  
 OF THE LOT LINES AND THE PRINCIPAL  
 LINES OF THE BUILDINGS, TO THE BEST  
 OF MY KNOWLEDGE AND BELIEF.  
 SURVEY NOT VALID UNLESS SURVEYOR'S  
 SIGNATURE IS IN RED.

HAROLD H. KOLB  
 WISCONSIN REGISTERED LAND SURVEYOR, S-187  
 DATE \_\_\_\_\_

117-1285

1BA1-19


KOLB LAND CONSULTING, INC.  
 LAND SURVEYING • SUBDIVIDING • LAND PLANNING

LAKE GENEVA, WISCONSIN 53147 414-248-3697

DETAIL



SCALE: 1" = 10'

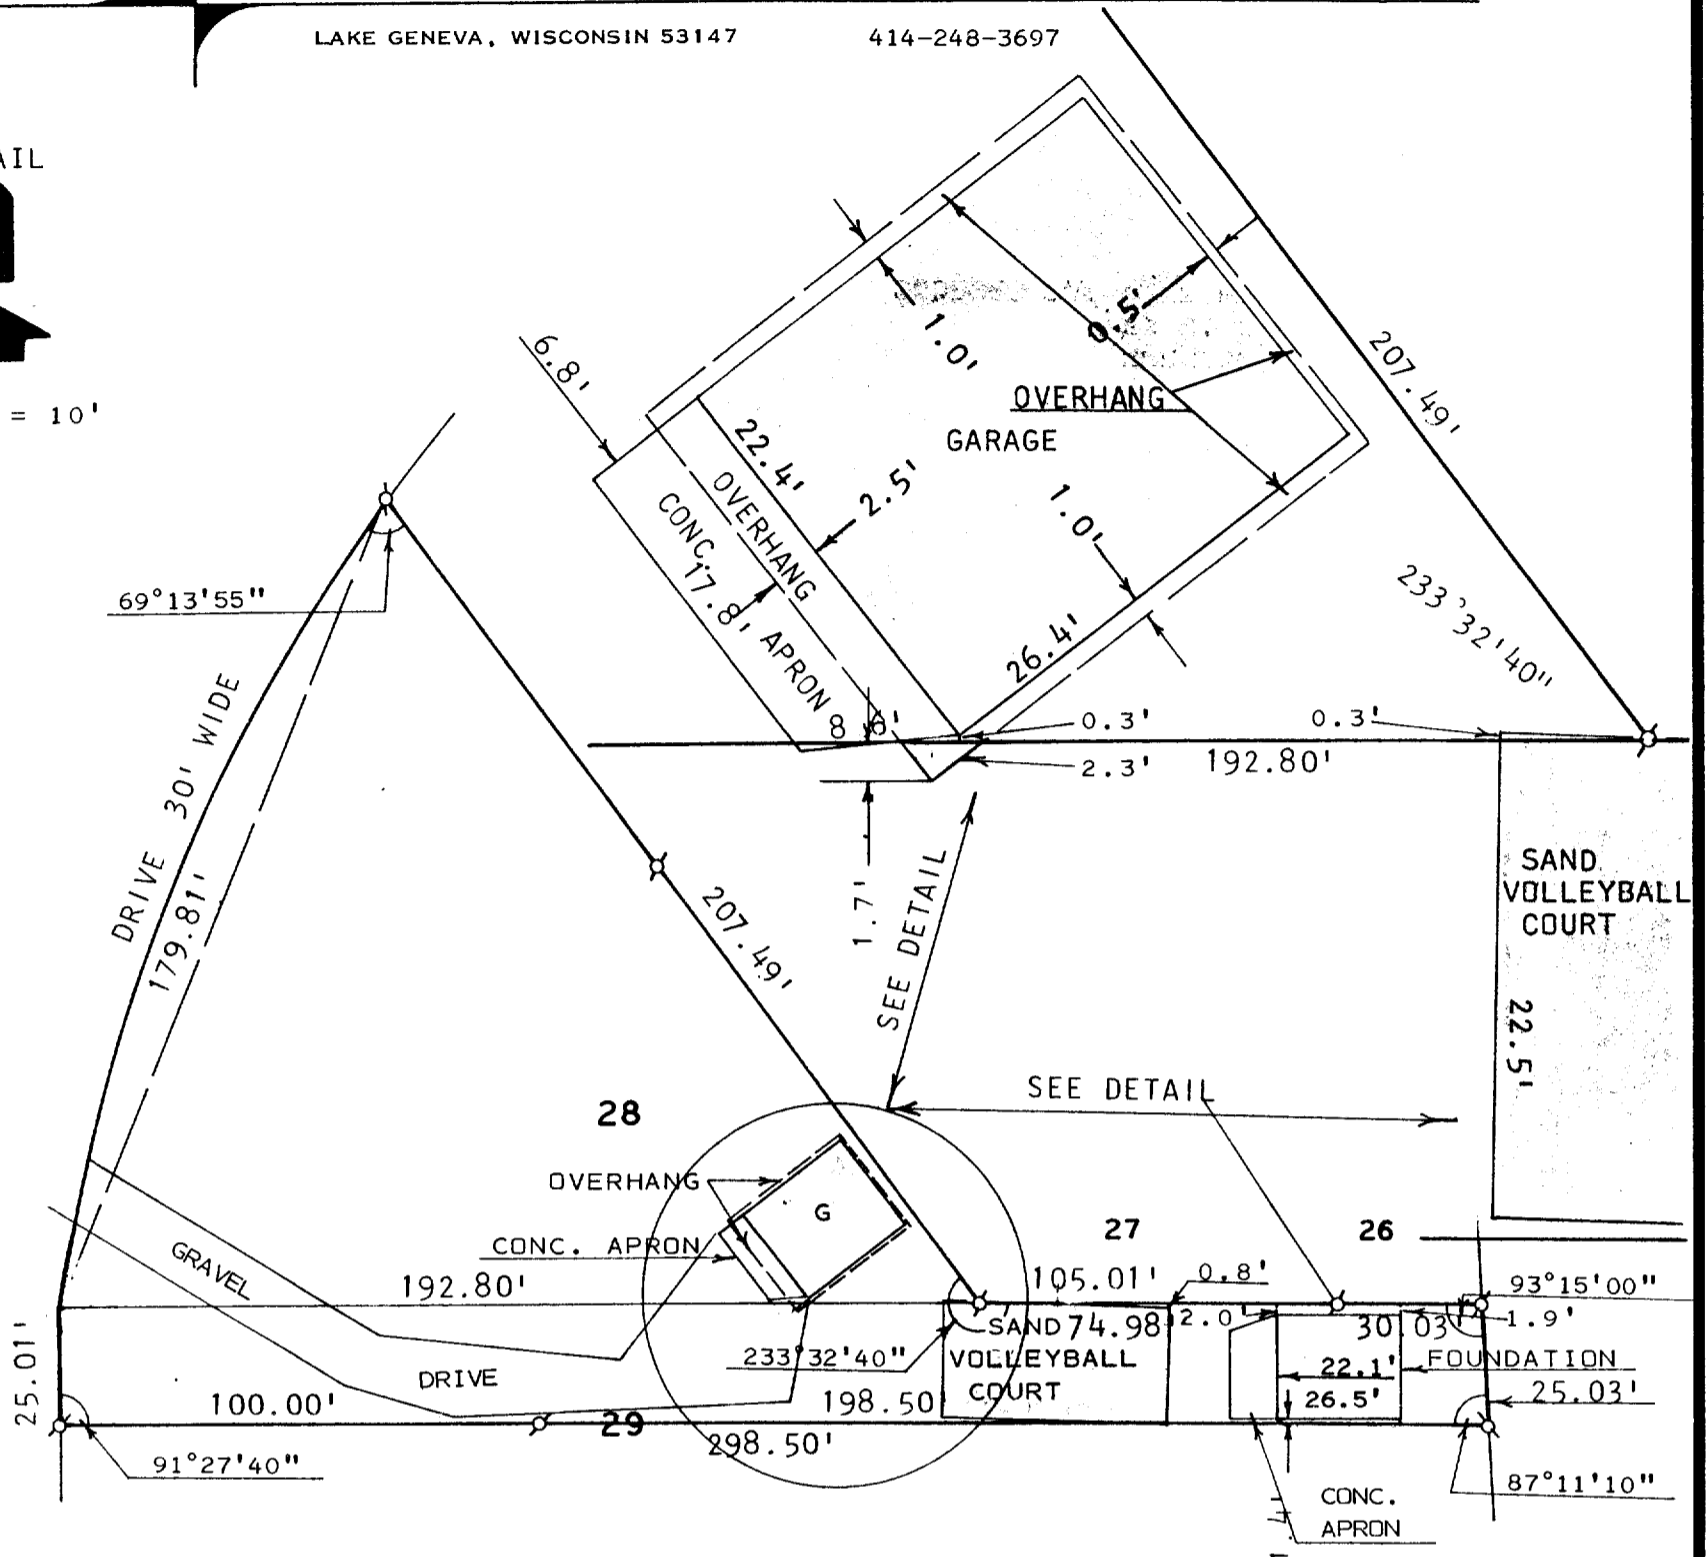

PLAT OF SURVEY OF

LOT 28 AND THE NORTH 25 FEET OF LOT 29  
 OF THE BIRCHES 1ST ADDITION, A SUBDIVISION  
 LOCATED IN T1N, R17E, TOWN OF LINN, WALWORTH  
 COUNTY, WISCONSIN.

NOTE: ANGLES AND DISTANCES ASSUMED AS SHOWN  
 ON RECORDED SURVEY RECORDS.


ORDERED BY: BILL BENTSEN & BILL SEYMOUR  
 23 N. WISCONSIN  
 ELKHORN, WI. 53121



SCALE: 1" = 40'

LEGEND

- ⊗ - IRON PIPE FOUND
- ⊙ - IRON ROD FOUND
- - IRON PIPE SET
- ( ) - AS RECORDED
- G - GARAGE

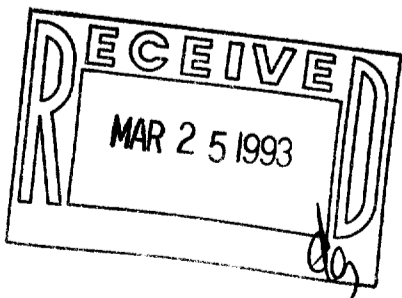

I, HAROLD H. KOLB, DO HEREBY CERTIFY  
 THAT I HAVE SURVEYED THE PROPERTY  
 HEREON DESCRIBED ACCORDING TO THE  
 OFFICIAL RECORDS AND THAT THE PLAT  
 HEREON IS A CORRECT REPRESENTATION  
 OF THE LOT LINES AND THE PRINCIPAL  
 LINES OF THE BUILDINGS, TO THE BEST  
 OF MY KNOWLEDGE AND BELIEF.  
 SURVEY NOT VALID UNLESS SURVEYOR'S  
 SIGNATURE IS IN RED.

HAROLD H. KOLB  
 WISCONSIN REGISTERED LAND SURVEYOR, S-187  
 DATE AUGUST 14, 1992  
 REVISED: AUGUST 24, 1992

16A1-19

117-1285

1-17-1DA-1-2DA