
WALWORTH COUNTY SURVEYING & MAPPING

Min

727 HENRY STREET LAKE GENEVA, WISCONSIN 414—248—0505

EAST ROADWAY

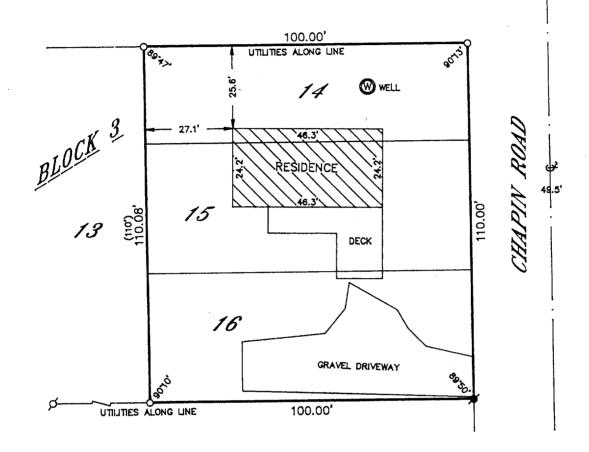

PLAT OF SURVEY OF

LOTS 14, 15 AND 16, BLOCK 3 OF SUNSET HILLS, A SUBDIVISION LOCATED IN SECTION 4, T 1 N, R 17 E, WALWORTH COUNTY, WISCONSIN.

ORDERED BY: ED TRYBULA 8754 N. ELMORE STREET NILES, ILLINOIS 60714

I HEREBY CERTIFY THAT I HAVE SURVEYED THE ABOVE DESCRIBED PROPERTY AND THAT THE ABOVE MAP IS A TRUE REPRESENTATION THEREOF AND SHOWS THE SIZE AND LOCATION OF THE PROPERTY, IS EXTERIOR BOUNDARIES, THE LOCATION OF ALL VISIBLE STRUCTURES AND DIMENSIONS OF ALL PRINCIPAL BUILDINGS THEREON, BOUNDARY FENCES, APPARENT EASEMENTS, ROADWAYS AND VISIBLE ENCROACHMENTS, IF ANY, TO THE BEST OF MY KNOWLEDGE AND BELIEF.

THIS SURVEY IS MADE FOR THE USE OF THE PRESENT OWNERS OF THE PROPERTY AND ALSO THOSE WHO PURCHASE, MORTGAGE OR GUARANTEE THE TITLE THERETO WITHIN ONE (1) YEAR FROM DATE HEREOF.

ROBERT M. BAERENWALD MISCONSIN REGISTERED LAND SURVEYOR, S-1508

NOTE: THIS IS NOT A CERTIFIED COPY UNLESS SEALED.

