


DUNHAM SURVEYING, S.C.
SURVEYING & ENGINEERING
DELAWARE, WISCONSIN 53115

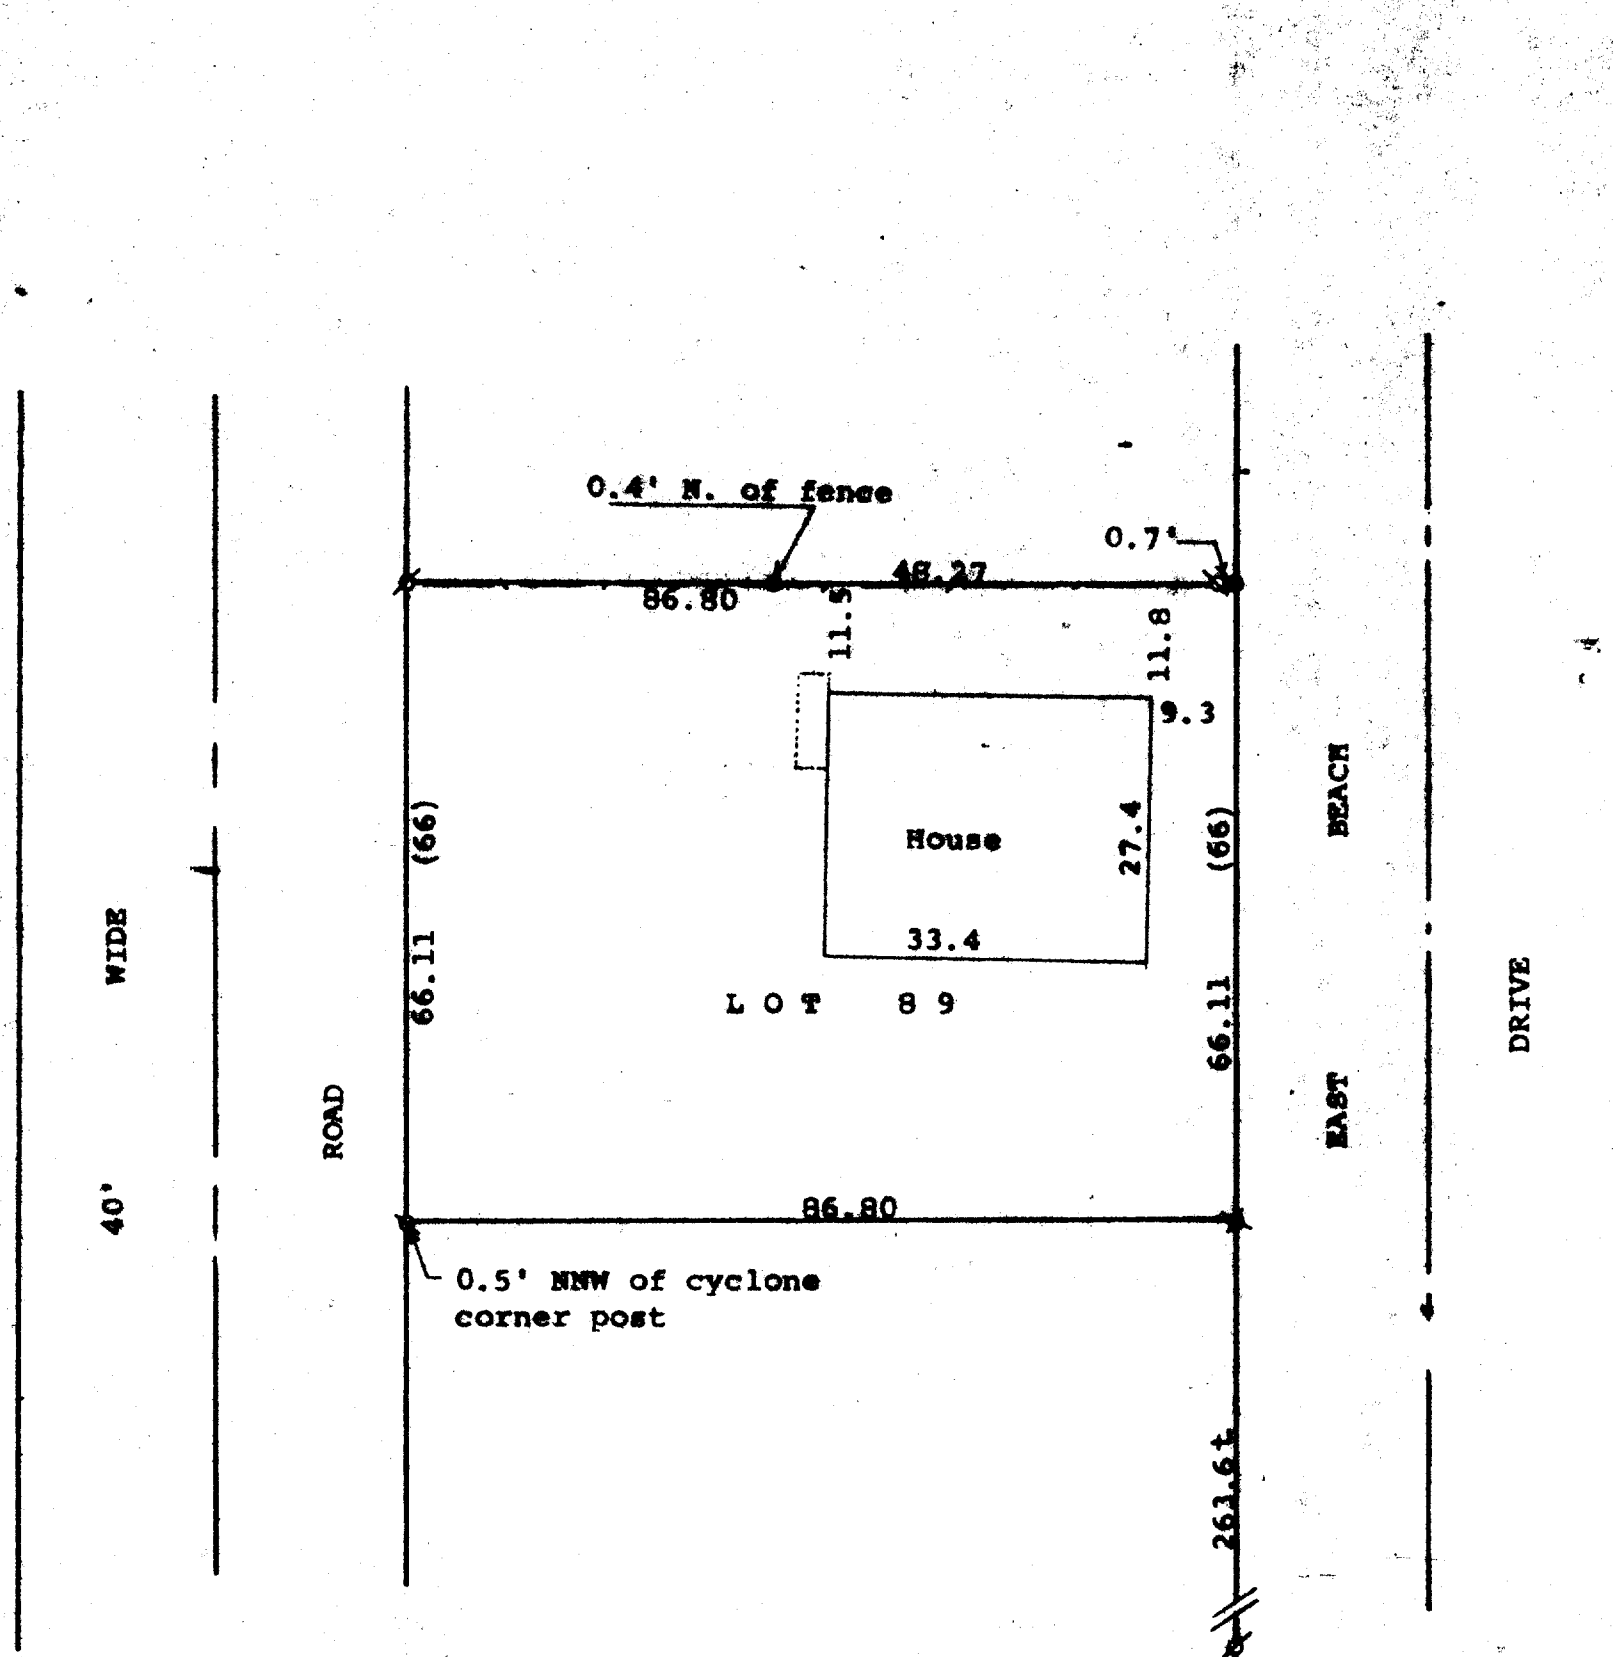

Scale - 1" = 20'
 * = 1" Iron Pipe Found
 * = 3/4" Iron Pipe Found 0.8' below ground. Pulled and set at ground level
 ● = fence post at corner.
 ○ = 3/4" X 24" Iron Pipe Set
 ∅ = Iron Pipe Found. Size not noted
 Survey ordered by: William McDonald
 Beach Road
 R. 1 Box 143
 Lake Geneva, WI 53147
 (0.00) = recorded distance

STATE OF WISCONSIN) ss
 COUNTY OF WALWORTH)

I, George T. Dunham, Surveyor, certify that I have surveyed the property described as follows:

Lot 89 of Robinson's Second Subdivision located in Sections 11 and 14, T 1 N, R 17 E, Walworth County, Wisconsin, subject to easements of record

and that the plat shown hereto is a correct representation thereof and shows the size and location of the property, its exterior boundaries, the location of all visible structures and dimensions of all principal buildings thereon, boundary fences, apparent easements, roadways and visible encroachments, if any, and that I have surveyed the property hereon described, according to the official records, to the best of my knowledge and belief.

August 25, 1992

Platting date March 31, 1993

George T. Dunham
 George T. Dunham, Surveyor

