

ABELL  
SURVEYING & MAPPING  
DELAVAN, WISCONSIN 53115  
414-728-6737

N LOT 2




SCALE 1" = 20'

LEGEND

- - IRON PIPE FOUND
- - CONCRETE MONUMENT FOUND
- - IRON ROD SET
- △ - UTILITY POLE
- — — — — OVERHEAD UTILITY LINES
- \* \* \* \* \* WOOD FENCE
- ( ) - RECORDED AS

LOT 1  
BLOCK

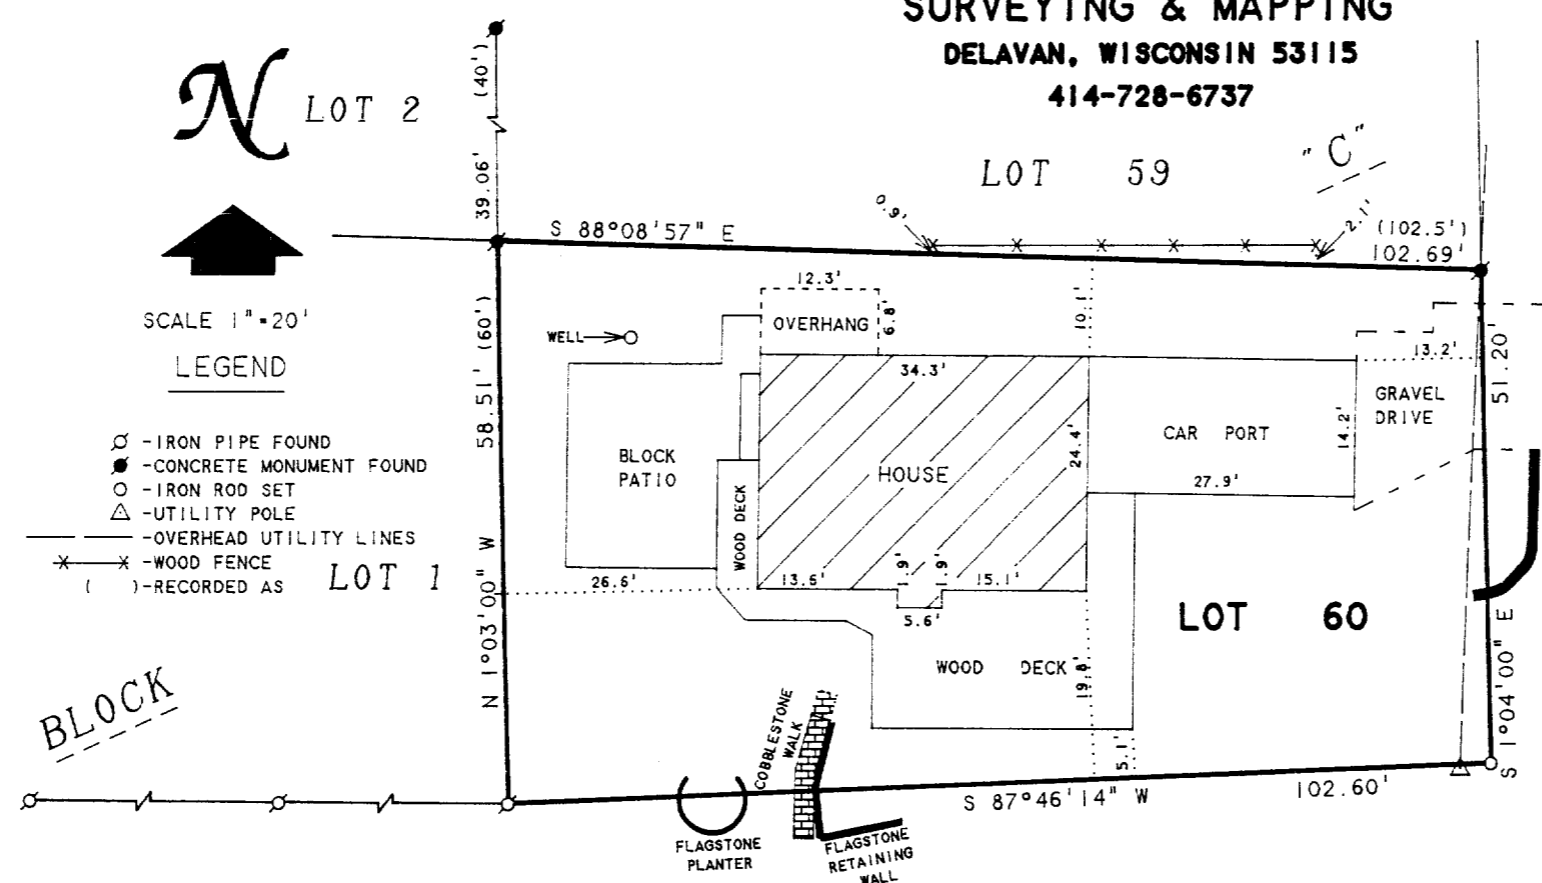


PLAT OF SURVEY OF

LOT 60, BLOCK "C", CISCO BEACH, LOCATED  
IN T1N. R17E, WALWORTH COUNTY, WISCONSIN.

NOTE: BEARINGS ARE REFERENCED TO  
EXISTING SURVEY RECORDS.

ORDERED BY: STEBNITZ BUILDERS  
P.O. BOX 526  
DELAVAN, WI 53115

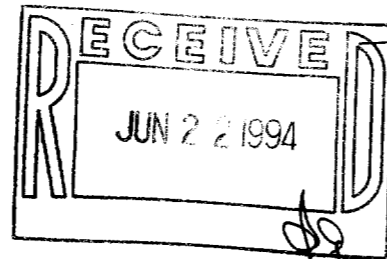

I, DAVID F. ABELL, DO HEREBY CERTIFY THAT I HAVE SURVEYED THE PROPERTY HEREON DESCRIBED ACCORDING TO THE OFFICAL RECORDS AND THAT THE PLAT HEREON IS A CORRECT REPRESENTATION OF THE PROPERTY LINES TO THE BEST OF MY KNOWLEDGE AND BELIEF

*David F. Abell*

DAVID F. ABELL  
WISCONSIN REGISTERED LAND SURVEYOR, S-1596

April 20, 1994

DATE: \_\_\_\_\_ JOB NUMBER - 94041  
NOTE: THIS IS NOT A CERTIFIED COPY UNLESS SEALED.

ICI-74

117-1409