


WALWORTH COUNTY SURVEYING & MAPPING

727 HENRY STREET
LAKE GENEVA, WISCONSIN
414-248-0505

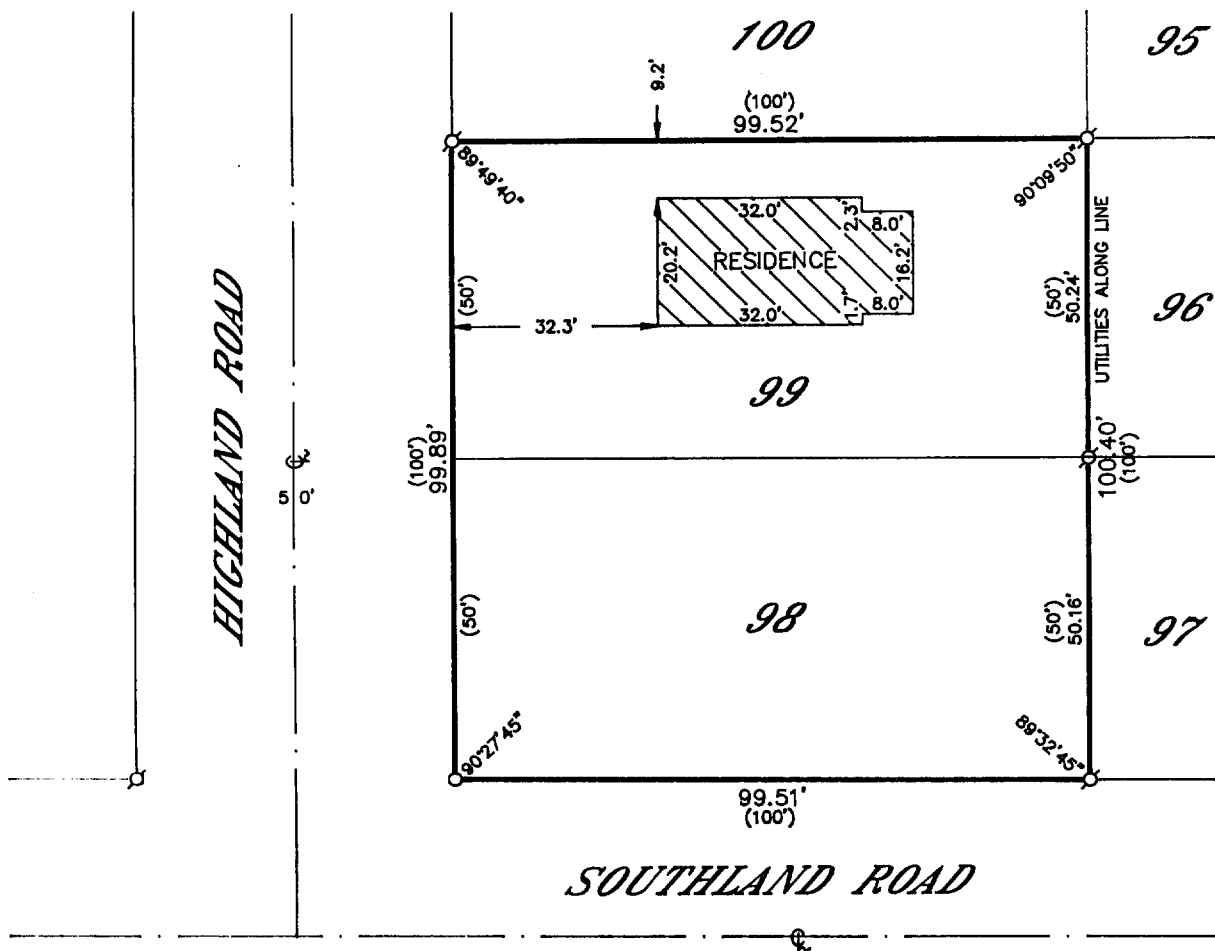


PLAT OF SURVEY OF

LOTS 98 AND 99 OF LAKE GENEVA HIGHLANDS,
A SUBDIVISION LOCATED IN SECTION 8, T 1 N,
R 17 E, WALWORTH COUNTY, WISCONSIN.

ORDERED BY: STUART KORTEBEIN
7401 NORTH PIERRON ROAD
GLENDALE, WISCONSIN

53209

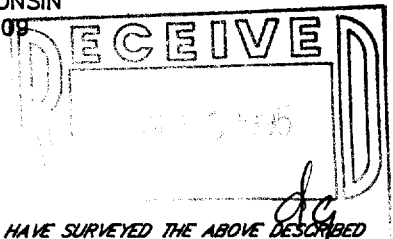


I HEREBY CERTIFY THAT I HAVE SURVEYED THE ABOVE DESCRIBED
PROPERTY AND THAT THE ABOVE MAP IS A TRUE REPRESENTATION
THEREOF AND SHOWS THE SIZE AND LOCATION OF THE PROPERTY,
ITS EXTERIOR BOUNDARIES, THE LOCATION OF ALL VISIBLE STRUCTURES
AND DIMENSIONS OF ALL PRINCIPAL BUILDINGS THEREON, BOUNDARY
FENCES, APPARENT EASEMENTS, ROADWAYS AND VISIBLE ENCROACH-
MENTS, IF ANY, TO THE BEST OF MY KNOWLEDGE AND BELIEF.

THIS SURVEY IS MADE FOR THE USE OF THE PRESENT OWNERS OF
THE PROPERTY AND ALSO THOSE WHO PURCHASE, MORTGAGE OR
GUARANTEE THE TITLE THERETO WITHIN ONE (1) YEAR FROM DATE
HEREOF.

ROBERT M. BAERENWALD
WISCONSIN REGISTERED LAND SURVEYOR, S-1508

DATE 10/17/1994 JOB NO. 4440

NOTE: THIS IS NOT A CERTIFIED COPY UNLESS SEALED.

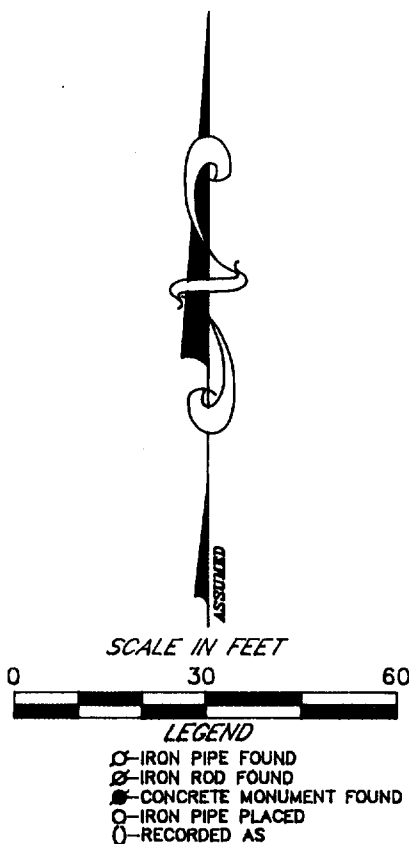

ILGH-96

117-1457