

PLAT OF SURVEY


LOTS 1 & 2 OF CERTIFIED SURVEY MAP NO. 2287

LOTS 11, 12, & 13 OF BLOCK 6

WOODDALE ADDITION

LOCATED IN TOWN 1 NORTH, RANGE 17 EAST

WALWORTH COUNTY, WISCONSIN

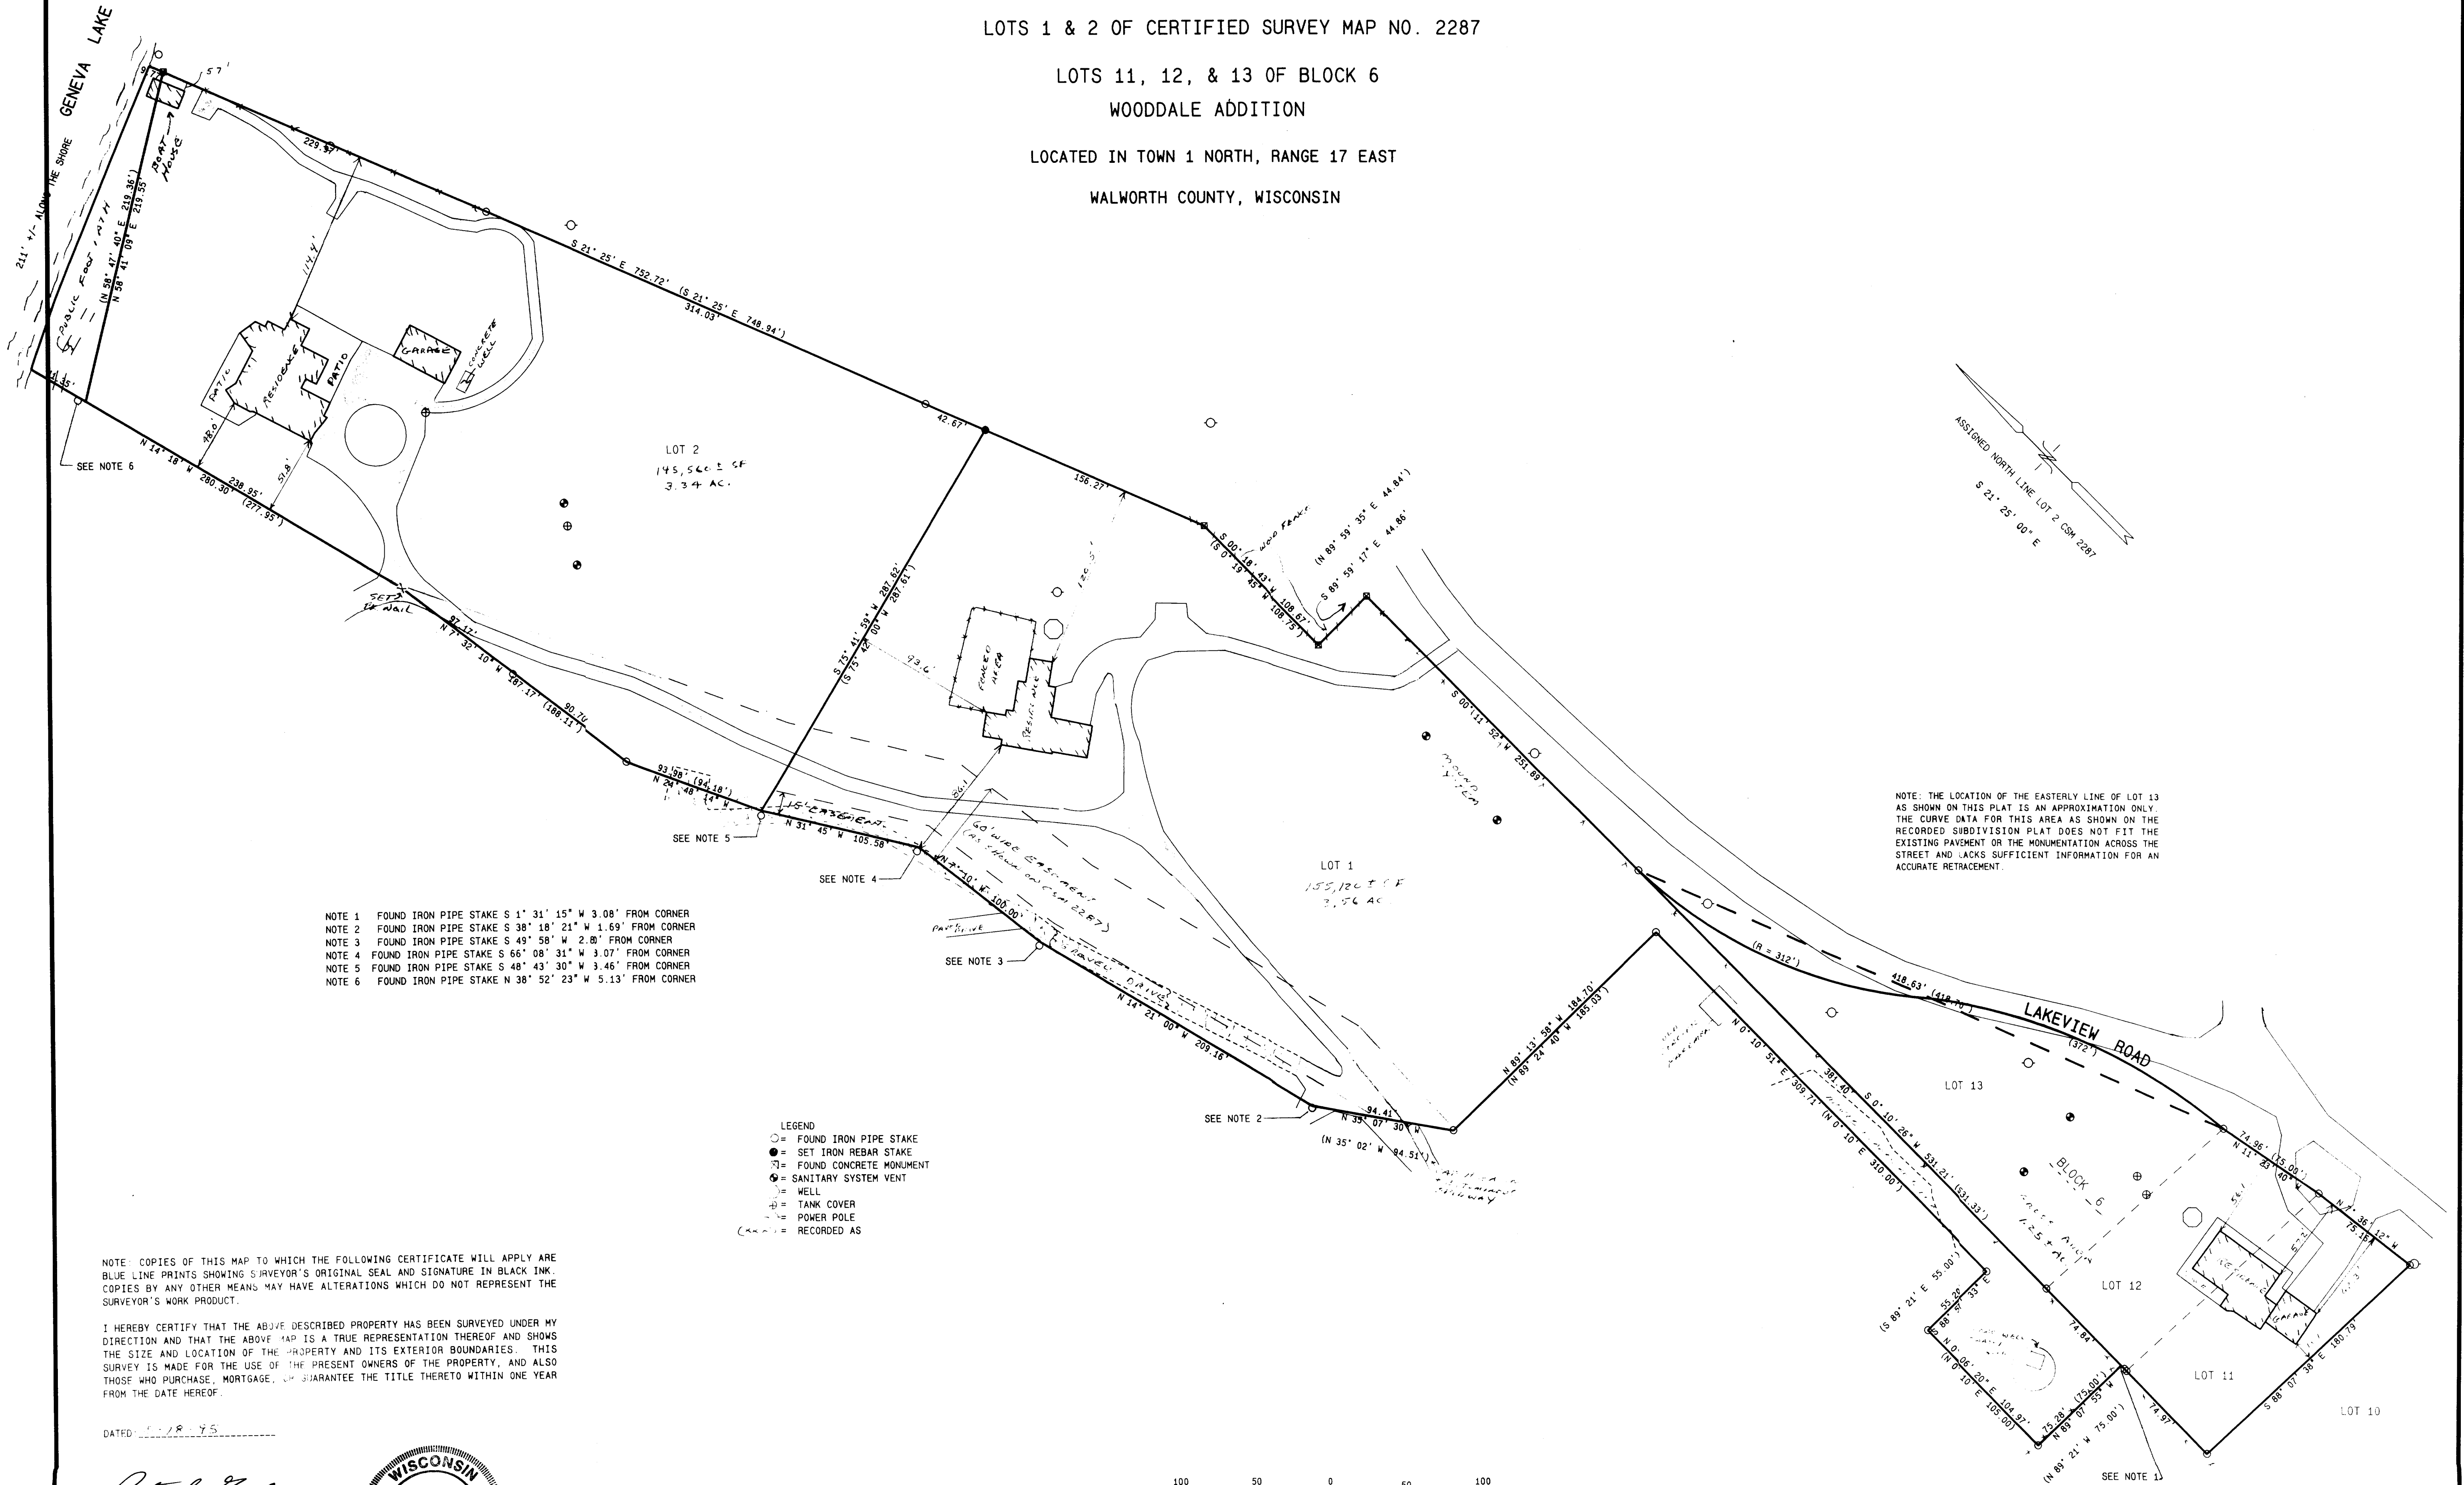

WORK ORDERED BY: DAVID WOLF
730 LAKEVIEW ROAD, SUITE 117
DEERFIELD, IL 60015

FARRIS, HANSEN & ASSOCIATES, INC.
Engineering, Architecture, Surveying
7 Ridgeway Court P.O. Box 437
ELKHORN, WISCONSIN 53121
Office: (414) 723-2098
Fax: (414) 723-5886

REVISIONS

PROJECT NO.

4285

DATE

05/17/95

SHEET NO.

1 OF 1

117-1487