

# PLAT OF SURVEY LOTS 24 THRU 28 OF BLOCK 5 MAPLE HILLS "A" SUBDIVISION LOCATED IN SECTION 18, TOWN OF LINN TOWN 1 NORTH, RANGE 17 EAST WALWORTH COUNTY, WISCONSIN

OWNER: MARIE & JOE DOYZINSKI

WORK ORDERED BY: WES ERSKINE  
 715 W. WALWORTH ST.  
 ELKHORN, WISCONSIN

FARRIS, HANSEN & ASSOCIATES, INC.  
 Engineering, Architecture, Surveying  
 7 Ridgeway Court P.O. Box 437  
 ELKHORN, WISCONSIN 53121  
 Office: (414) 723-2098  
 Fax: (414) 723-5886



REVISIONS

PROJECT NO.  
 4410  
 DATE  
 11/01/95  
 SHEET NO.  
 1 OF 1

ASSIGNED WEST LINE MAPLE HILLS DR.  
 N 00° 00' E

VIEWCREST DRIVE 60' WIDE ROW

MAPLE HILLS DRIVE 50' WIDE ROW

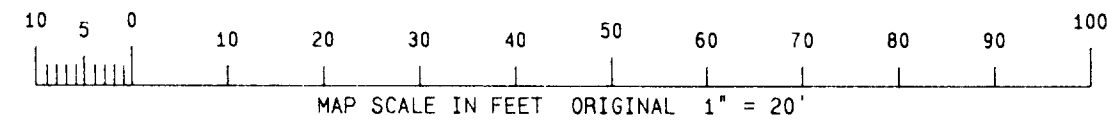
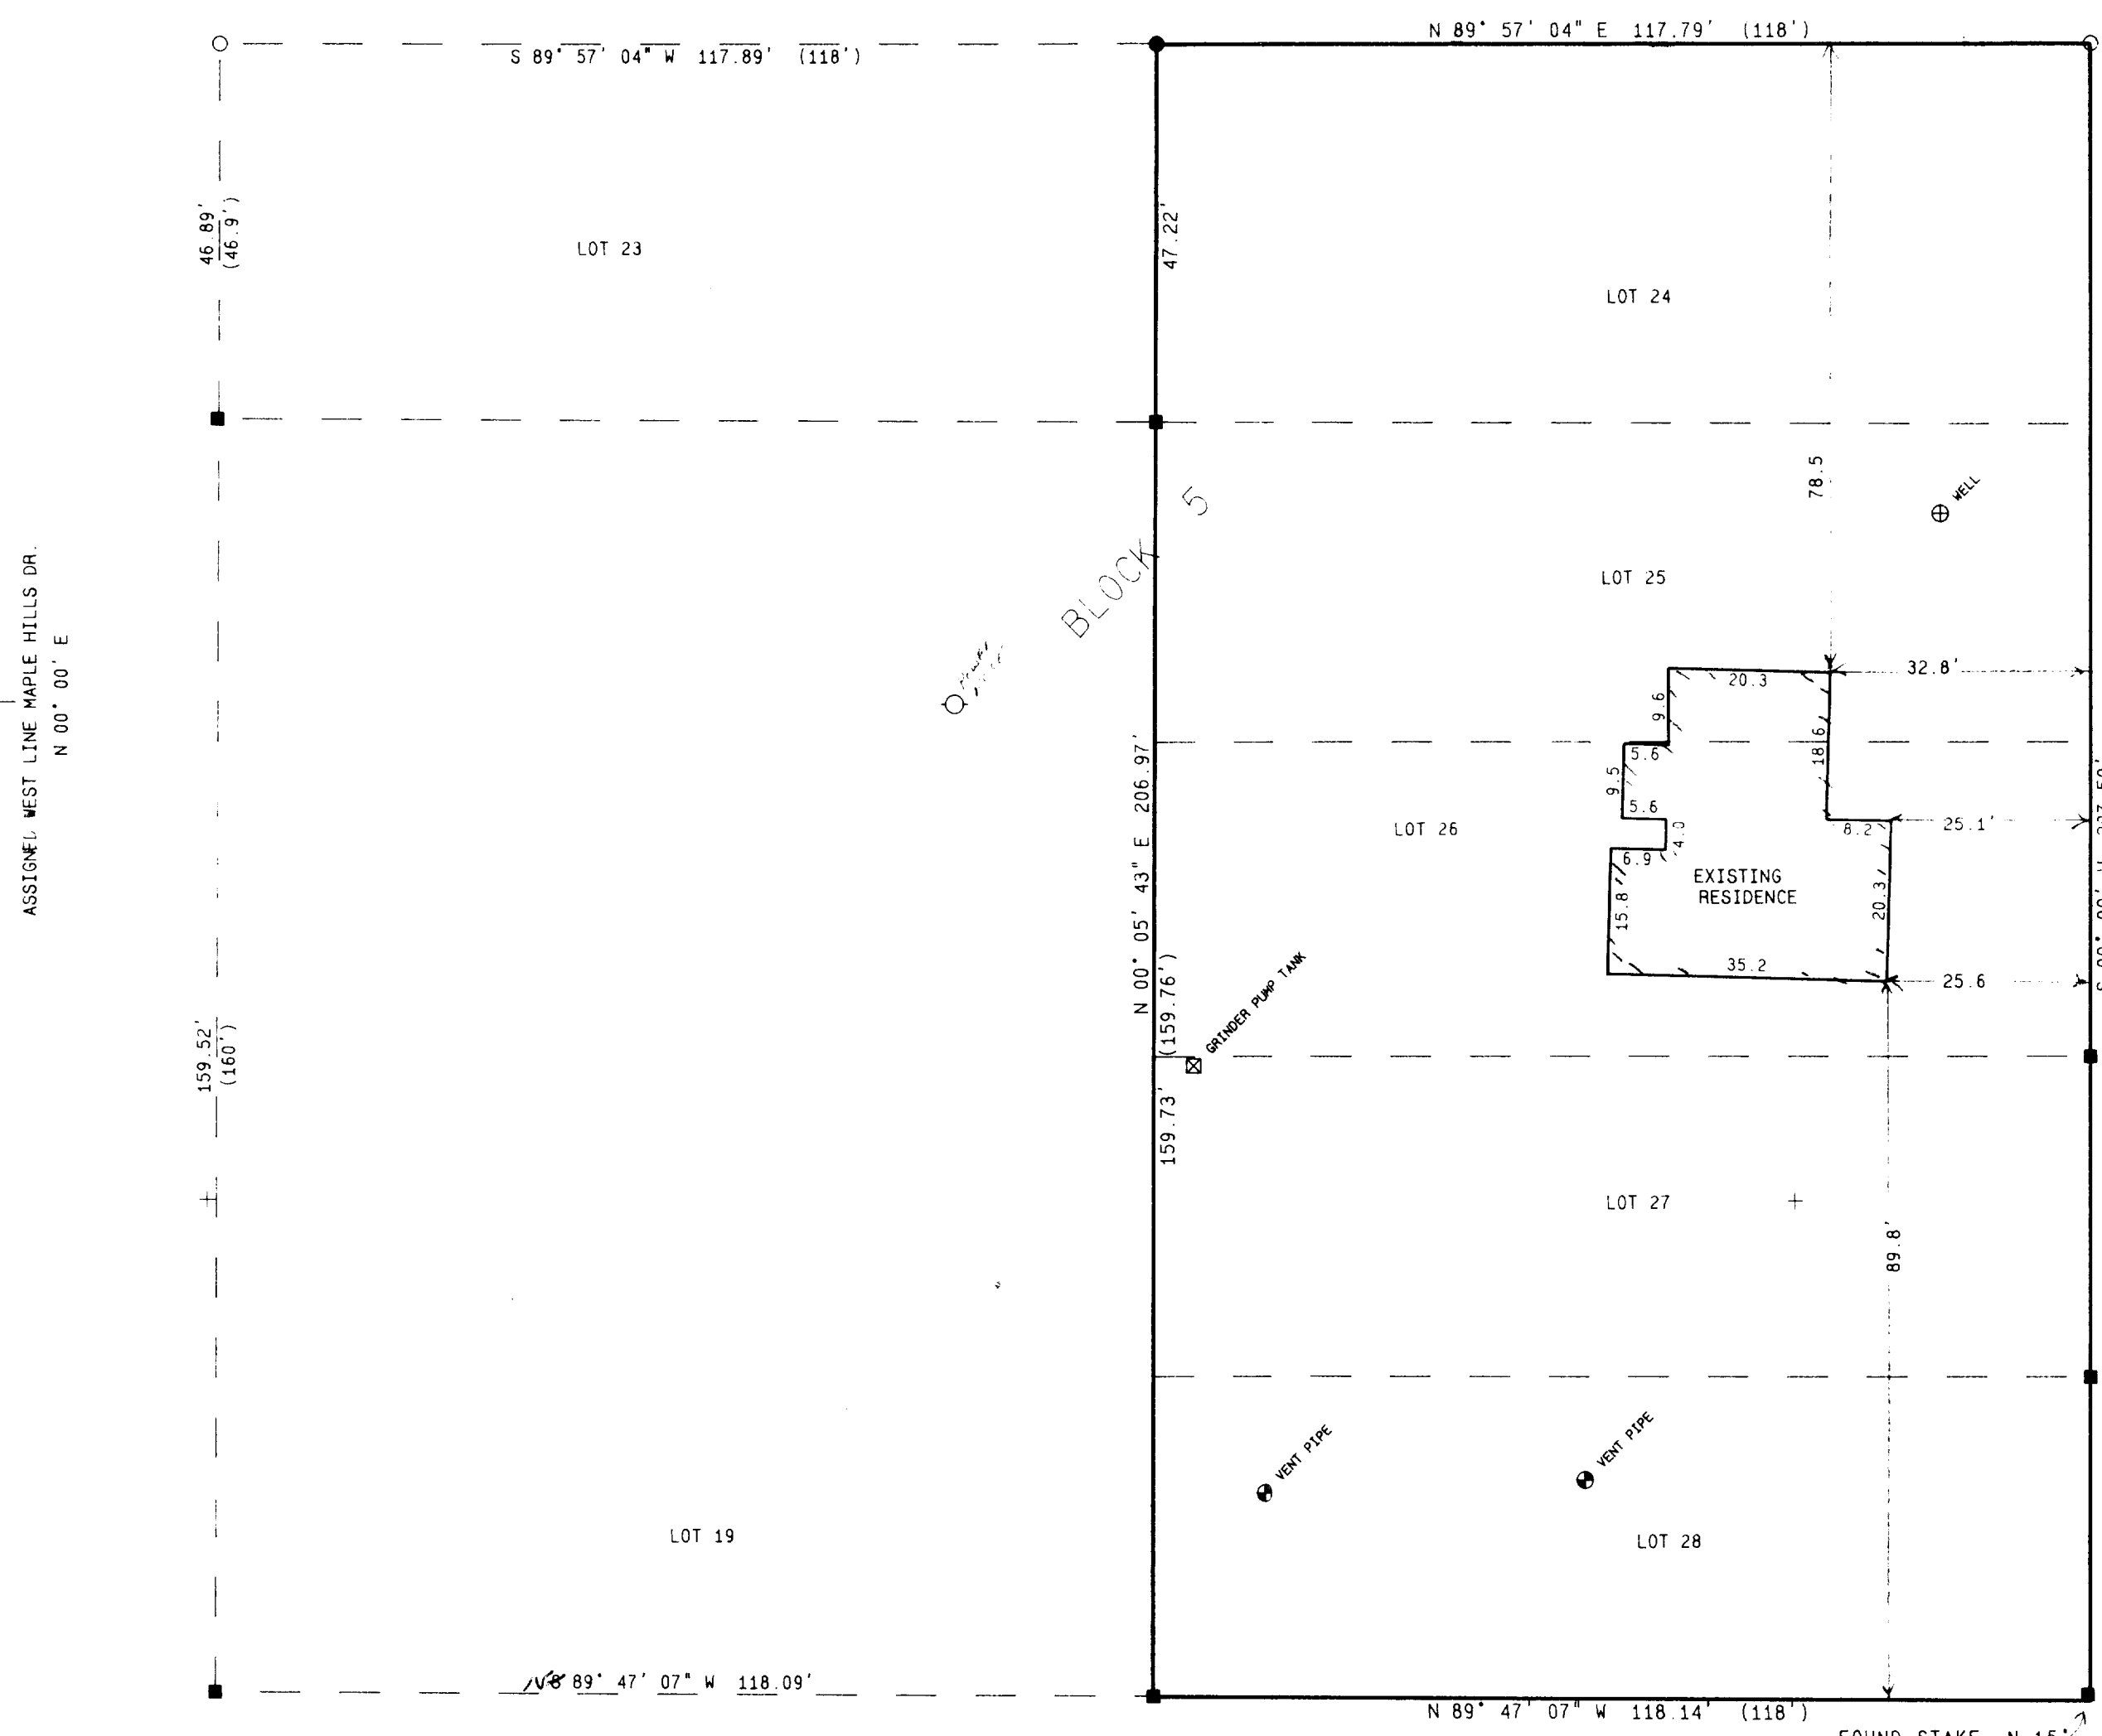


- = FOUND IRON PIPE STAKE
- = FOUND SQUARE IRON REBAR STAKE
- = SET ROUND IRON REBAR STAKE
- x x x = RECORDED AS

NOTE: COPIES OF THIS MAP TO WHICH THE FOLLOWING CERTIFICATE WILL APPLY ARE BLUE LINE PRINTS SHOWING SURVEYOR'S ORIGINAL SEAL AND SIGNATURE IN BLACK INK. COPIES BY ANY OTHER MEANS MAY HAVE ALTERATIONS WHICH DO NOT REPRESENT THE SURVEYOR'S WORK PRODUCT.

I HEREBY CERTIFY THAT THE ABOVE DESCRIBED PROPERTY HAS BEEN SURVEYED UNDER MY DIRECTION AND THAT THE ABOVE MAP IS A TRUE REPRESENTATION THEREOF AND SHOWS THE SIZE AND LOCATION OF THE PROPERTY AND ITS EXTERIOR BOUNDARIES. THIS SURVEY IS MADE FOR THE USE OF THE PRESENT OWNERS OF THE PROPERTY, AND ALSO THOSE WHO PURCHASE, MORTGAGE, OR GUARANTEE THE TITLE THERETO WITHIN ONE YEAR FROM THE DATE HEREOF.

DATED: 11-2-95

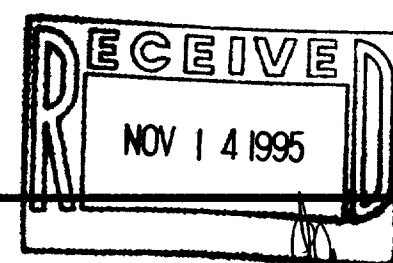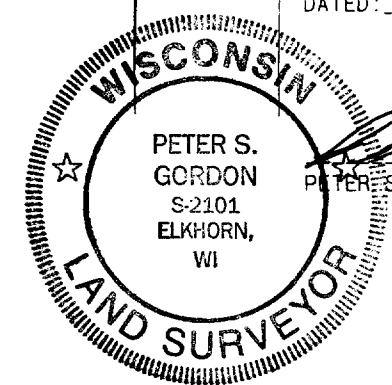

FOUND STAKE N 15° 48' W 0.79' FROM CORNER

IMH-116  
 IMH-118

117-1524