


VANDERSTAPPEN SURVEYING, INC.
217 W. Judd Street
Woodstock, Illinois 60098
(815) 337-8310

PLAT OF SURVEY

That part of the Northeast Quarter of the Southwest Quarter of Section 22, Township 1 North, Range 17, East of the Fourth Principal Meridian, being described as follows: Commencing at the Northeast corner of Lot 1 of Certified Survey Map, No. 2274, recorded February 9, 1993 as Document No. 252291, in Volume 11, page 98, by the Walworth County Register of Deeds; thence South 87 degrees 15 minutes 30 seconds West along the north line of said Lot 1, for a distance of 456.00 feet to the Northwest corner of said Lot 1; thence South 0 degrees 00 minutes 00 seconds West, 278.18 feet along the west line of said Lot 1, to the Southwest corner of said Lot 1; thence South 90 degrees 00 minutes 00 seconds West, 45.69 feet along the westerly extension of the south line of said Lot 1; thence North 0 degrees 00 minutes 00 seconds West, 341.99 feet; thence North 87 degrees 15 minutes 30 seconds East, 501.74 feet to the east line of said Lot 1 extended North; thence South 0 degrees 00 minutes 00 seconds East along said extension, 66.0 feet to the place of beginning, (excepting therefrom the east 33.00 feet) in Walworth County, Wisconsin. CONTAINING 1.00 ACRES OF LAND MORE OR LESS.

NORTH LINE OF THE SW 1/4 OF SECTION 22-1-17


FOUND MONUMENT AT
NE CORNER OF THE
SW 1/4 SECTION 22

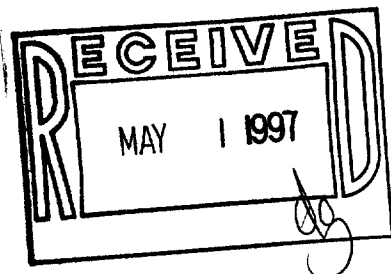

EAST LINE OF THE SW 1/4 OF SECTION 22-1-17

BRINK ROAD

EXCEPTION

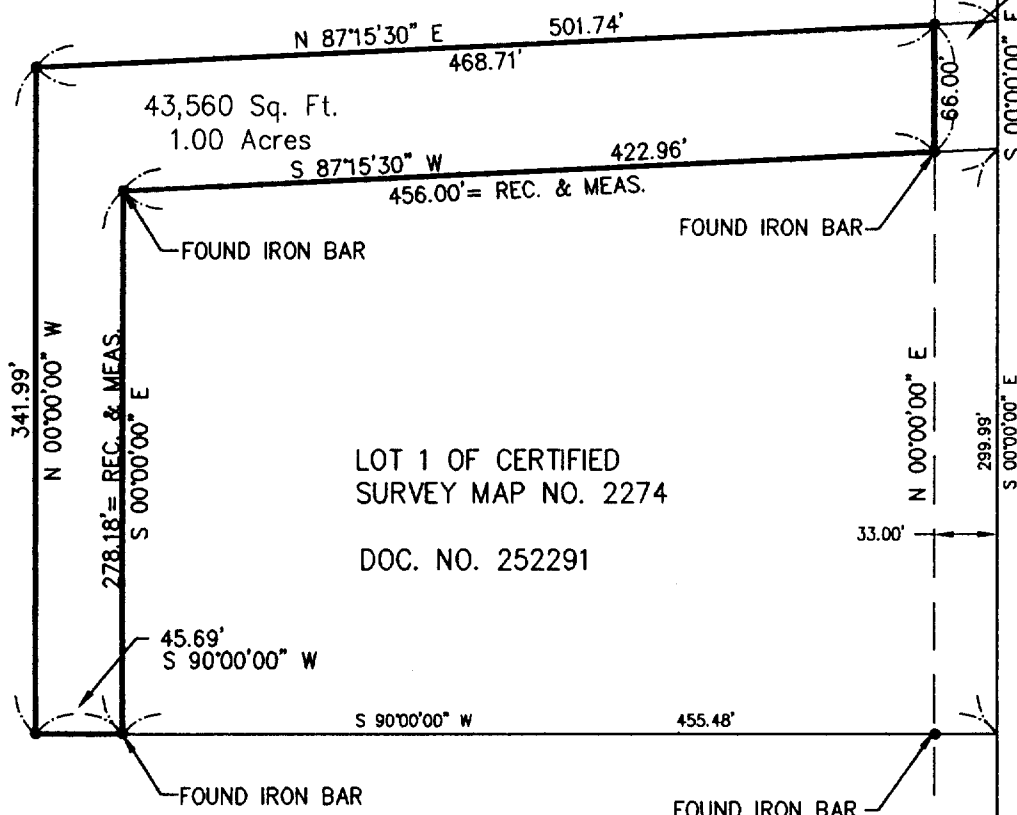

LOT 1 OF CERTIFIED
SURVEY MAP NO. 2274

DOC. NO. 252291

STATE OF ILLINOIS)
COUNTY OF McHENRY)

I hereby certify that we have surveyed the
premises above described, and that the plat
hereon is a true representation of said survey.

Dated at Woodstock,
McHenry County, Illinois DEC. 12 A.D., 19 96
VANDERSTAPPEN SURVEYING, INC.

By: *Wm. J. Vanderstappen*
Wisconsin Registered Land Surveyor
No. 1777

NOTE: Only those Building Line Restrictions or
Easements shown on a Recorded Subdivision Plat
are shown hereon unless the description ordered
to be surveyed contains a proper description of
the required building lines or easements.

Compare your description and site markings with
this plat and AT ONCE report any discrepancies
which you may find.

CLIENT: STEVE SNUDDEN
DRAWN BY: FWZ CHK'D BY: WJV
SCALE: 1"=100' SEC. 22 T. 1 R. 17E.
JOB NO.: 960736E FLD. BK. PAGE 41

ALL DISTANCES SHOWN IN FEET AND DECIMAL PARTS THEREOF
CORRECTED TO 68° F.

+ Part of
1L-22-7

117-1652