

PLAT OF SURVEY

PATHFINDER SURVEYING
 FORMERLY KOLB LAND CONSULTING
 929 WILLIAMS ST. LAKE GENEVA, WI.
 (414) 248-3897

ORDERED BY : AL BETKER
 P.O. BOX 925
 DELAVAN, WI. 53115


DATE: 9/19/1997

LEGEND

- FOUND IRON PIPE
- SET 1 IN. IRON PIPE
- X - FENCE



SCALE 1" = 20'

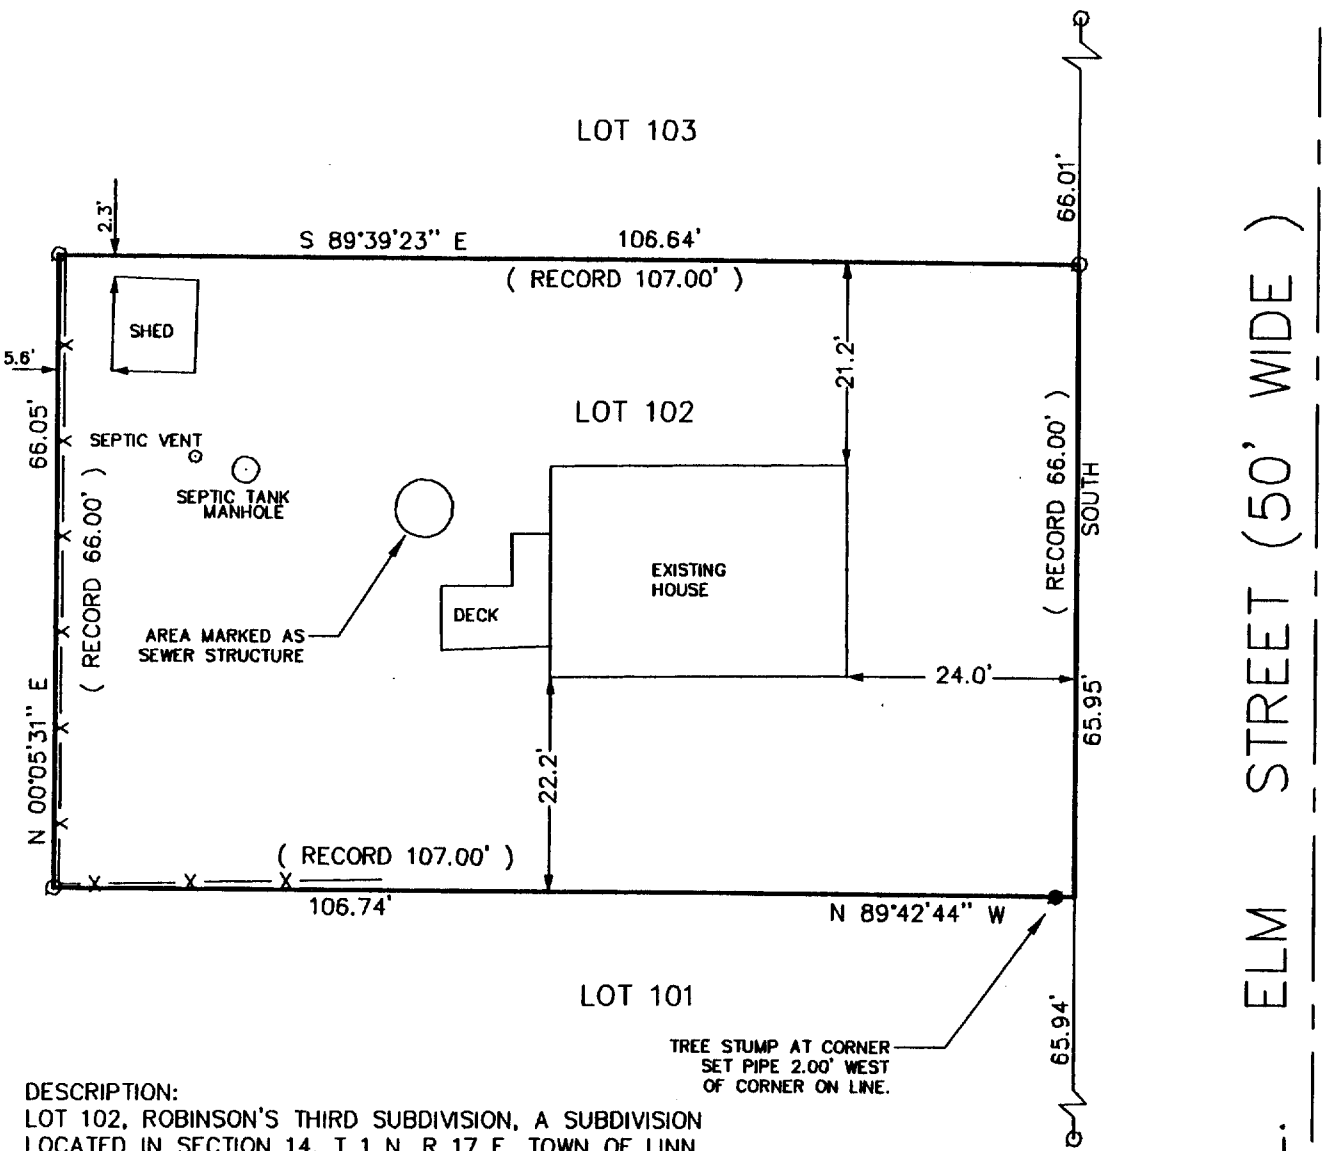

DESCRIPTION:



LOT 102, ROBINSON'S THIRD SUBDIVISION, A SUBDIVISION LOCATED IN SECTION 14, T 1 N, R 17 E, TOWN OF LINN WALWORTH COUNTY, WISCONSIN.

NOTE: NO BEARINGS ON SURVEYS OF RECORD CENTER LINE OF ELM STREET TAKEN TO BE NORTH.

THE ABOVE MAP IS A TRUE REPRESENTATION THEREOF AND SHOWS THE SIZE AND LOCATION OF ALL THE PROPERTY, EXTERIOR BOUNDARIES, THE LOCATION OF ALL VISIBLE BOUNDARY FENCES, APPARENT EASEMENTS, ROADWAYS AND VISIBLE ENCROACHMENTS, IF ANY.

THIS SURVEY IS MADE FOR THE USE OF THE PRESENT OWNERS OF THE PROPERTY, AND ALSO THOSE WHO PURCHASE, MORTGAGE OR GUARANTEE TITLE THERETO WITHIN ONE (1) YEAR FROM DATE HERETO.

John P. Krott
 JOHN P. KROTT, R.L.S. 2258

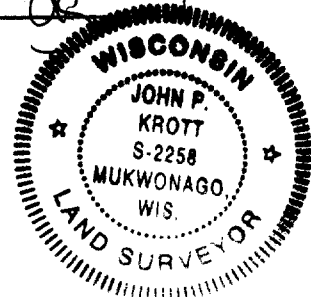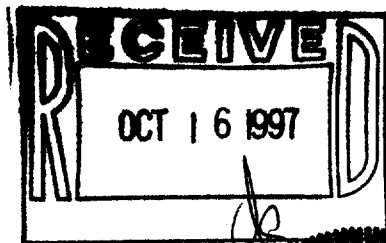

NOTE: THIS IS NOT A CERTIFIED COPY UNLESS SEAL IS IN RED. JOB NUMBER 97076/1-17-IRB3-80

IRB3-80