


DESCRIPTION:

Lot 112 of Lake Geneva Beach Subdivision, a subdivision of a portion of the southwest $\frac{1}{4}$ of Section 11, Township 1 north, Range 17 east of the 4th P. M.

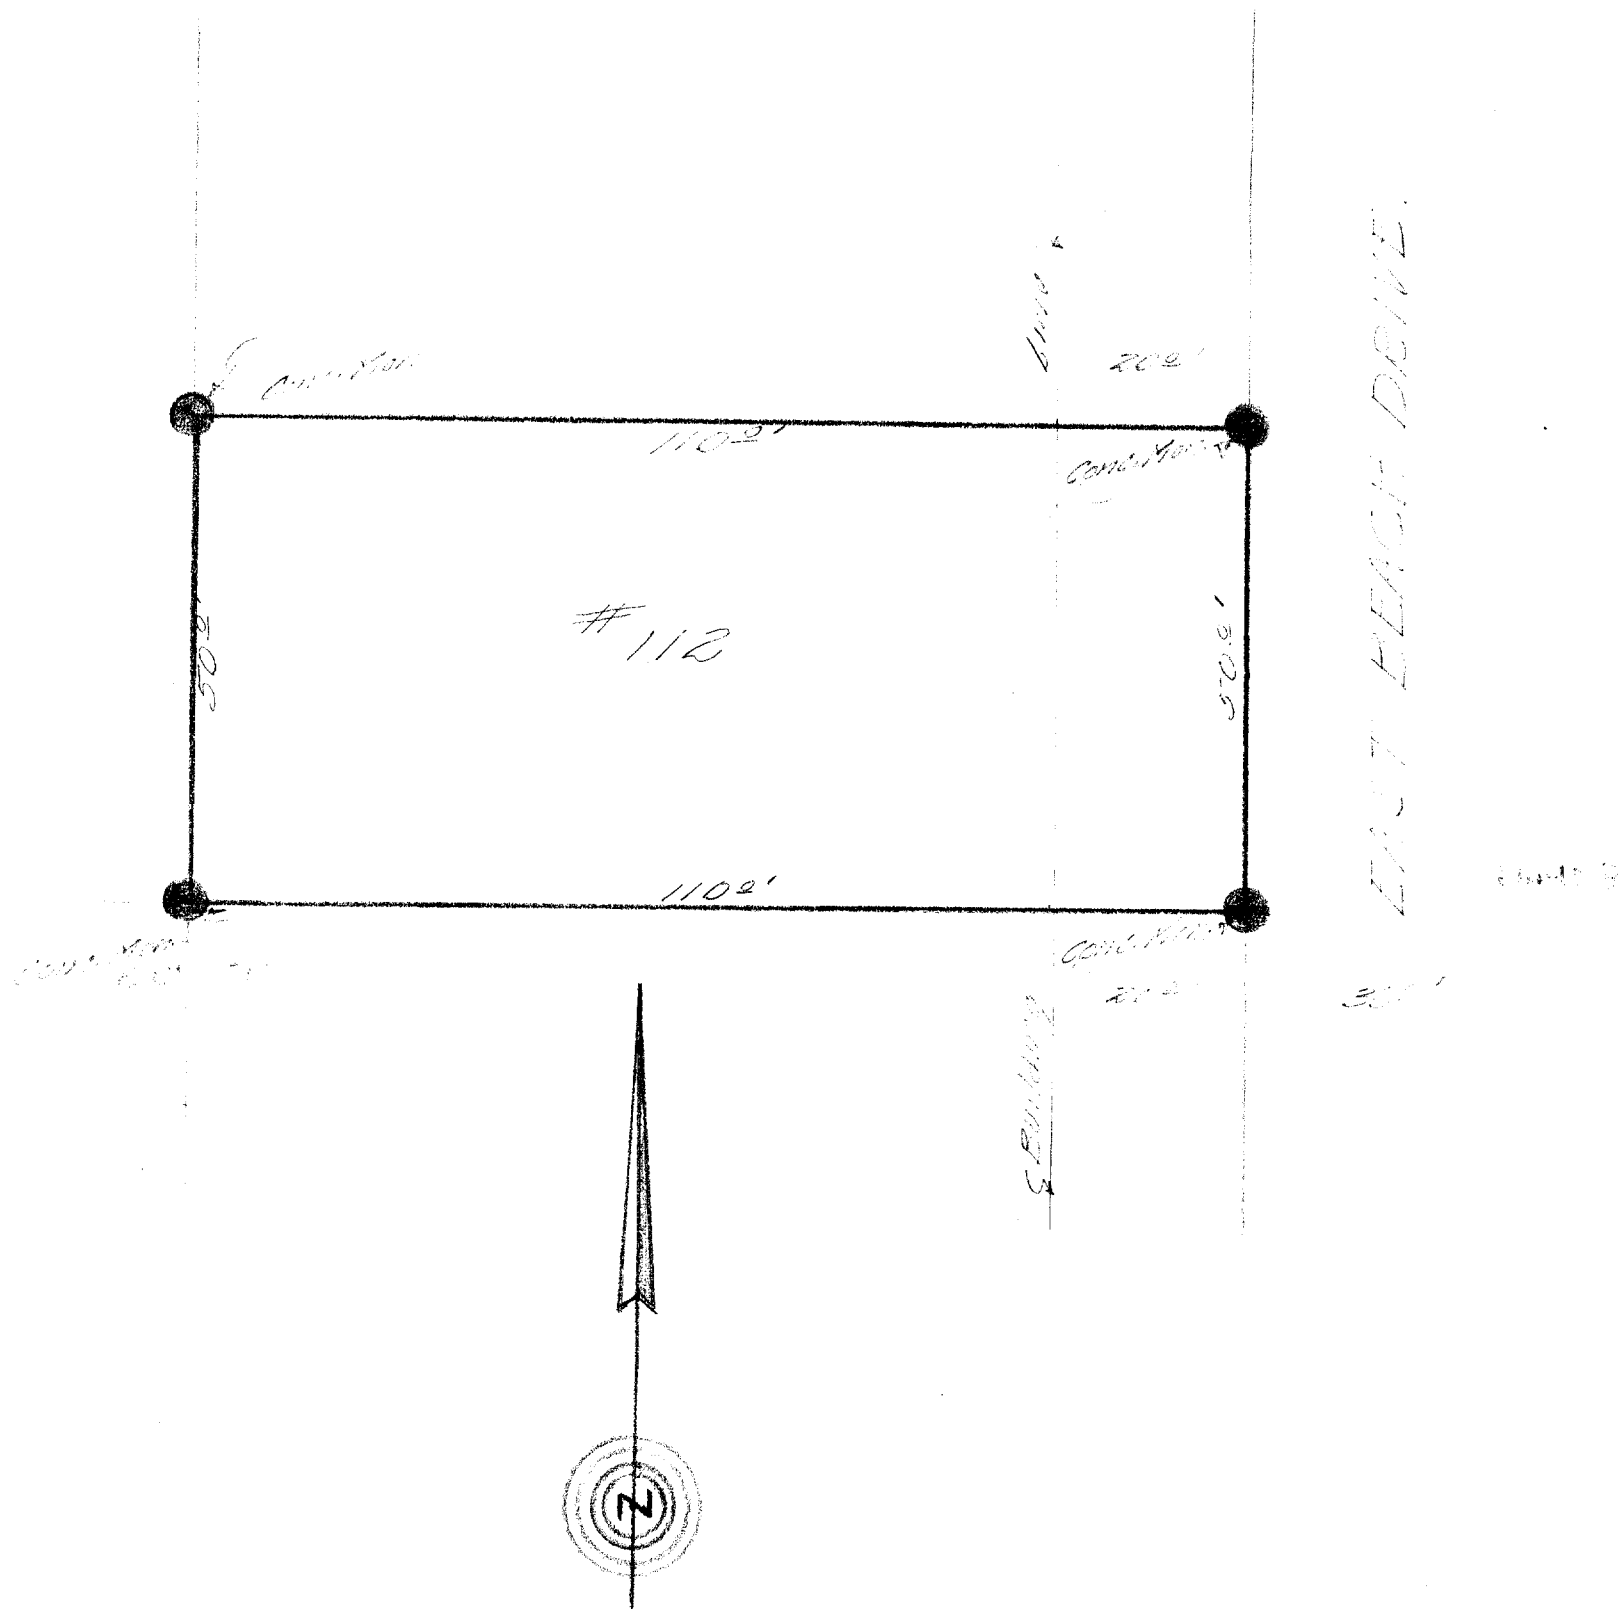

CERTIFICATE:

I, hereby certify that I have on this the 20th day of November 1944, surveyed the above described property according to the official records on file in the office of the Recorder of Deeds in and for Walworth County , Wisconsin, and find that no encroachments exist and that the survey is coincident with the recorded plat of said lot.

SIGNED AND SEALED THIS 23rd DAY OF NOVEMBER, 1944.

Joseph M. Biagi
Professional Engineer
Elkhorn Wisconsin.