

FARRIS, HANSEN, & ASSOCIATES, INC.

ENGINEERING, ARCHITECTURE, SURVEYING

7 RIDGWAY COURT - P.O. BOX 437, ELKHORN, WISCONSIN, 53121



PHONE: (414) 723-2098 FAX: (414) 723-5886

PLAT OF SURVEY

LOTS 1 & 2 OF CERTIFIED SURVEY MAP NO. 1260

LOCATED IN THE NW 1/4 OF SECTION 5, TOWN 1 NORTH,
RANGE 17 EAST, WALWORTH COUNTY, WISCONSIN

WORK ORDERED BY: JOHN TRACY
THE TRACY GROUP
506 W. OLD N.W. HWY.
BARRINGTON, IL 60010

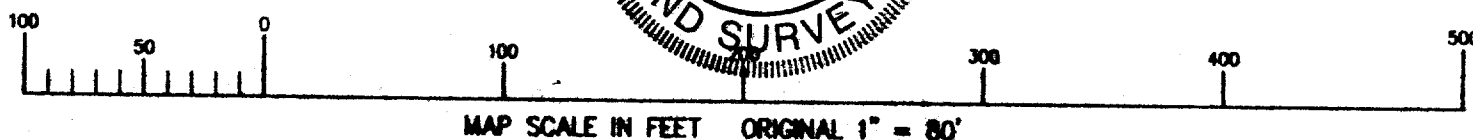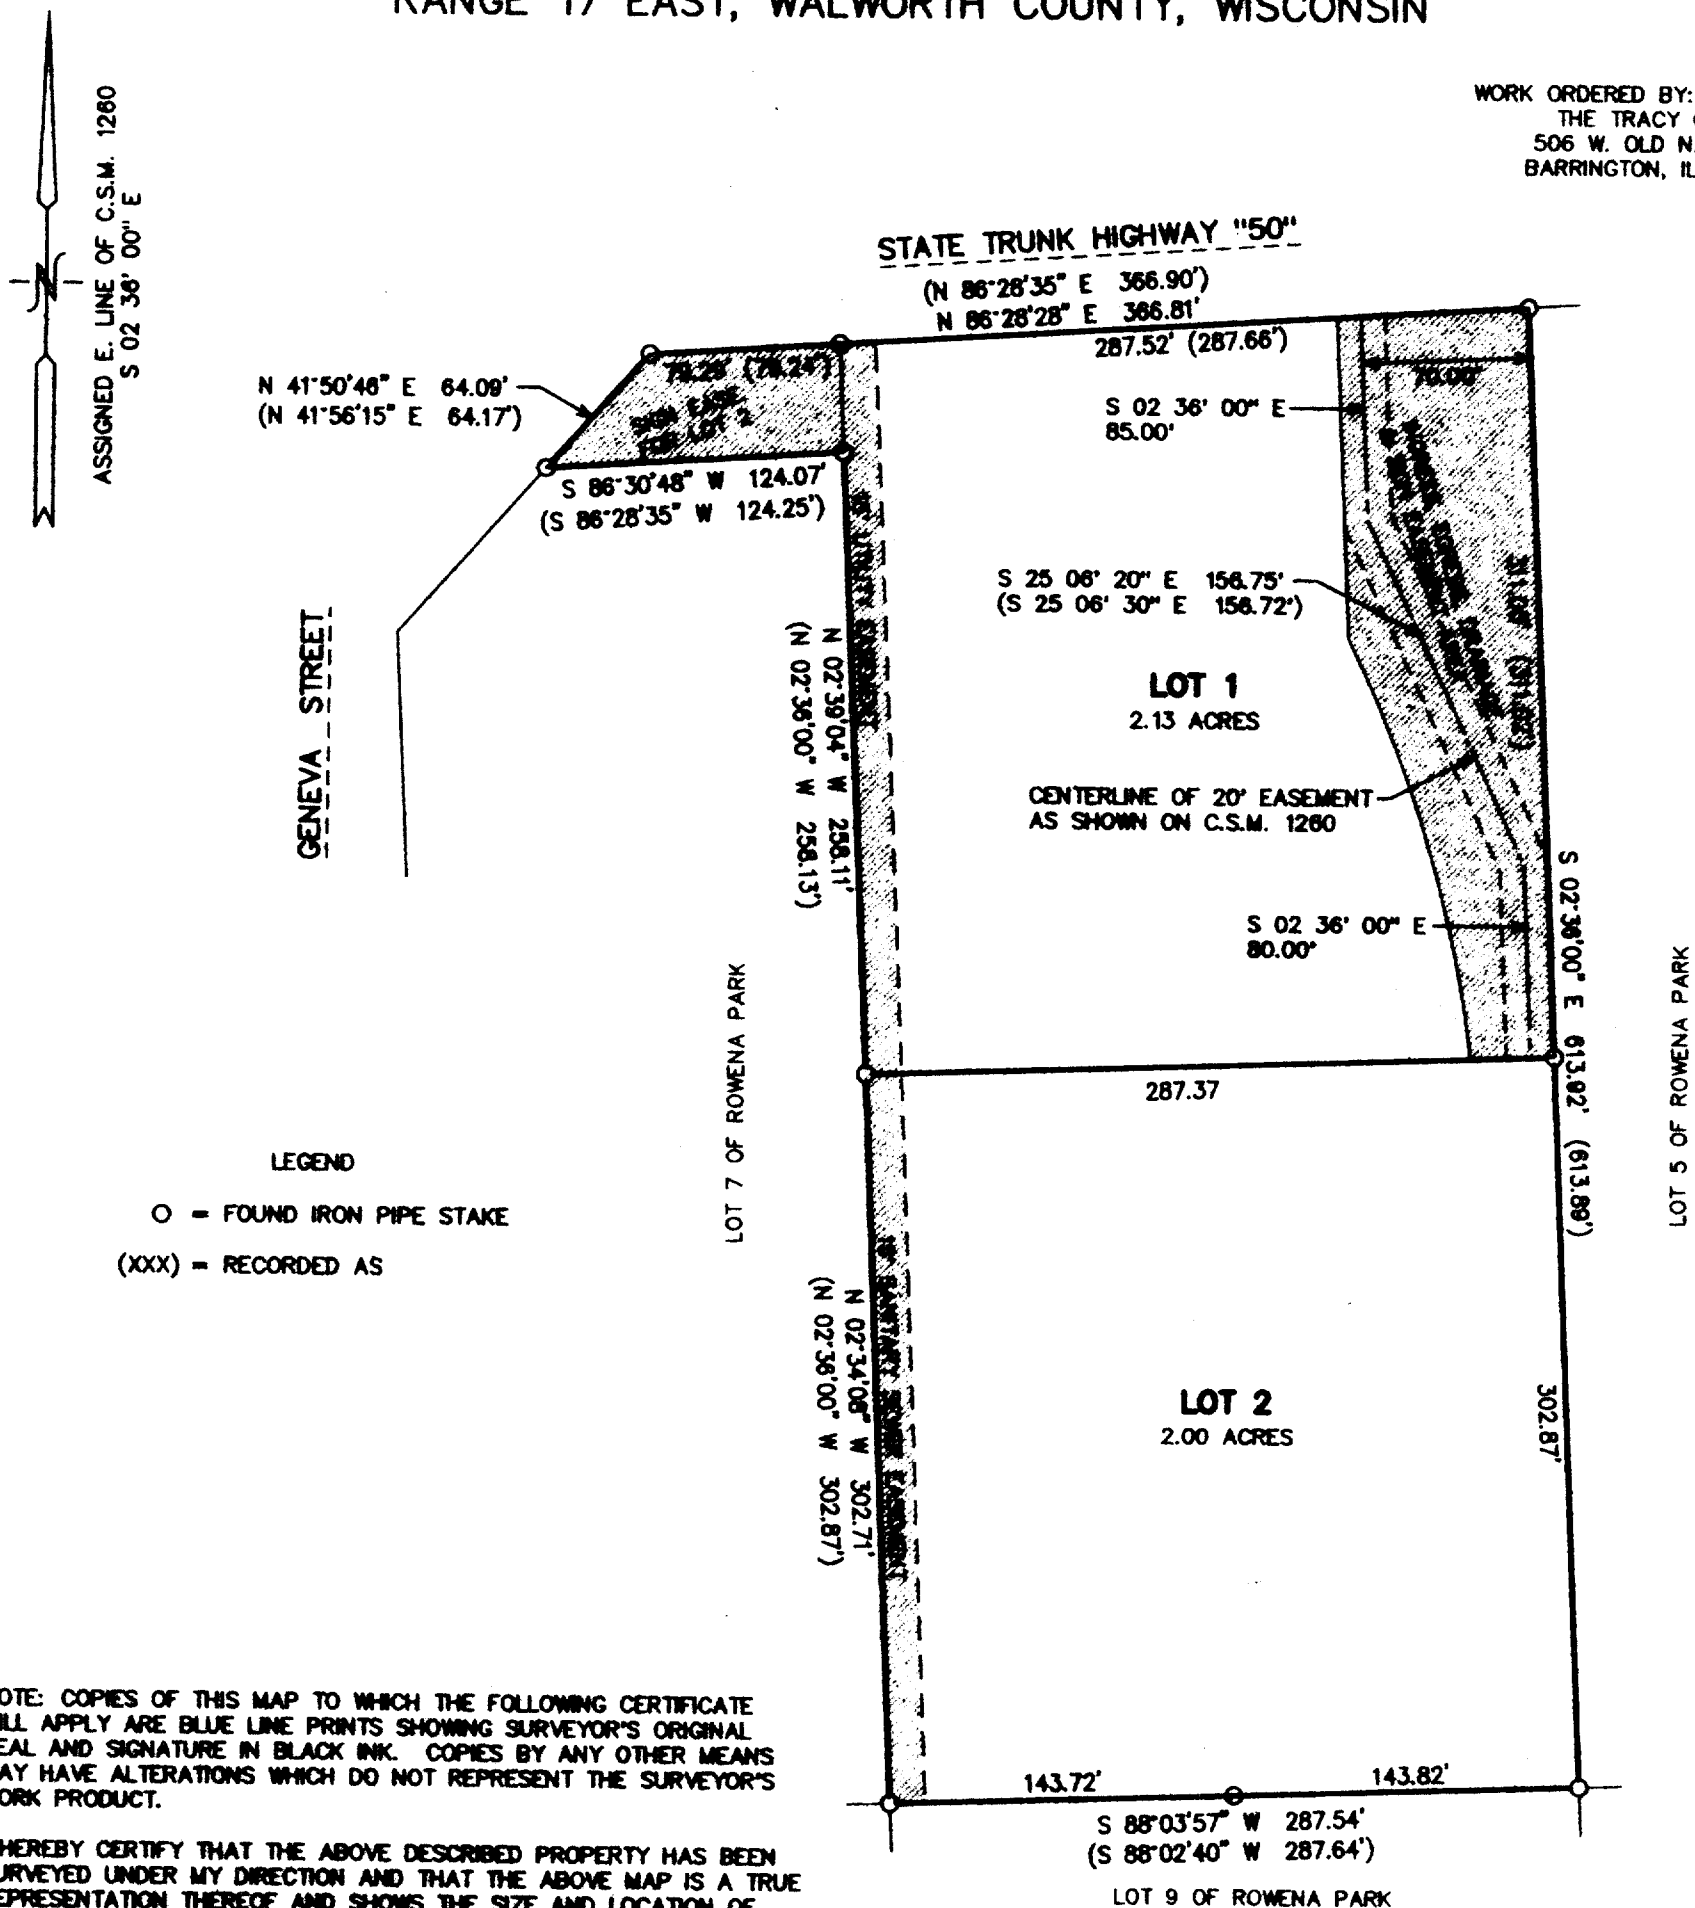

PROJECT 4963
DATE: 03/25/1998
SHEET 1 OF 1

IA-1260-1
IA-1260-2 117-1707